


ABELL
SURVEYING & MAPPING
DELAVER, WISCONSIN 53115
414-728-6737




BLOCK

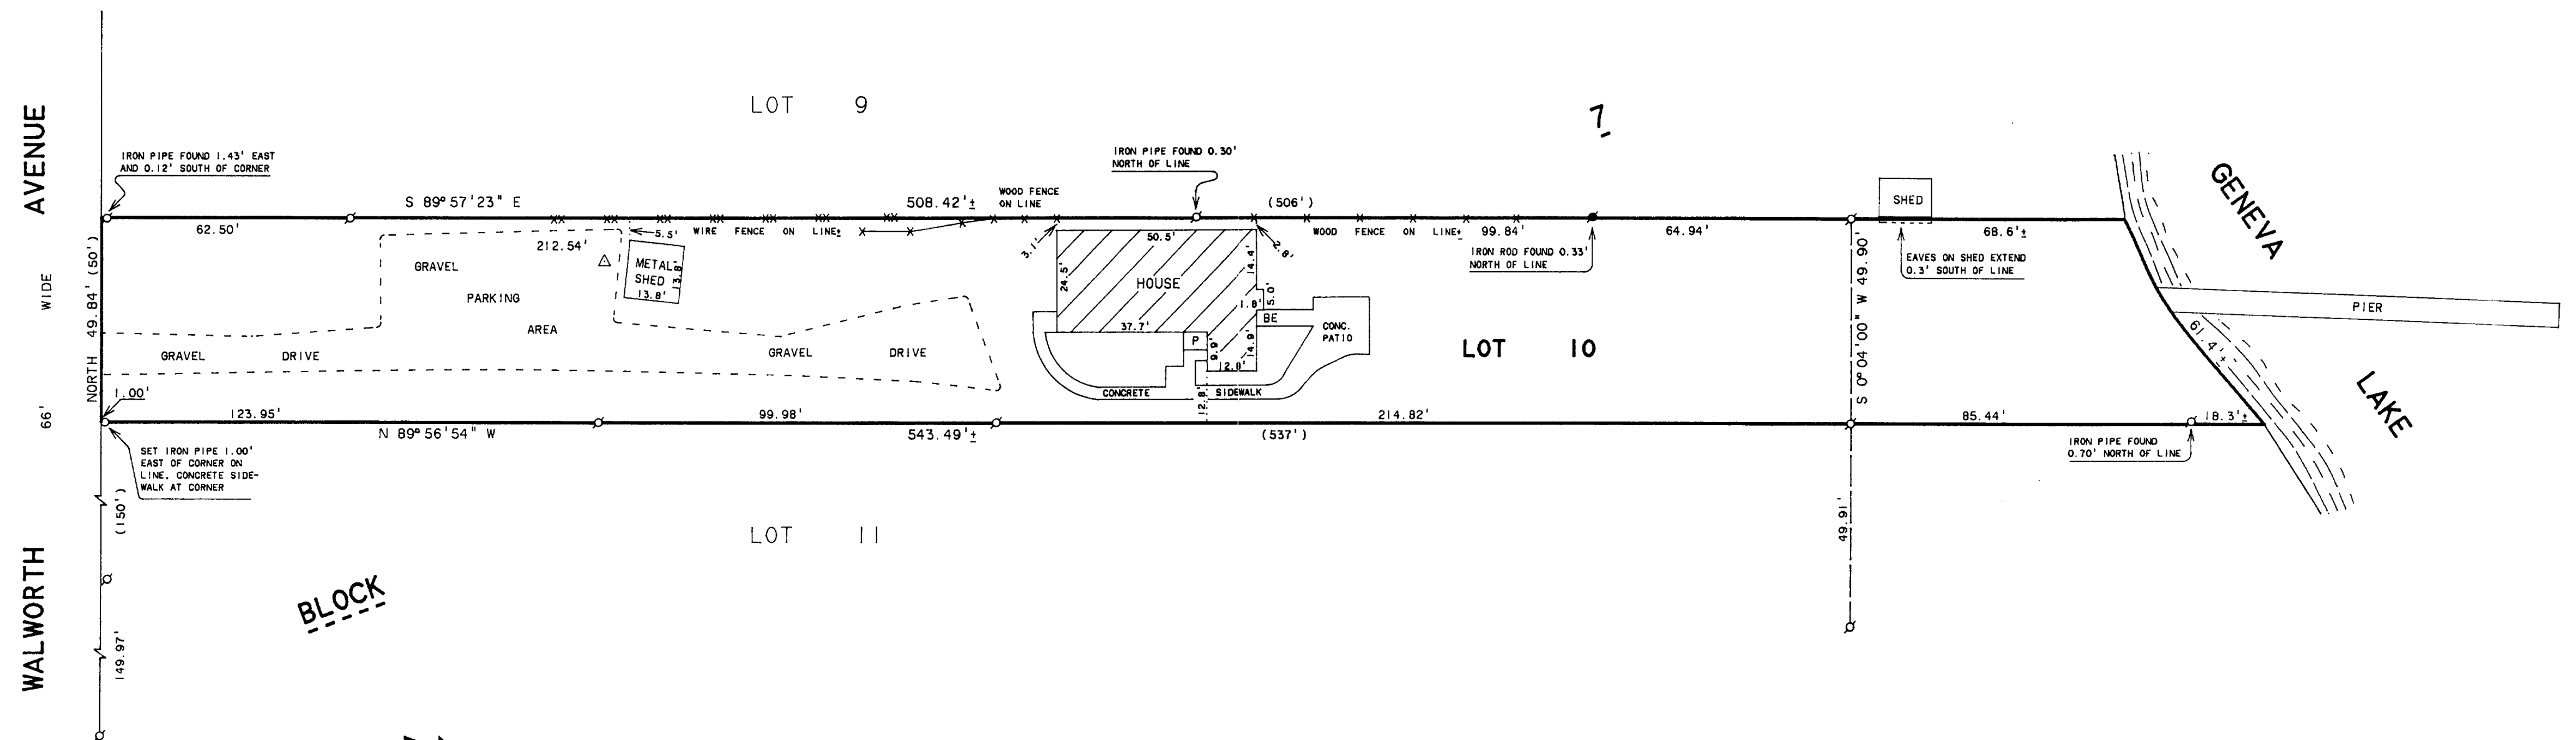

SCALE 1"=30'
LEGEND

PLAT OF SURVEY OF

LOT 10, BLOCK 7 OF THE ORIGINAL PLAT OF THE
VILLAGE OF WILLIAMS BAY, WALWORTH COUNTY,
WISCONSIN.

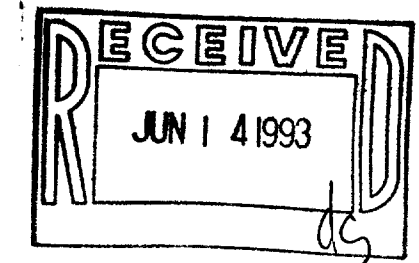

I HEREBY CERTIFY THAT I HAVE SURVEYED THE ABOVE DESCRIBED PROPERTY AND THAT THE ABOVE MAP IS A TRUE REPRESENTATION THEREOF AND SHOWS THE SIZE AND LOCATION OF THE PROPERTY, ITS EXTERIOR BOUNDARIES, THE LOCATION OF ALL VISIBLE STRUCTURES AND DIMENSIONS OF ALL PRINCIPAL BUILDINGS THEREON, BOUNDARY FENCES, APPARENT EASEMENTS, ROADWAYS AND VISIBLE ENCROACHMENTS, IF ANY, TO THE BEST OF MY KNOWLEDGE AND BELIEF.

THIS SURVEY IS MADE FOR THE USE OF THE PRESENT OWNERS OF THE PROPERTY, AND ALSO THOSE WHO PURCHASE, MORTGAGE, OR GUARANTEE THE TITLE THERETO WITHIN ONE (1) YEAR FROM DATE HEREON.

David F. Abell

DAVID F. ABELL
WISCONSIN REGISTERED LAND SURVEYOR, S-1596

September 14, 1992

DATE: September 14, 1992 JOB NUMBER: 92144
NOTE: THIS IS NOT A CERTIFIED COPY UNLESS SEALED.

WOP-93

011-992