


**ABELL
SURVEYING & MAPPING
DELAVER, WISCONSIN 53115
414-728-8737**

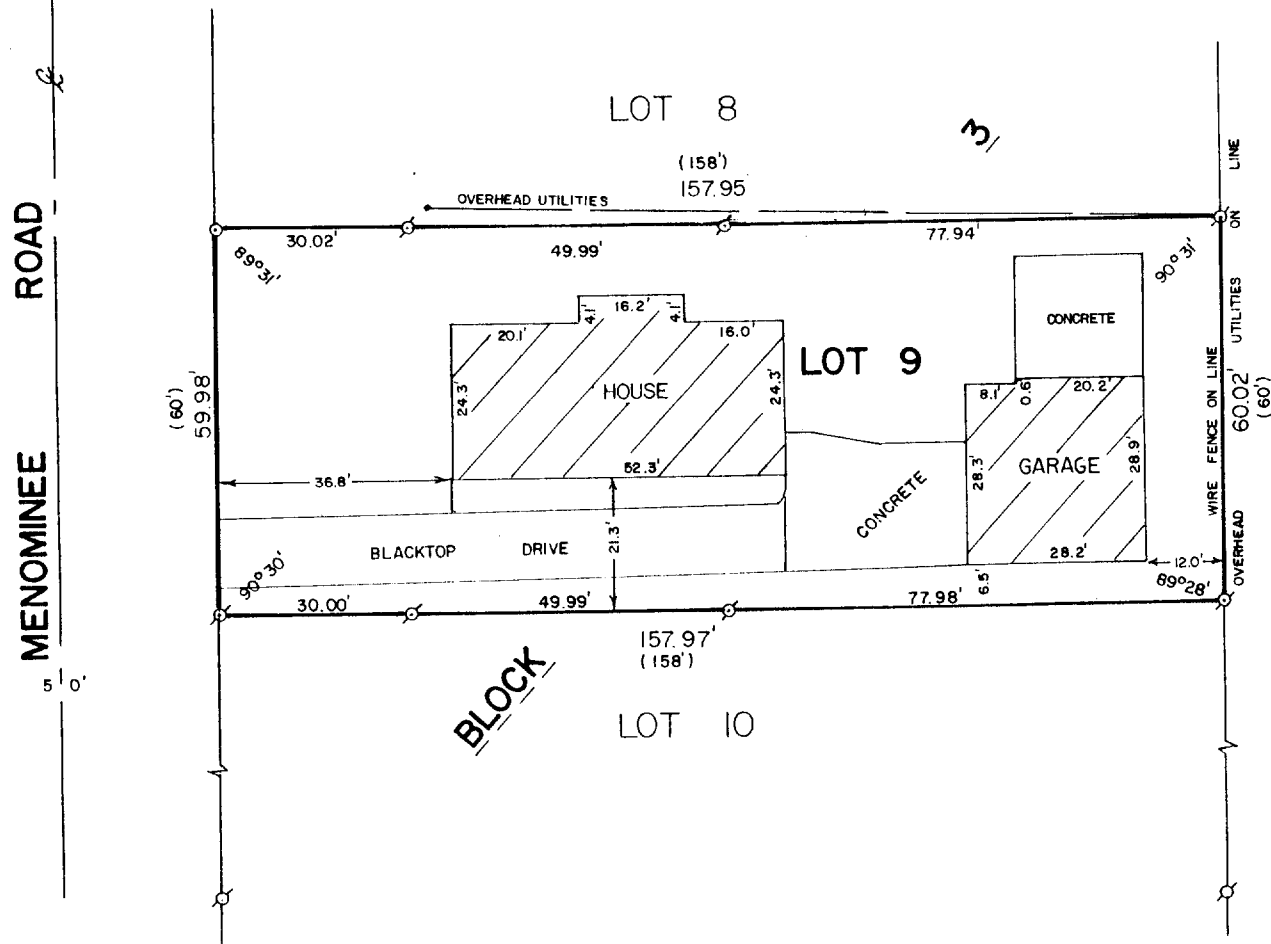

PLAT OF SURVEY OF

LOT 9, BLOCK 3 OF HARBOR VIEW SUBDIVISION, LOCATED IN
THE VILLAGE OF WILLIAMS BAY, WALWORTH COUNTY, WISCONSIN.

ORDERED BY: DONNA KUCHARSKI
704½ W. McKINLEY
HARVARD, IL 60033



SCALE - 1"=30'

LEGEND

- ⊗ - IRON PIPE FOUND
- - SPIKE FOUND, SET
IRON ROD, FOUND 5/17/93
- x— WOOD FENCE
- () - RECORDED AS

I HEREBY CERTIFY THAT I HAVE SURVEYED THE ABOVE DESCRIBED PROPERTY AND THAT THE ABOVE MAP IS A TRUE REPRESENTATION THEREOF AND SHOWS THE SIZE AND LOCATION OF THE PROPERTY, ITS EXTERIOR BOUNDARIES, THE LOCATION OF ALL VISIBLE STRUCTURES AND DIMENSIONS OF ALL PRINCIPAL BUILDINGS THEREON, BOUNDARY FENCES, APPARENT EASEMENTS, ROADWAYS AND VISIBLE ENCROACHMENTS, IF ANY, TO THE BEST OF MY KNOWLEDGE AND BELIEF.

THIS SURVEY IS MADE FOR THE USE OF THE PRESENT OWNERS OF THE PROPERTY, AND ALSO THOSE WHO PURCHASE, MORTGAGE, OR GUARANTEE THE TITLE THEREIN WITHIN ONE (1) YEAR FROM DATE HEREOF.

David F. Abell

DAVID F. ABELL
WISCONSIN REGISTERED LAND SURVEYOR, S-1596

DATE *June 16, 1990*

REVISED: MAY 17, 1993

JOB NUMBER - 90115

NOTE: THIS IS NOT A CERTIFIED COPY UNLESS SEALED.

WHV-39A

011-996