


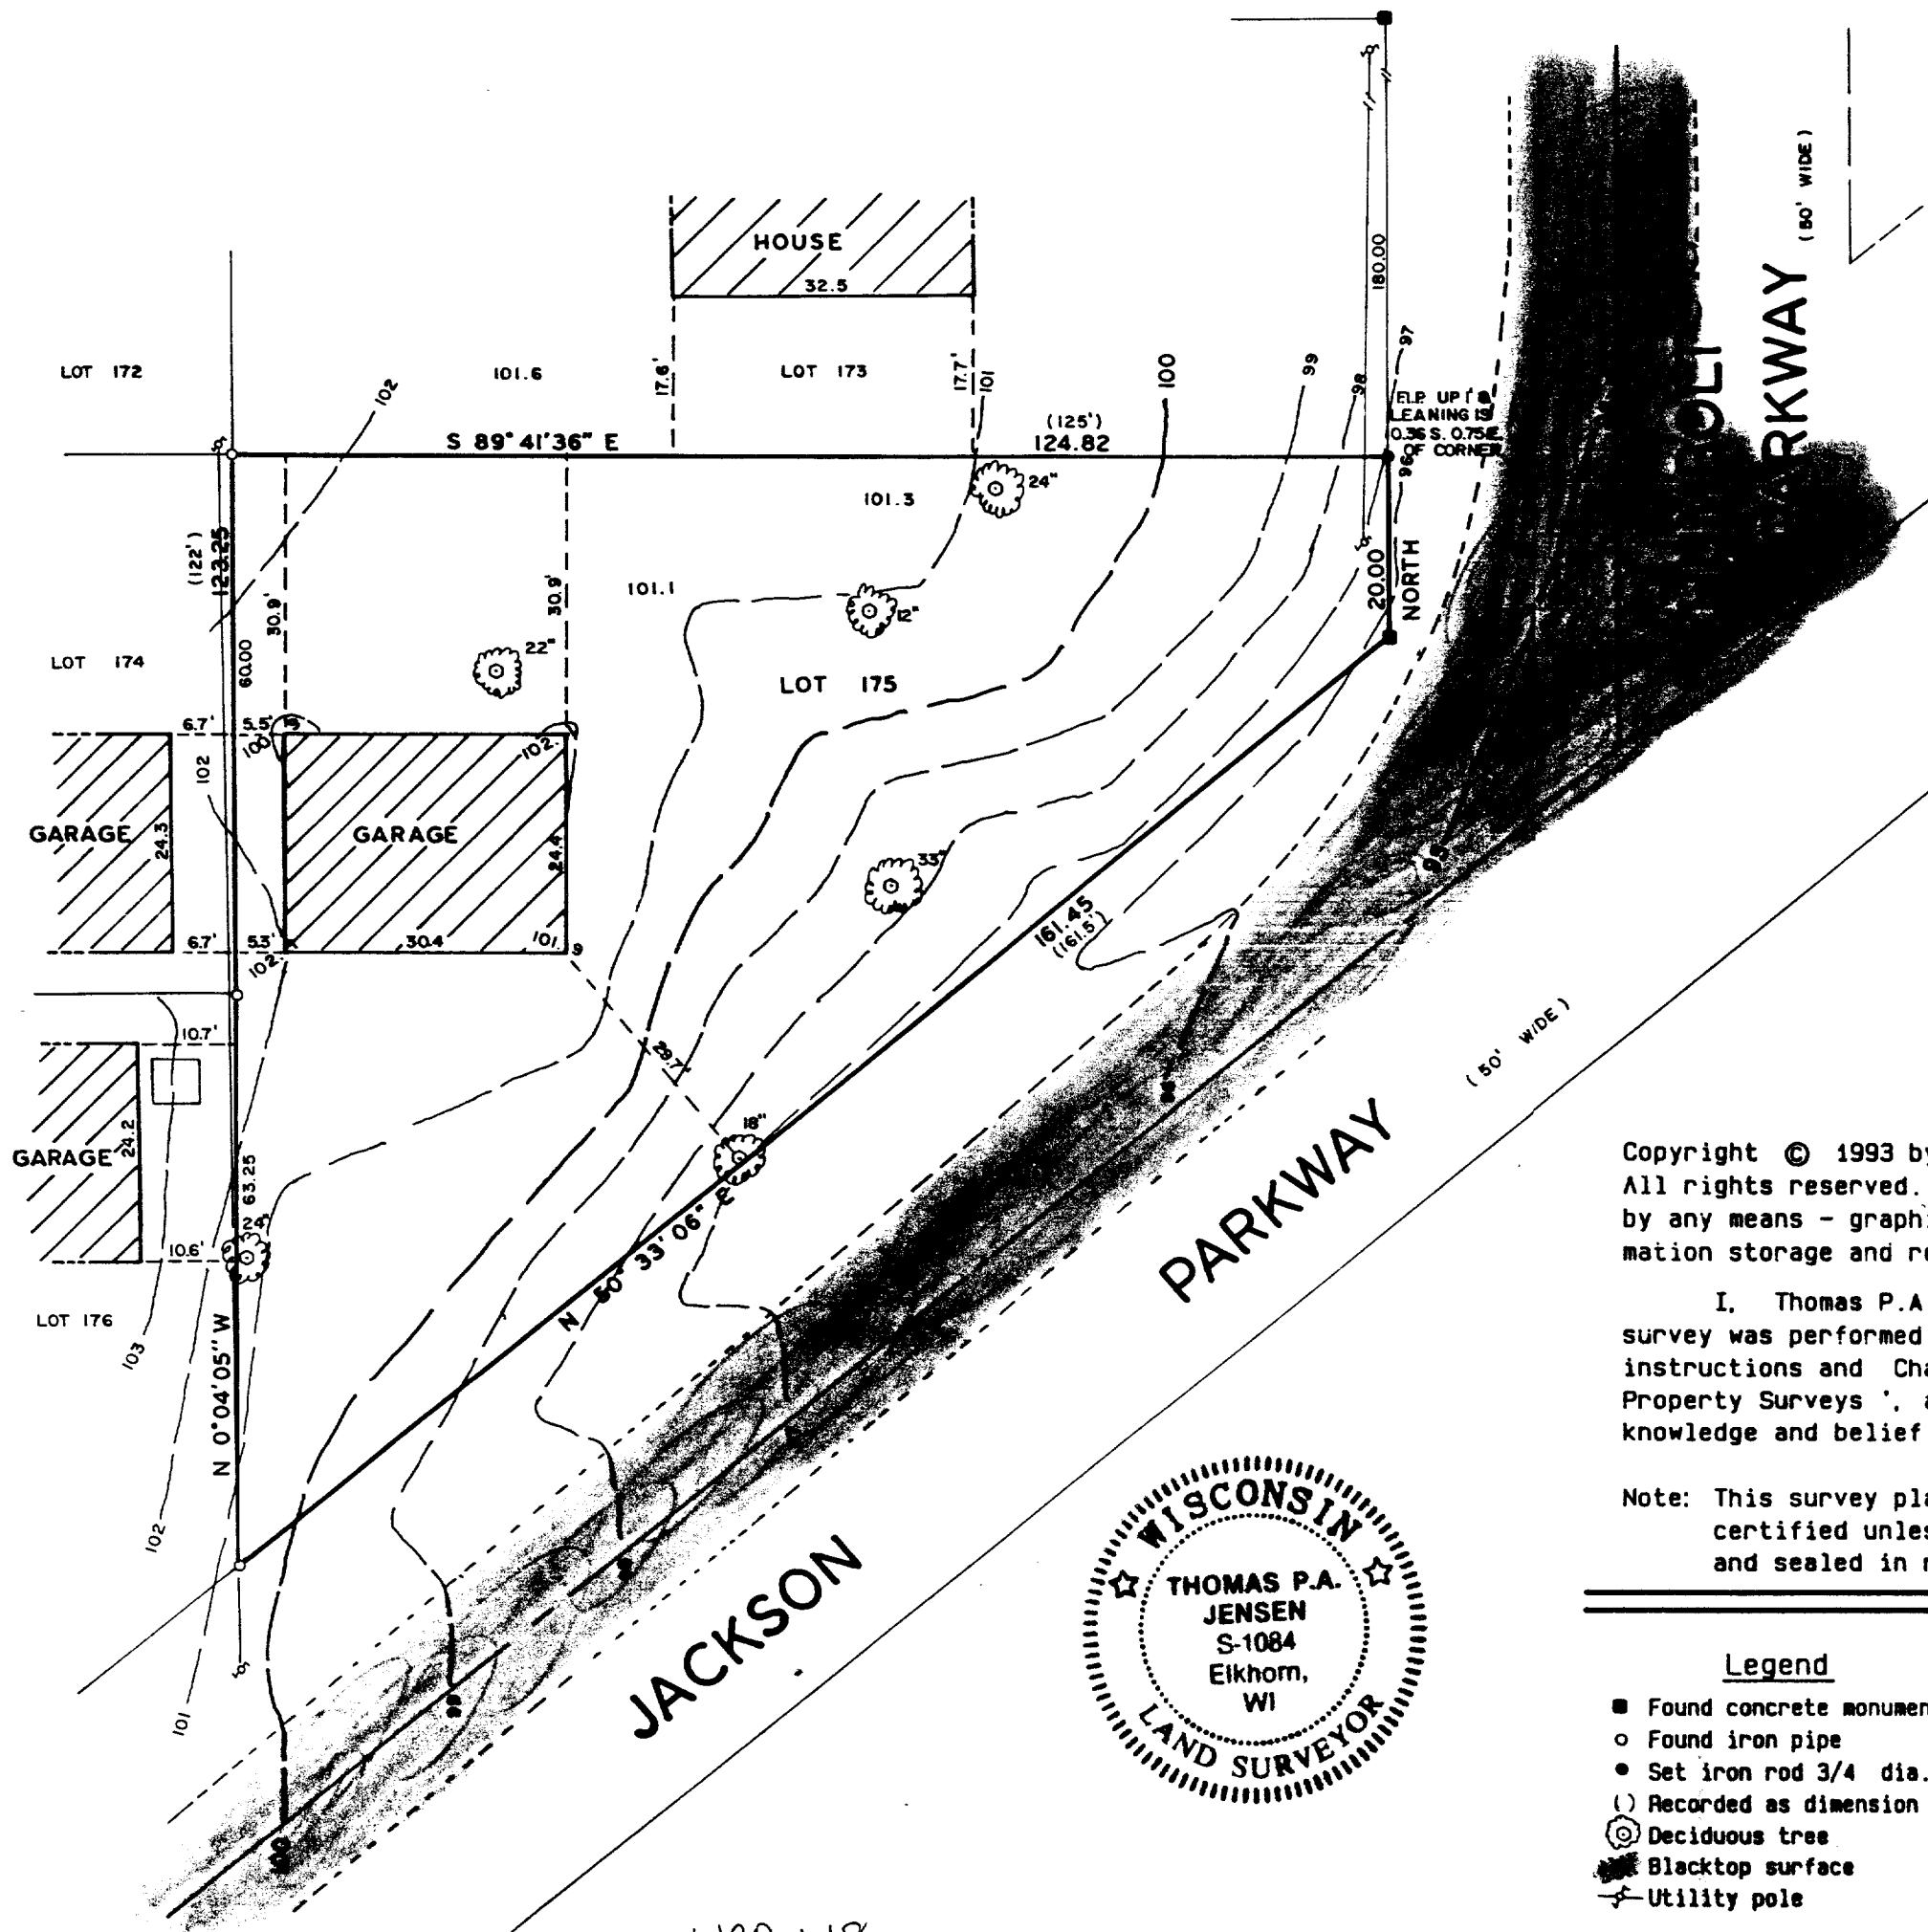


Plat of Survey of

Lot 175 of Cedar Point Park, a subdivision located in Section 6, Town 1 North, Range 17 East, Village of Williams Bay, Walworth County, Wisconsin

Surveyed for: Cedar Point Park Association
P.O. Box 490
Williams Bay, Wisconsin. 53191

Bearings are assumed.

ELEVATIONS ARE IN A LOCAL DATUM WITH ELEVATION 100.00 ASSUMED ON THE TOP OF THE PIPE MARKING THE SOUTHWEST CORNER OF LOT 175.

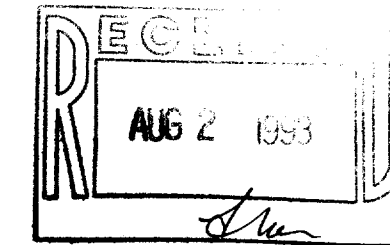

Copyright © 1993 by Jensen Surveying & Mapping S.C.
All rights reserved. No part of this survey plat may be reproduced or transmitted in any form by any means - graphic, electronic, or mechanical, including photocopying, tracing, or information storage and retrieval systems - without permission in writing from Thomas P.A. Jensen.

I, Thomas P.A. Jensen, Wisconsin Registered Land Surveyor, do hereby certify that this survey was performed by me, or under my direction, in full compliance with the owner's/agent's instructions and Chapter A-E 7 of the Wisconsin Administrative Code 'Minimum Standards For Property Surveys', and that this map is an accurate representation thereof to the best of my knowledge and belief.

Note: This survey plat is not certified unless signed and sealed in red ink.

Thomas P.A. Jensen
Thomas P.A. Jensen R.L.S. 1084

Legend

- Found concrete monument
- Found iron pipe
- Set iron rod 3/4 dia.
- () Recorded as dimension
- ⊙ Deciduous tree
- Blacktop surface
- ✱ Utility pole

Jensen Surveying & Mapping S.C.

45 South Wisconsin Street P.O. Box 322
Elkhorn, Wisconsin. 53121.
(414) 723-3434

Mapping date: March 26, 1993.

Revisions: _____

Scale: 1" = 20'



Sheet 1 of 1 Sheets

Job reference number:

1993.029

011-999

WCP-148