

SURVEYING & SUBDIVIDING  
DELAN, WISCONSIN 53115



(0.00) = recorded distance

Survey ordered by:  
Danielson & Osman Realty  
23 North Wisconsin Street  
Darien, WI 53114

—+—+—+ = Fence Line  
(0.00) = recorded distance

August 23, 1999 updating and revision  
ordered by:  
Jasine Huber  
W9458 County Road "X"  
Darien, WI 53114

Lots 4, 5, and 6 and the East  $\frac{1}{2}$  of Lot 7 all in Block 6 of Allen's Map of Allens Grove located in Section 6, T 1 N, R 15 E, Walworth County, Wisconsin, together with the north  $\frac{1}{2}$  of the Alley located immediately south of and adjacent to the above described lots in Block 6.


*George T. Dunham*  
George T. Dunham, Surveyor

RECEIVED  
MAY 9 2003  
000

PARCEL 1: West  $\frac{1}{2}$  of Lot 5, Lot 6, and the East  $\frac{1}{2}$  of Lot 7, all in Block 6 of Allen's Map of Allens Grove located in Section 6, T1N, R15E, Walworth County, Wisconsin, together with the north  $\frac{1}{2}$  of the Alley located immediately south of and adjacent to the above described lots in Block 6.

and that the plat shown hereon is a correct representation thereof and shows the size and location of the property, its exterior boundaries, the location of all visible structures and dimensions of all principal buildings thereon, boundary fences, apparent easements, roadways and visible encroachments, if any, and that I have surveyed the property hereon, described, according to the official records, to the best of my knowledge and belief.

*George T. Dunham*  
George T. Dunham, Survivor

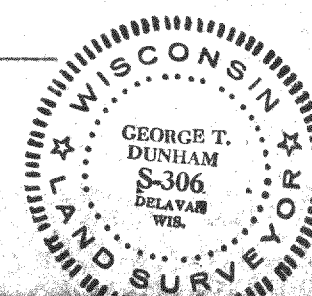

115-27-