


DUNHAM SURVEYING, S.C.
SURVEYING & SUBDIVIDING
DELAVER, WISCONSIN 53115

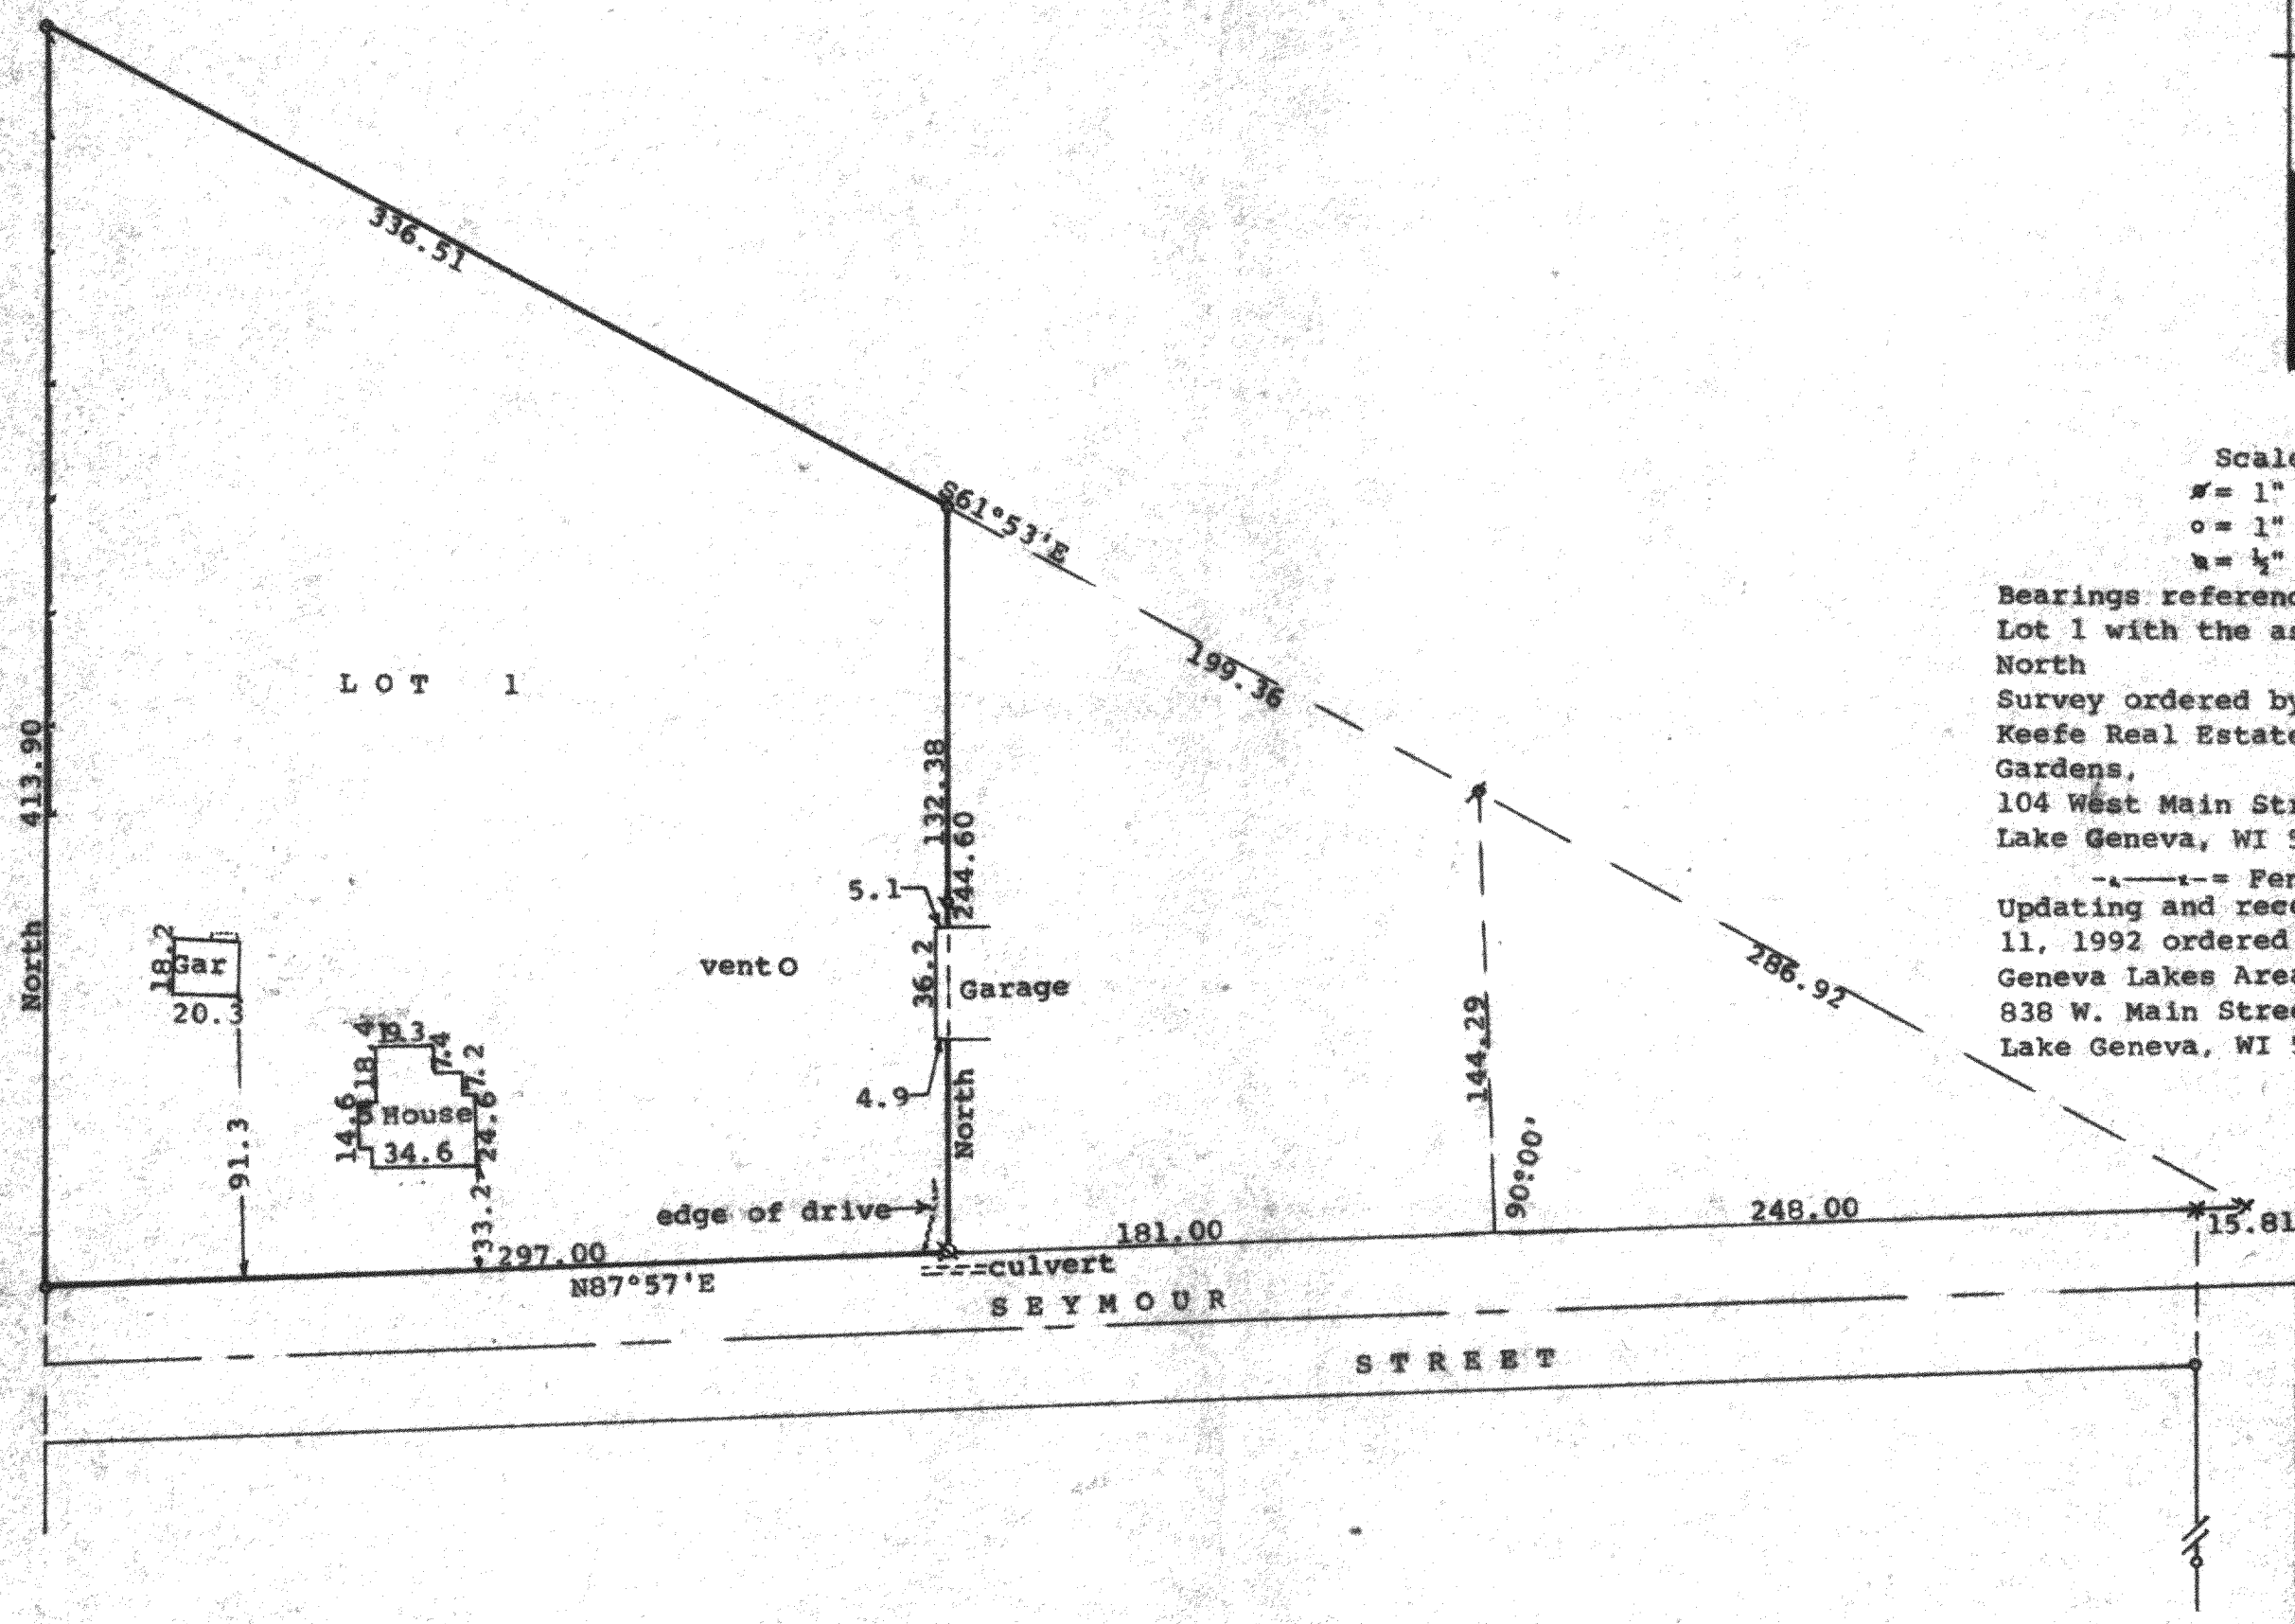

Scale - 1" = 60'
 x = 1" Iron Pipe Found
 o = 1" X 24" Iron Pipe Set
 u = 1/2" X 24" Iron Pipe Set
 Bearings referenced to the west line of Lot 1 with the assumed bearing of North
 Survey ordered by:
 Keefe Real Estate, Better Homes and Gardens,
 104 West Main Street
 Lake Geneva, WI 53147
 Updating and recertification on Sept. 11, 1992 ordered by: Coldwell Banker Geneva Lakes Area Realtors
 838 W. Main Street
 Lake Geneva, WI 53147

STATE OF WISCONSIN) ss
 COUNTY OF WALWORTH)



I, George T. Dunham, Surveyor, certify that that I have surveyed the property described as follows:

Lot 1 in Block 4 of Wise and Nelsons South Side Addition, located in Section 32, T 1 N, R 15 E, Walworth County, Wisconsin and that the plat shown hereon is a correct representation thereof and shows the size and location of the property, its exterior boundaries, the location of all visible structures and dimensions of all principal buildings thereon, boundary fences, apparent easements, roadways and visible encroachments, if any, and that I have surveyed the property hereon described, according to the official records, to the best of my knowledge and belief.

December 28, 1989

Updated and recertified to this
 11th day of September, 1992

George T. Dunham
 George T. Dunham, Surveyor

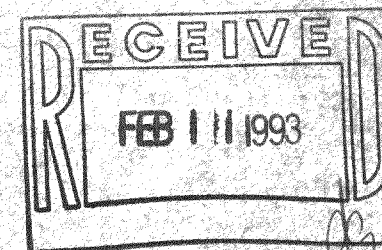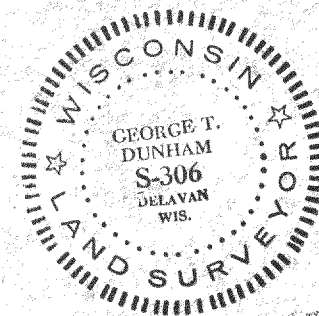

DWNSS - 1

DWNSS - 4

115-171

115-93