


DUNHAM SURVEYING, S.C.
SURVEYING & SUBDIVIDING
DELAVER, WISCONSIN 53115

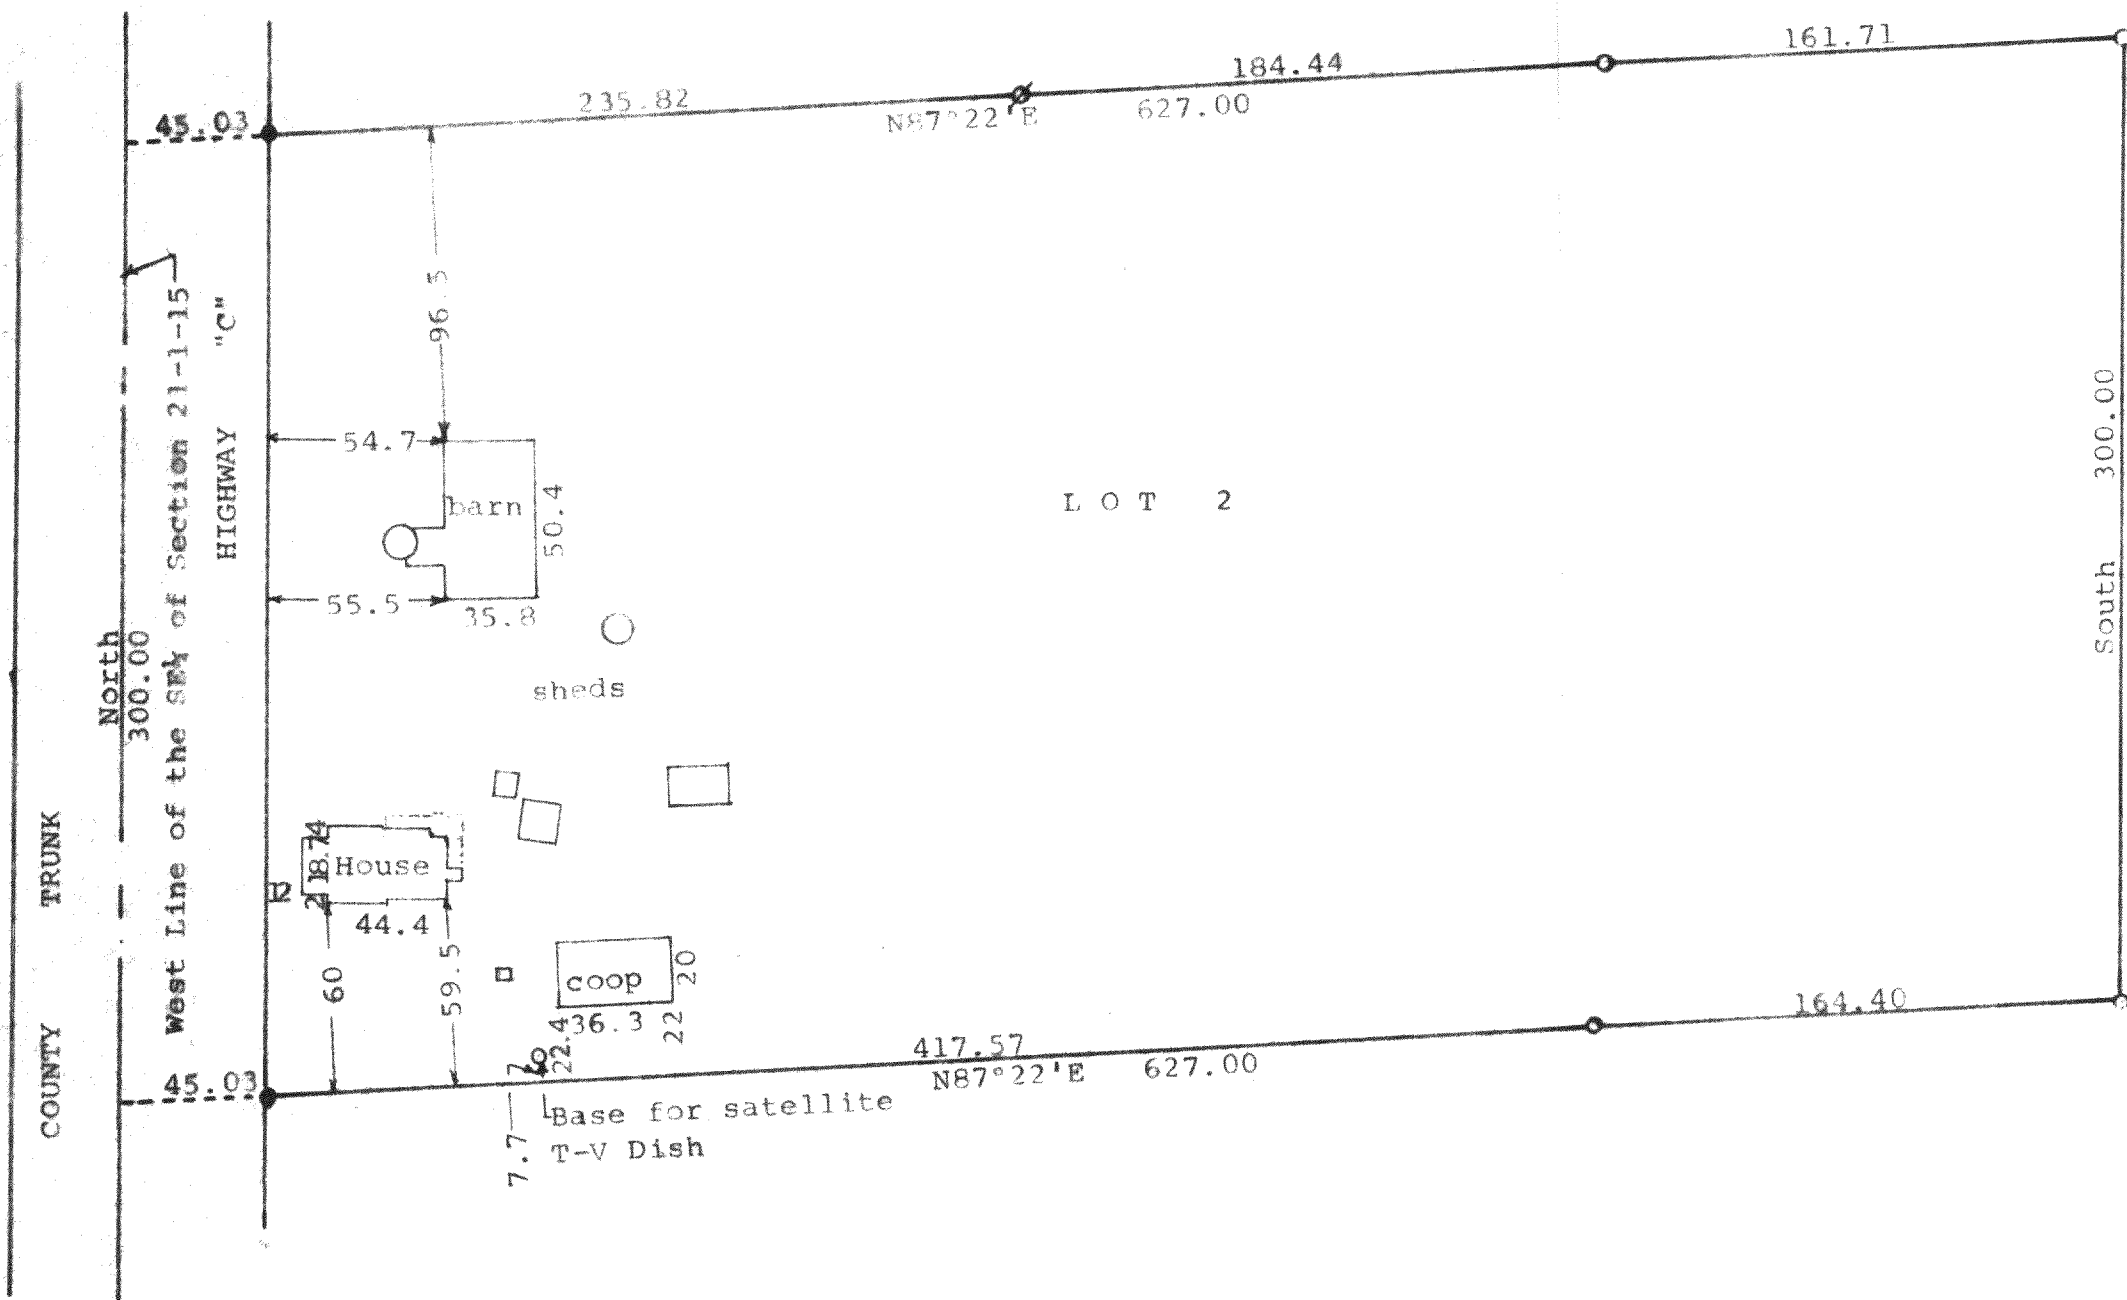

Scale - 1" = 60'
 ● = 1" Iron Pipe Found
 ∅ = 3/4" Iron Pipe Found
 ○ = Iron Pipe Set, size not noted
 Survey ordered by: Century 21 Affiliated
 Southern Lakes
 50 West Geneva,
 Williams Bay, WI
 53191

STATE OF WISCONSIN) SS
 COUNTY OF WALWORTH)

I, George T. Dunham, Surveyor, certify that I have surveyed the property described as follows:
 Lot 2 of Certified Survey No. 186, recorded in Volume 1 of Certified Surveys, Page 186, Document No. 657306, on November 14, 1972, in the Office of the Register of Deeds, Walworth County, Wisconsin and being a parcel of land located in the Northwest 1/4 of the Southeast 1/4 of Section 21, T 1 N, R 15 E, Walworth County, Wisconsin.
 and that the plat shown hereon is a correct representation thereof and shows the size and location of the property, its exterior boundaries, the location of all visible structures and dimensions of all principal buildings thereon, boundary fences, apparent easements, roadways and visible encroachments, if any, and that I have surveyed the property hereon described, according to the official records, to the best of my knowledge and belief.
 August 2, 1999

George T. Dunham
 George T. Dunham, Surveyor

