


LAND-MARK SURVEYING

Mark L. Miritz
Wisconsin Professional Land Surveyor S-2582

N9330 Knuteson Drive
Whitewater, WI 53190
Phone: (262) 495-3284
MARKMIRITZ@
LAND-MARKSURVEYING.COM

PLAT OF SURVEY

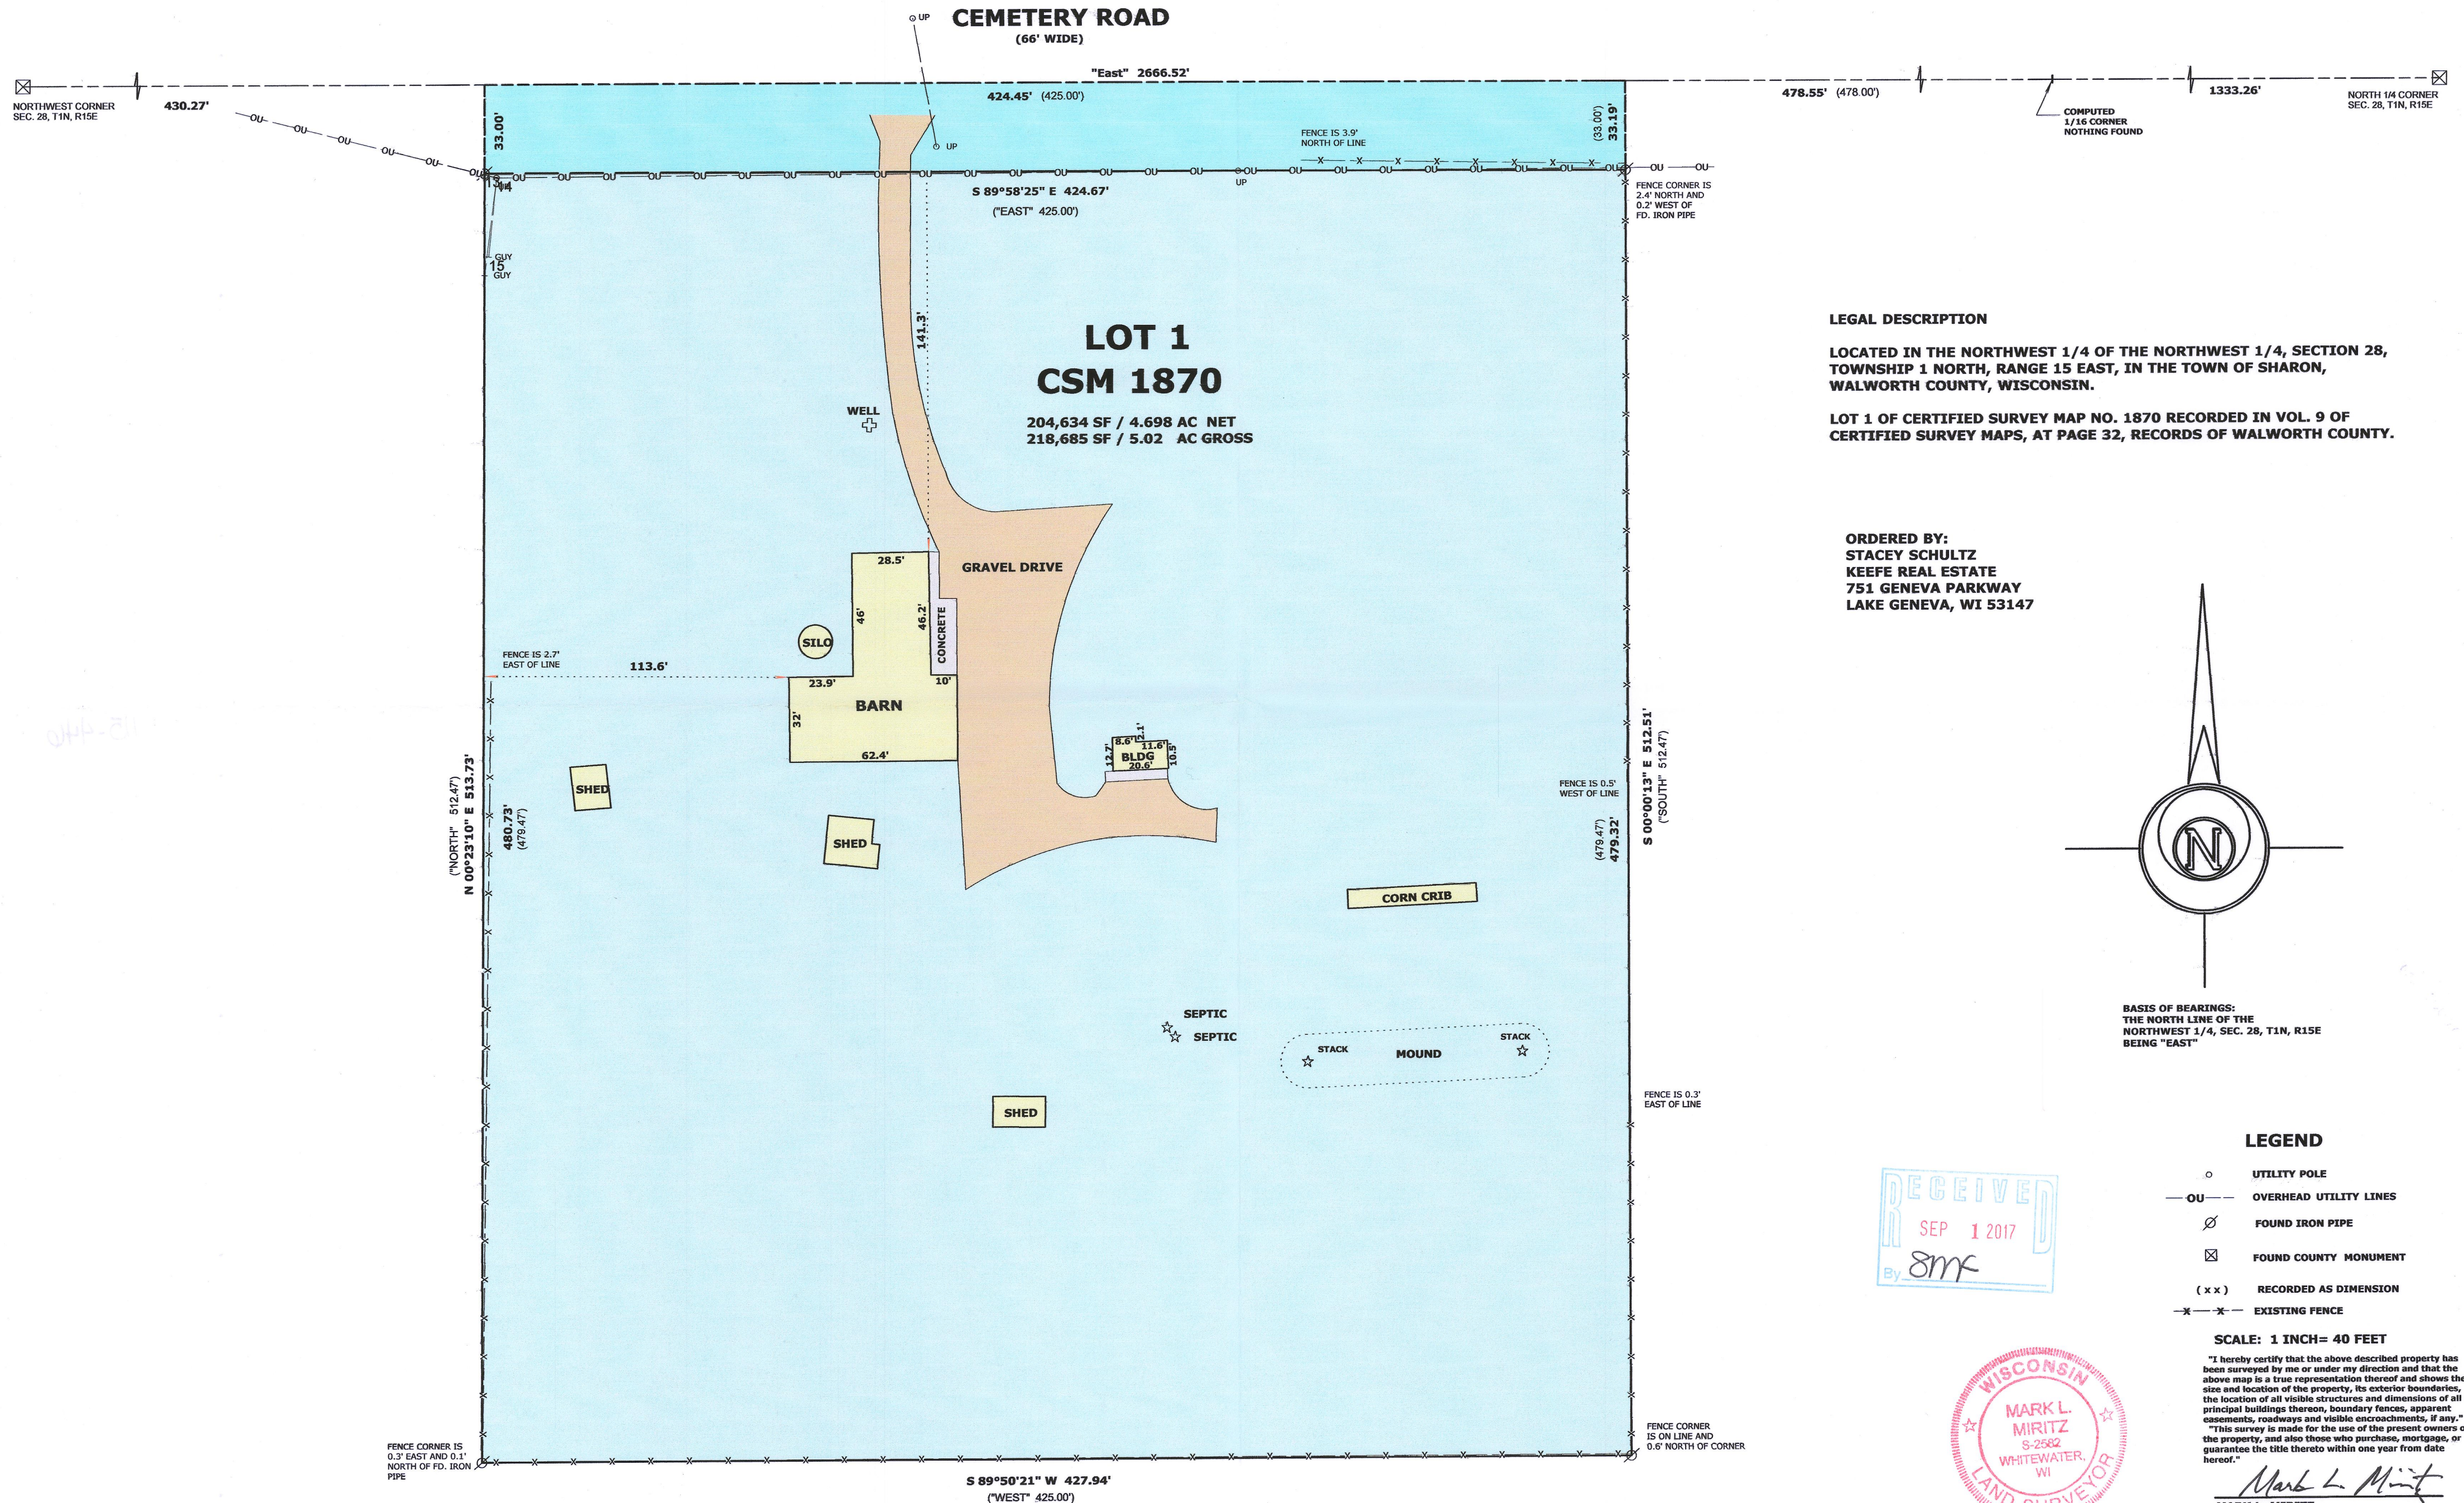


LEGAL DESCRIPTION

LOCATED IN THE NORTHWEST 1/4 OF THE NORTHWEST 1/4, SECTION 28, TOWNSHIP 1 NORTH, RANGE 15 EAST, IN THE TOWN OF SHARON, WALWORTH COUNTY, WISCONSIN.

LOT 1 OF CERTIFIED SURVEY MAP NO. 1870 RECORDED IN VOL. 9 OF CERTIFIED SURVEY MAPS, AT PAGE 32, RECORDS OF WALWORTH COUNTY.

ORDERED BY:
STACEY SCHULTZ
KEEFE REAL ESTATE
751 GENEVA PARKWAY
LAKE GENEVA, WI 53147

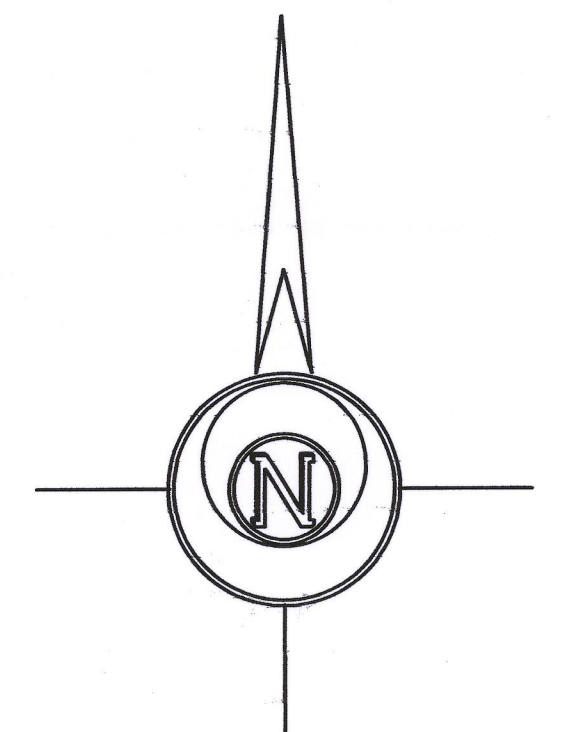

BASIS OF BEARINGS:
THE NORTH LINE OF THE
NORTHWEST 1/4, SEC. 28, T1N, R15E
BEING "EAST"

LEGEND


- UTILITY POLE
- OU— OVERHEAD UTILITY LINES
- ∅ FOUND IRON PIPE
- ⊠ FOUND COUNTY MONUMENT
- (x x) RECORDED AS DIMENSION
- x-x- EXISTING FENCE

SCALE: 1 INCH= 40 FEET

"I hereby certify that the above described property has been surveyed by me or under my direction and that the above map is a true representation thereof and shows the size and location of the property, its exterior boundaries, the location of all visible structures and dimensions of all principal buildings thereon, boundary fences, apparent easements, roadways and visible encroachments, if any."
"This survey is made for the use of the present owners of the property, and also those who purchase, mortgage, or guarantee the title thereto within one year from date hereof."

Mark L. Miritz
MARK L. MIRITZ
WISCONSIN PROFESSIONAL
LAND SURVEYOR S-2582

DATE: AUGUST 19, 2017 JOB NO. 17.810

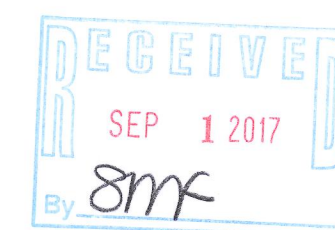

AA1870-1

112-440

115-446