

LAND-MARK SURVEYING


Mark L. Miritz
Wisconsin Professional Land Surveyor S-2582

N9330 Knuteson Drive
Whitewater, WI 53190
Phone: (262) 495-3284
MARKMIRITZ@
LAND-MARKSURVEYING.COM

ORDERED BY:
STACEY SCHULTZ
KEEFE REAL ESTATE
751 GENEVA PARKWAY
LAKE GENEVA, WI 53147

PLAT OF SURVEY

Lot 2 of Certified Survey Map No. 2139, recorded in
Volume 10 of Certified Surveys on Page 166 as Document
No. 233609, located in the NE 1/4 of Section 17, Town 1 North,
Range 16 East, Town of Walworth, State of Wisconsin, and being a
redivision of Lots 1 and 2 of Certified Survey No. 998
and Lots 1 and 2 of Certified Survey Map No. 1117.

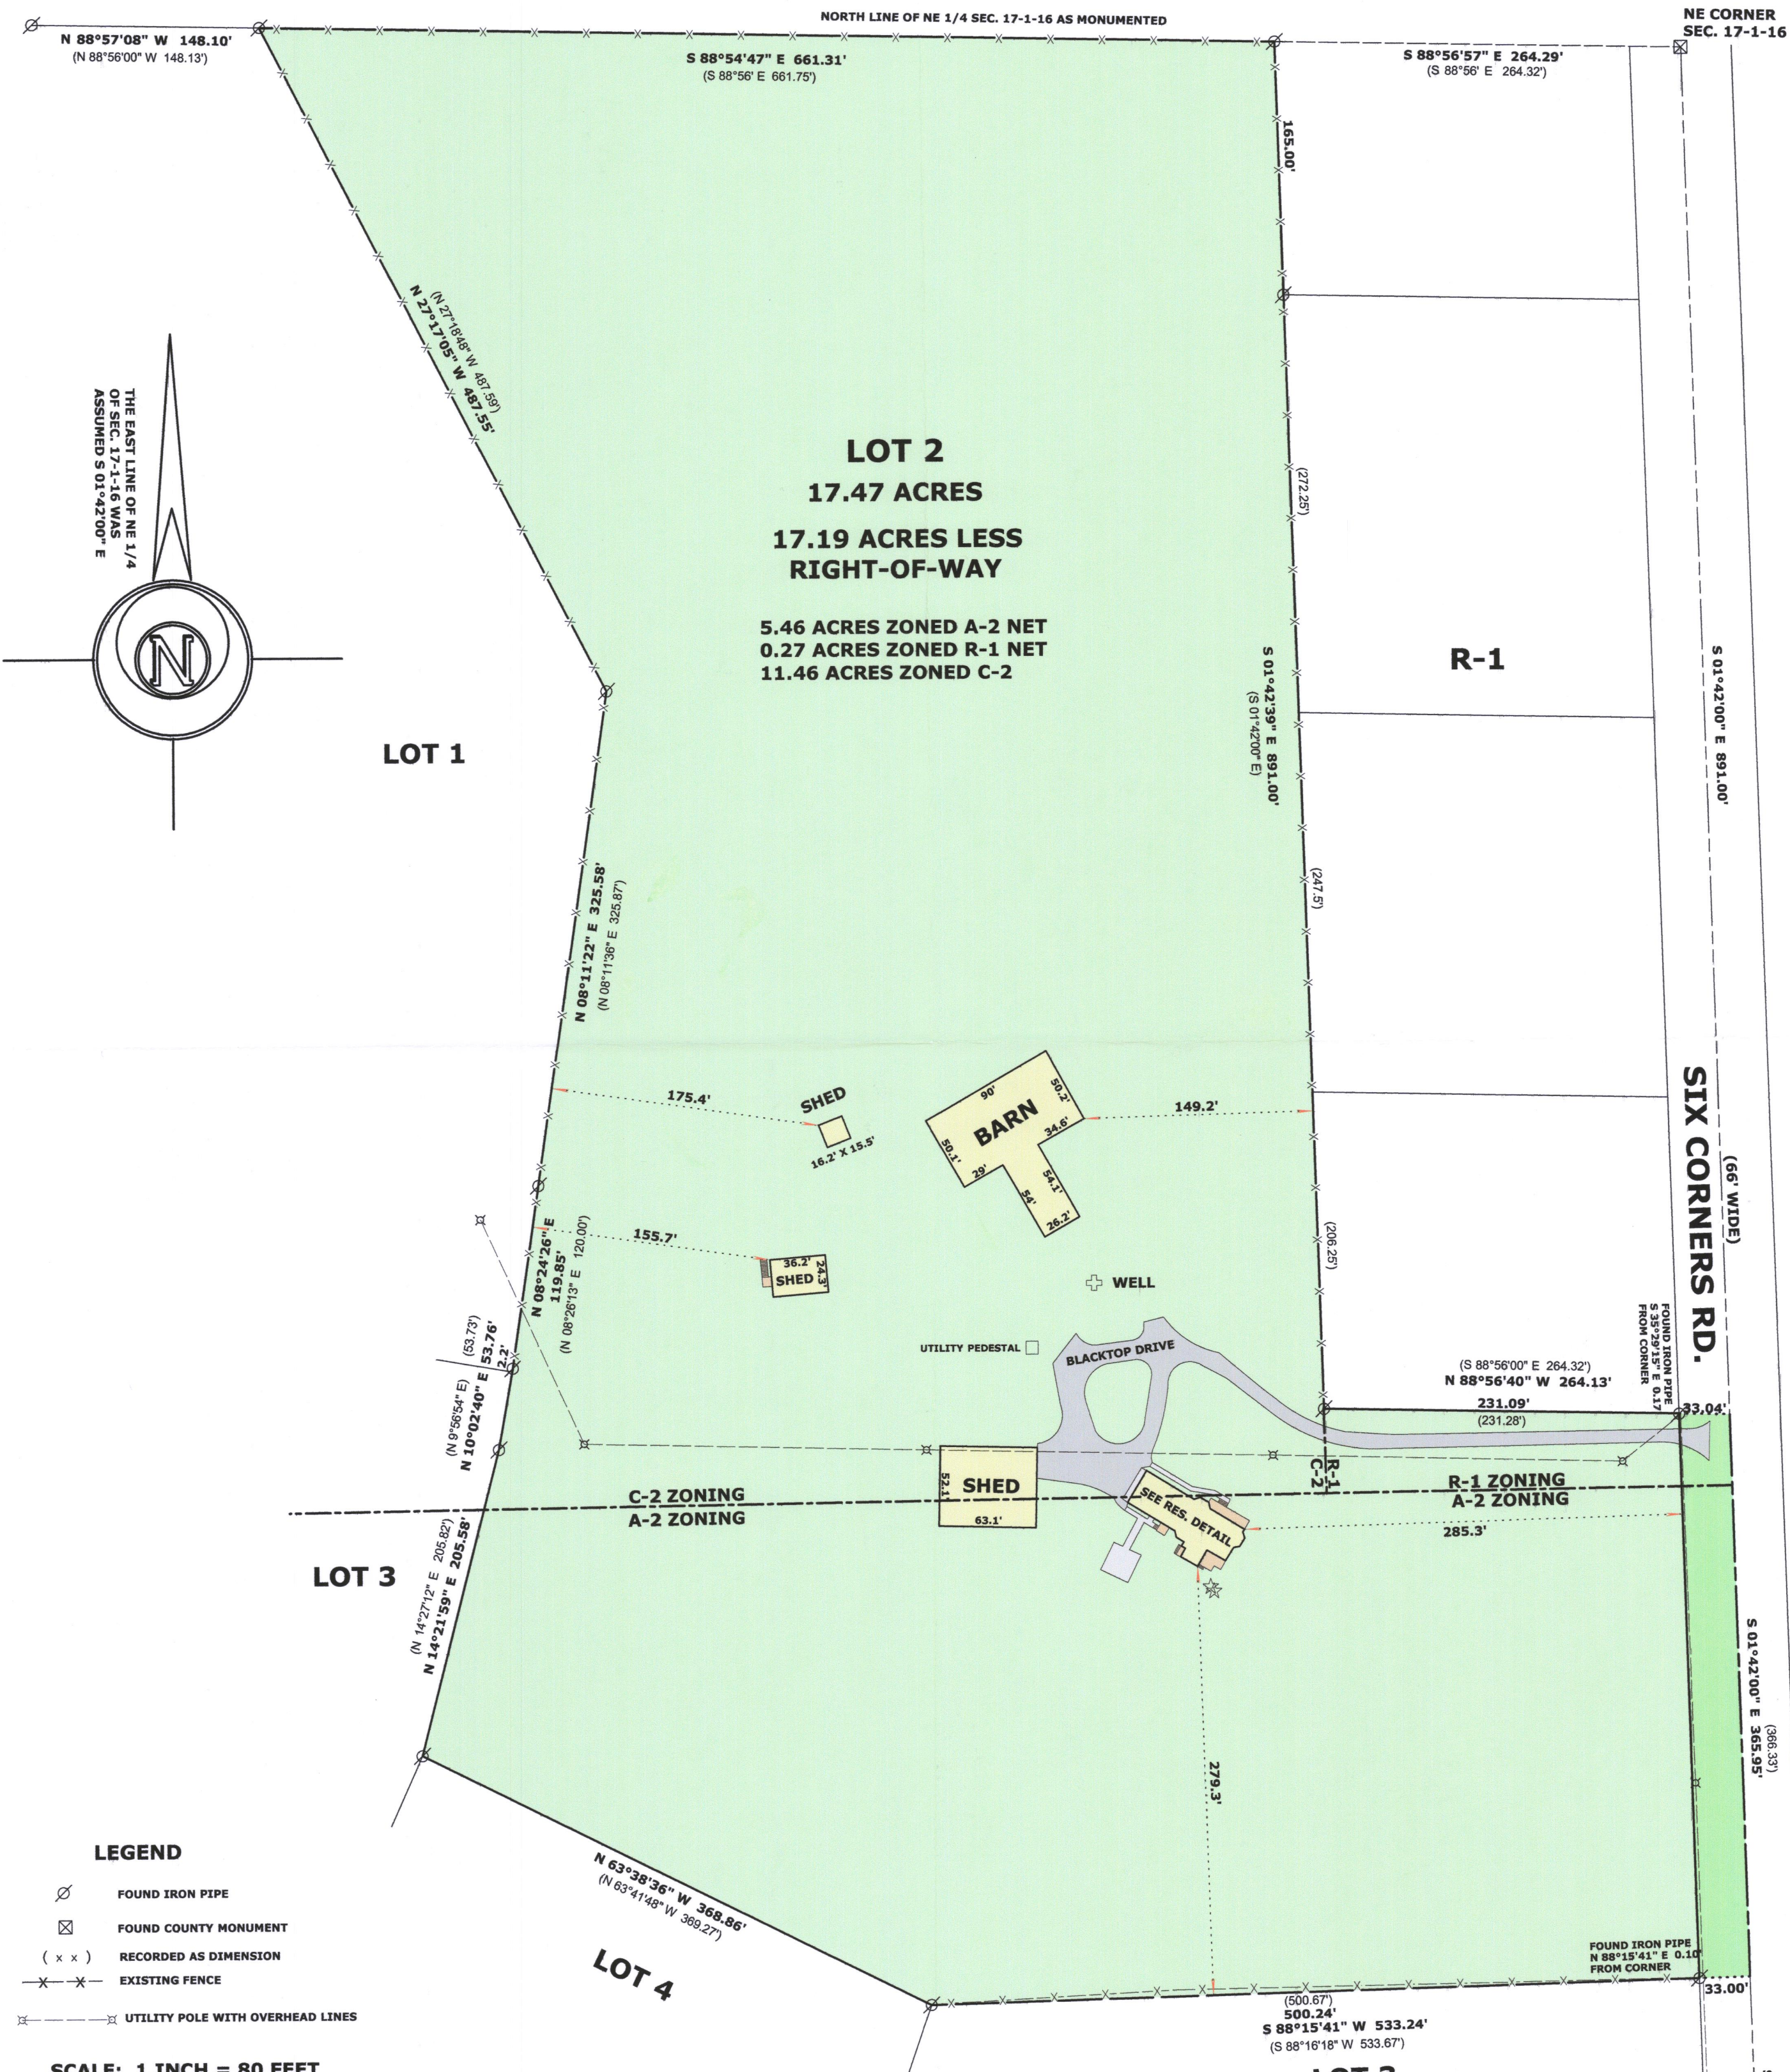

LEGEND

- FOUND IRON PIPE
- FOUND COUNTY MONUMENT
- RECORDED AS DIMENSION
- EXISTING FENCE
- UTILITY POLE WITH OVERHEAD LINES

SCALE: 1 INCH = 80 FEET

"I hereby certify that the above described property has
been surveyed by me or under my direction and that the
above map is a true representation thereof and shows the
size and location of the property, its exterior boundaries,
the location of all visible structures and dimensions of all
principal buildings thereon, boundary fences, apparent
easements, roadways and visible encroachments, if any."
"This survey is made for the use of the present owners of
the property, and also those who purchase, mortgage, or
guarantee the title thereto within one year from date
hereof."

MARK L. MIRITZ
WISCONSIN PROFESSIONAL
LAND SURVEYOR S-2582

DATE: JUNE 26, 2017 JOB NO. 17.610



EA2139-2 116-1026

EAST 1/4 CORNER
SECTION 17-1-16