


S.E. CORNER OF LOT 41
BLOCK 4, ROBBINS SUB.



N

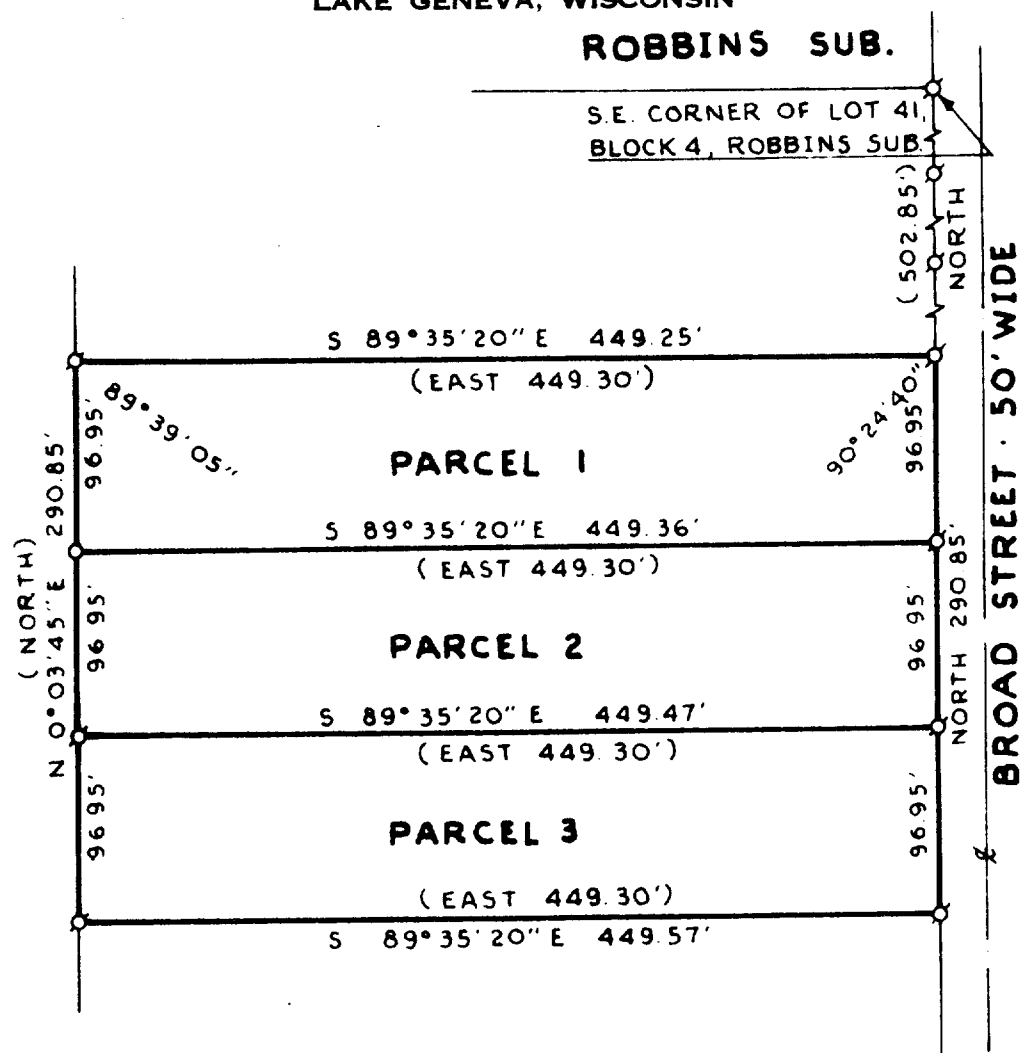

SCALE 1"=100'

LEGEND

- φ --- IRON PIPE FOUND
 ○ --- IRON PIPE PLACED
 ● --- CONCRETE MONUMENT
 x --- SPIKE
 () ---

PLAN OF SURVEY OF

4. The following are the results of the tests conducted on the samples of the material:

NOTE: The prices were existing on 1/1/77.
 February, 1977.

I, HAROLD H. KOLB, DO HEREBY CERTIFY THAT I HAVE SURVEYED THE PROPERTY HEREON DESCRIBED ACCORDING TO THE OFFICIAL RECORDS, AND THAT THE PLAT HEREON IS A CORRECT REPRESENTATION OF THE LOT LINES.

Harold H. Kab

HAROLD H. KOLB
WISCONSIN REGISTERED LAND SURVEYOR, S-187

DATE May 21, 1973



W-5-22 (now one parcel)

116-103

~~111-58~~