


Plat of Survey

of

Lot 1 of Certified Survey Map No. 4630,

recorded in Vol. 30 of Certified Survey Maps of Walworth County on Page 237
and located in the Northwest 1/4 of the Southwest 1/4 of Section 18, Town 1
North, Range 16 East, Town of Walworth, Walworth County, Wisconsin.

Surveyed for: **Brett & Amy Polyock**
W7269 Brick Church Road
Walworth, Wisconsin. 53184

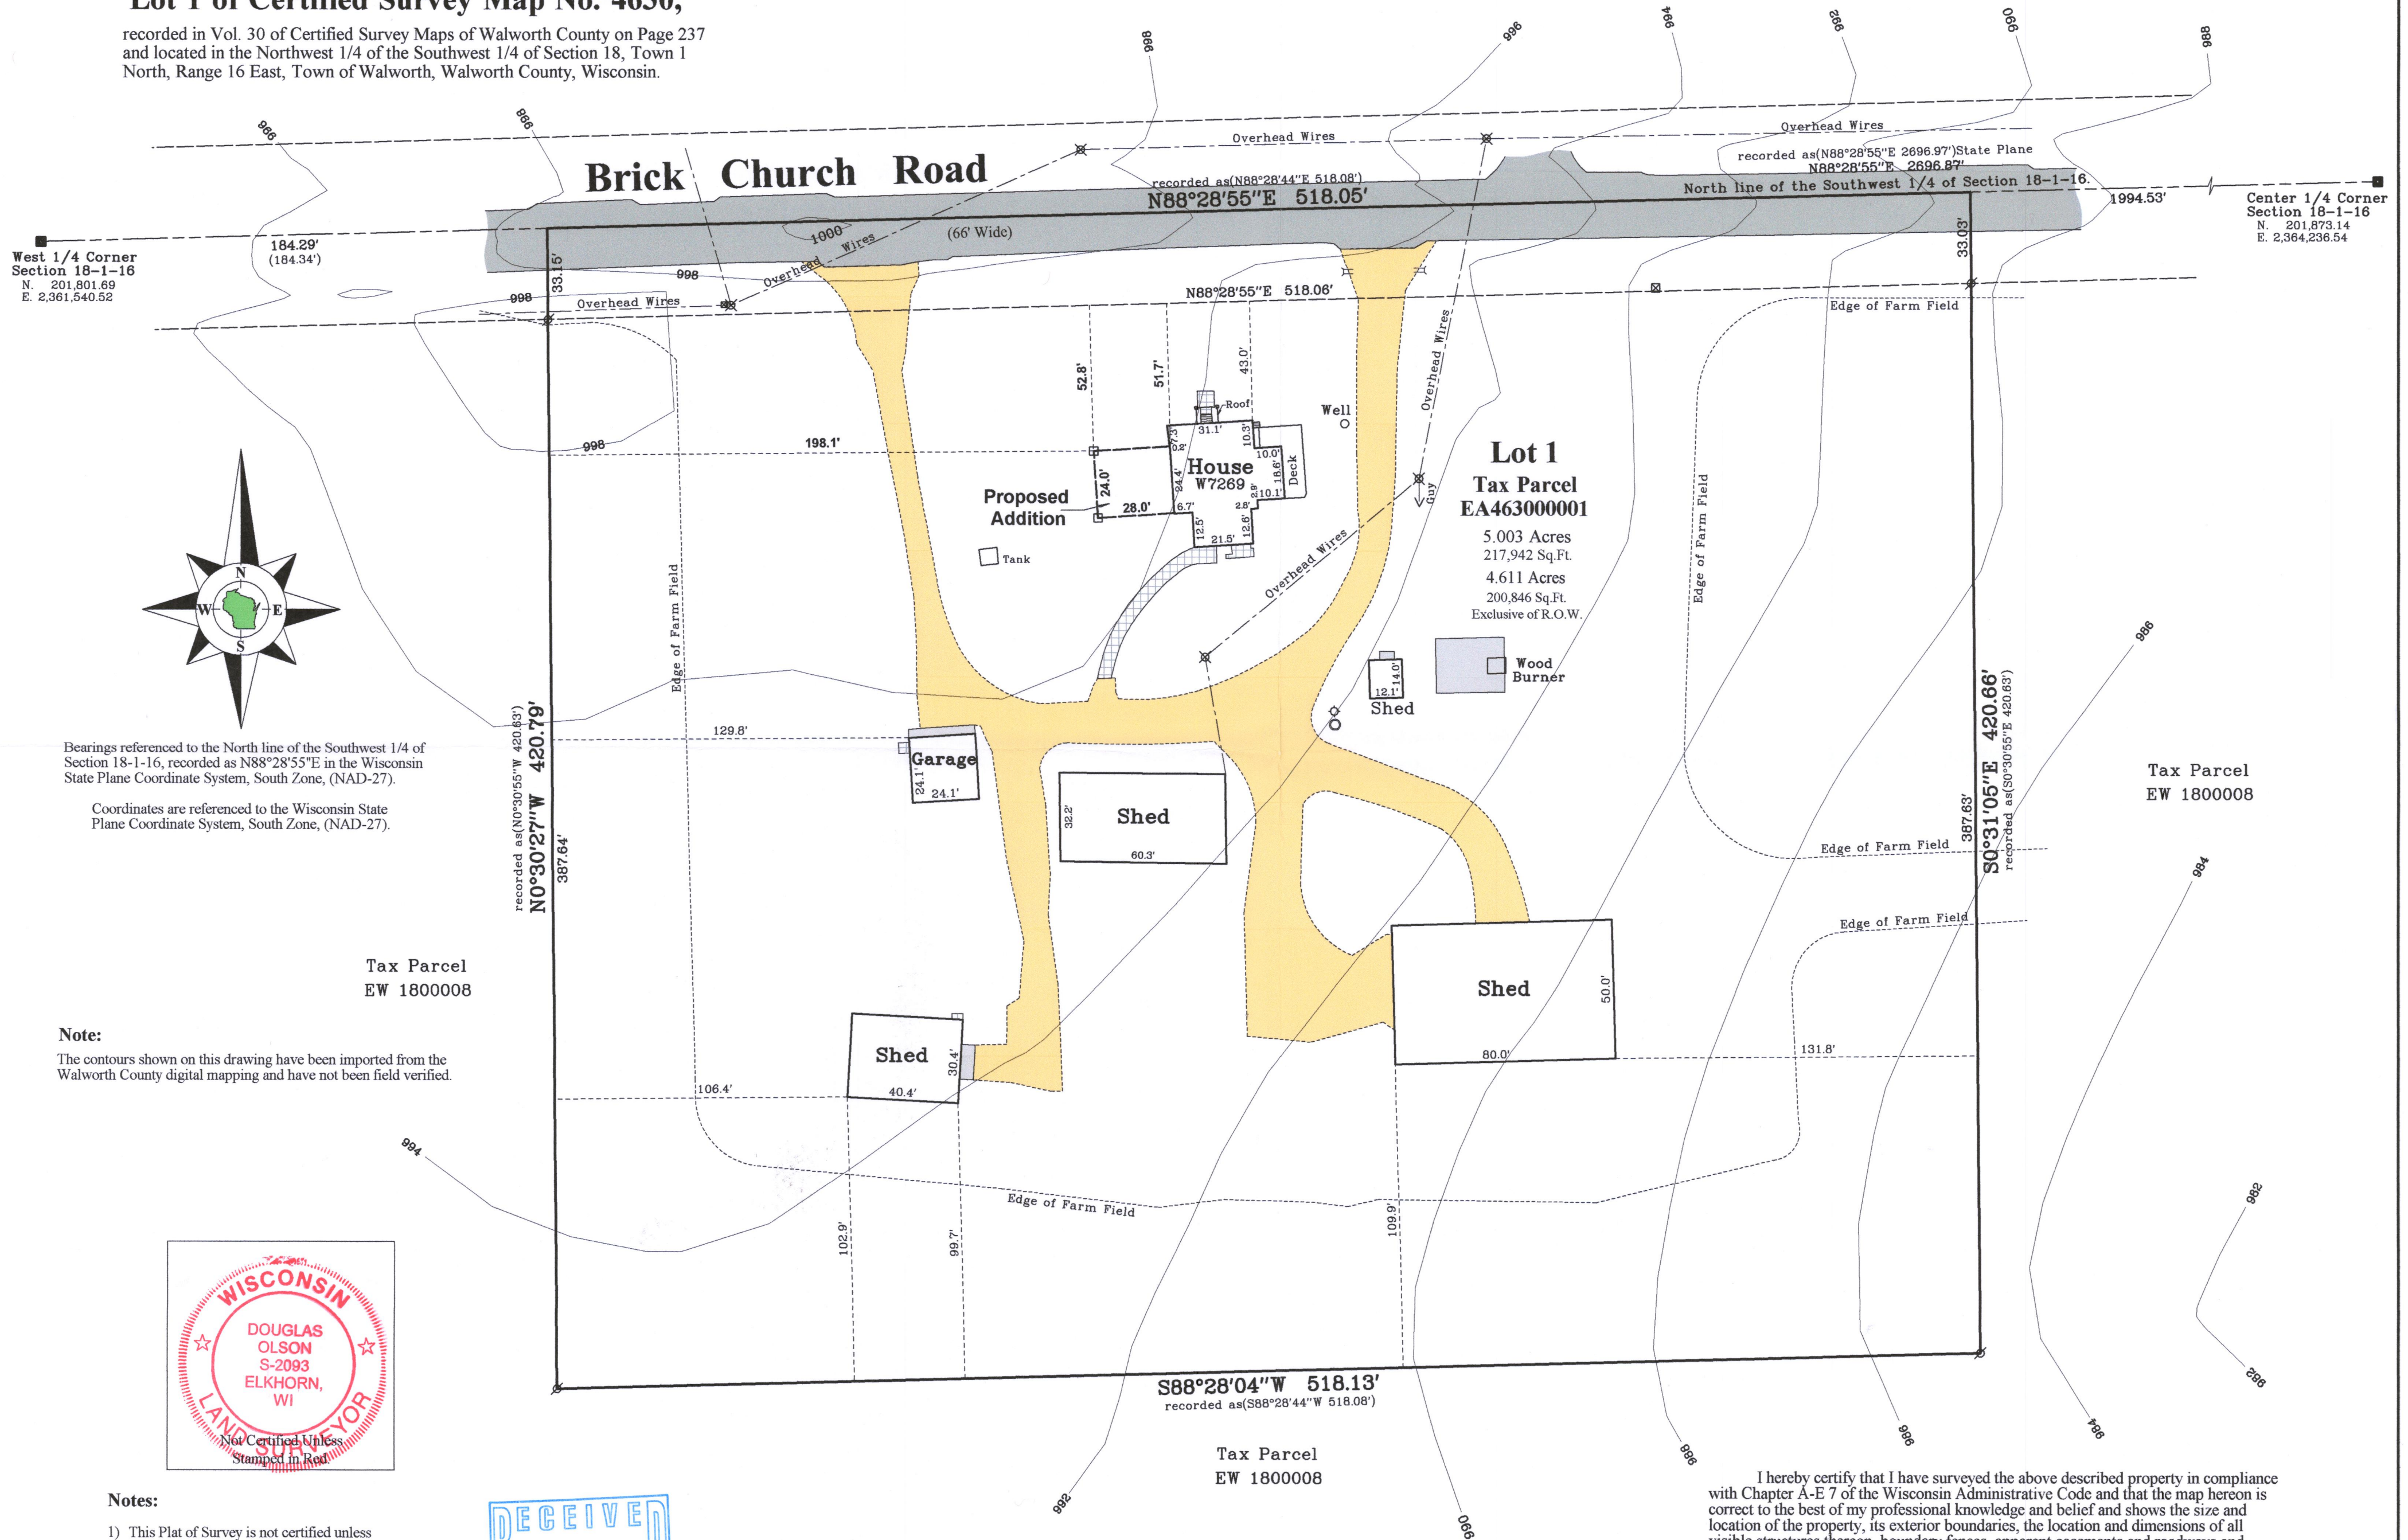


Bearings referenced to the North line of the Southwest 1/4 of
Section 18-1-16, recorded as N88°28'55\"/>


Coordinates are referenced to the Wisconsin State
Plane Coordinate System, South Zone, (NAD-27).

Tax Parcel
EW 1800008

Note:
The contours shown on this drawing have been imported from the
Walworth County digital mapping and have not been field verified.

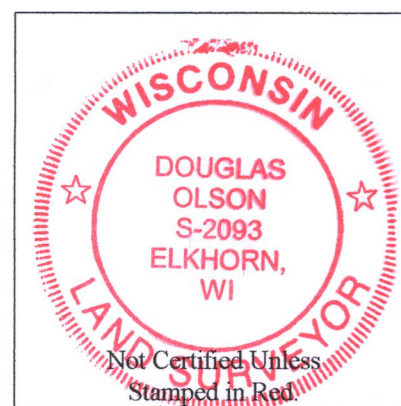

- Notes:**
- This Plat of Survey is not certified unless signed and sealed in red ink.
 - This survey is subject to Wisconsin lien laws. This Plat of Survey is the notice of intent to file lien. Lien waiver required.
 - The Survey Date shown on this Plat of Survey is the completion date of the field work.

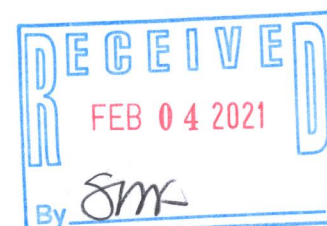

Copyright ©2017 by Olson Land Surveying, LLC.


All rights reserved. No part of this survey plat may be reproduced or transmitted in any form by any means - graphic, electronic, or mechanical, including photocopying, tracing, or information storage and retrieval systems - without permission in writing from Douglas G. Olson, Olson Land Surveying, LLC.

I hereby certify that I have surveyed the above described property in compliance with Chapter A-E 7 of the Wisconsin Administrative Code and that the map hereon is correct to the best of my professional knowledge and belief and shows the size and location of the property, its exterior boundaries, the location and dimensions of all visible structures thereon, boundary fences, apparent easements and roadways and visible encroachments, if any.

This survey is made for the exclusive use of the present owners of the property, and also those who purchase, mortgage or guarantee title thereto, within one year from the date hereof.

Douglas G. Olson
Wisconsin Professional Land Surveyor - 2093

Survey Date: November 28, 2017.
Revisions:
No. 1 - Tillable Area
No. 2 - County Topo
No. 3A - Proposed Building
No. 4 - Proposed House
No. 5 - House Addition
As-built

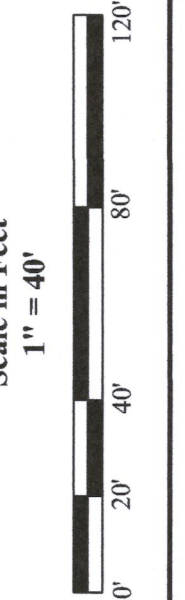

45 South Wisconsin Street | P.O. Box 322
Elkhorn, Wisconsin 53121
Telephone: (262) 723-3434
Facsimile: (262) 723-8044
Email: doug@olsonsurveying.com
Website: www.olsonsurveying.com

OLSON
LAND SURVEYING, LLC
Rural | Residential | Commercial

Legend of Symbols & Abbreviations
N North
S South
W West
E East
In Bearings
in Feet
in Minutes
in Seconds
in Distances
in Inches
Found County Section Corner
Found Iron Pipe
Recorded Information
Utility Pole
Concrete Cover
Septic Vent
Gravel Surface
Brick Pavers, Patio Blocks or Stone

Sheet 1 of 1 Sheets
Drawing Name:
Job Reference Number
2020.076

2020.076