
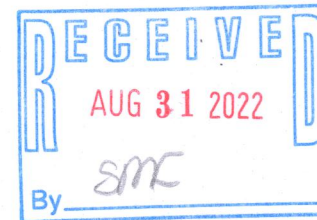
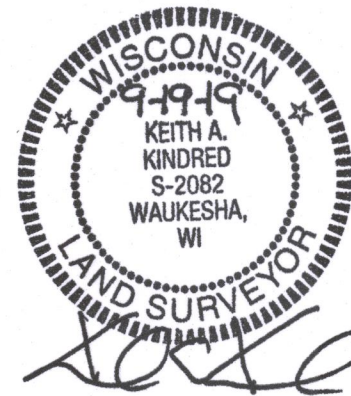
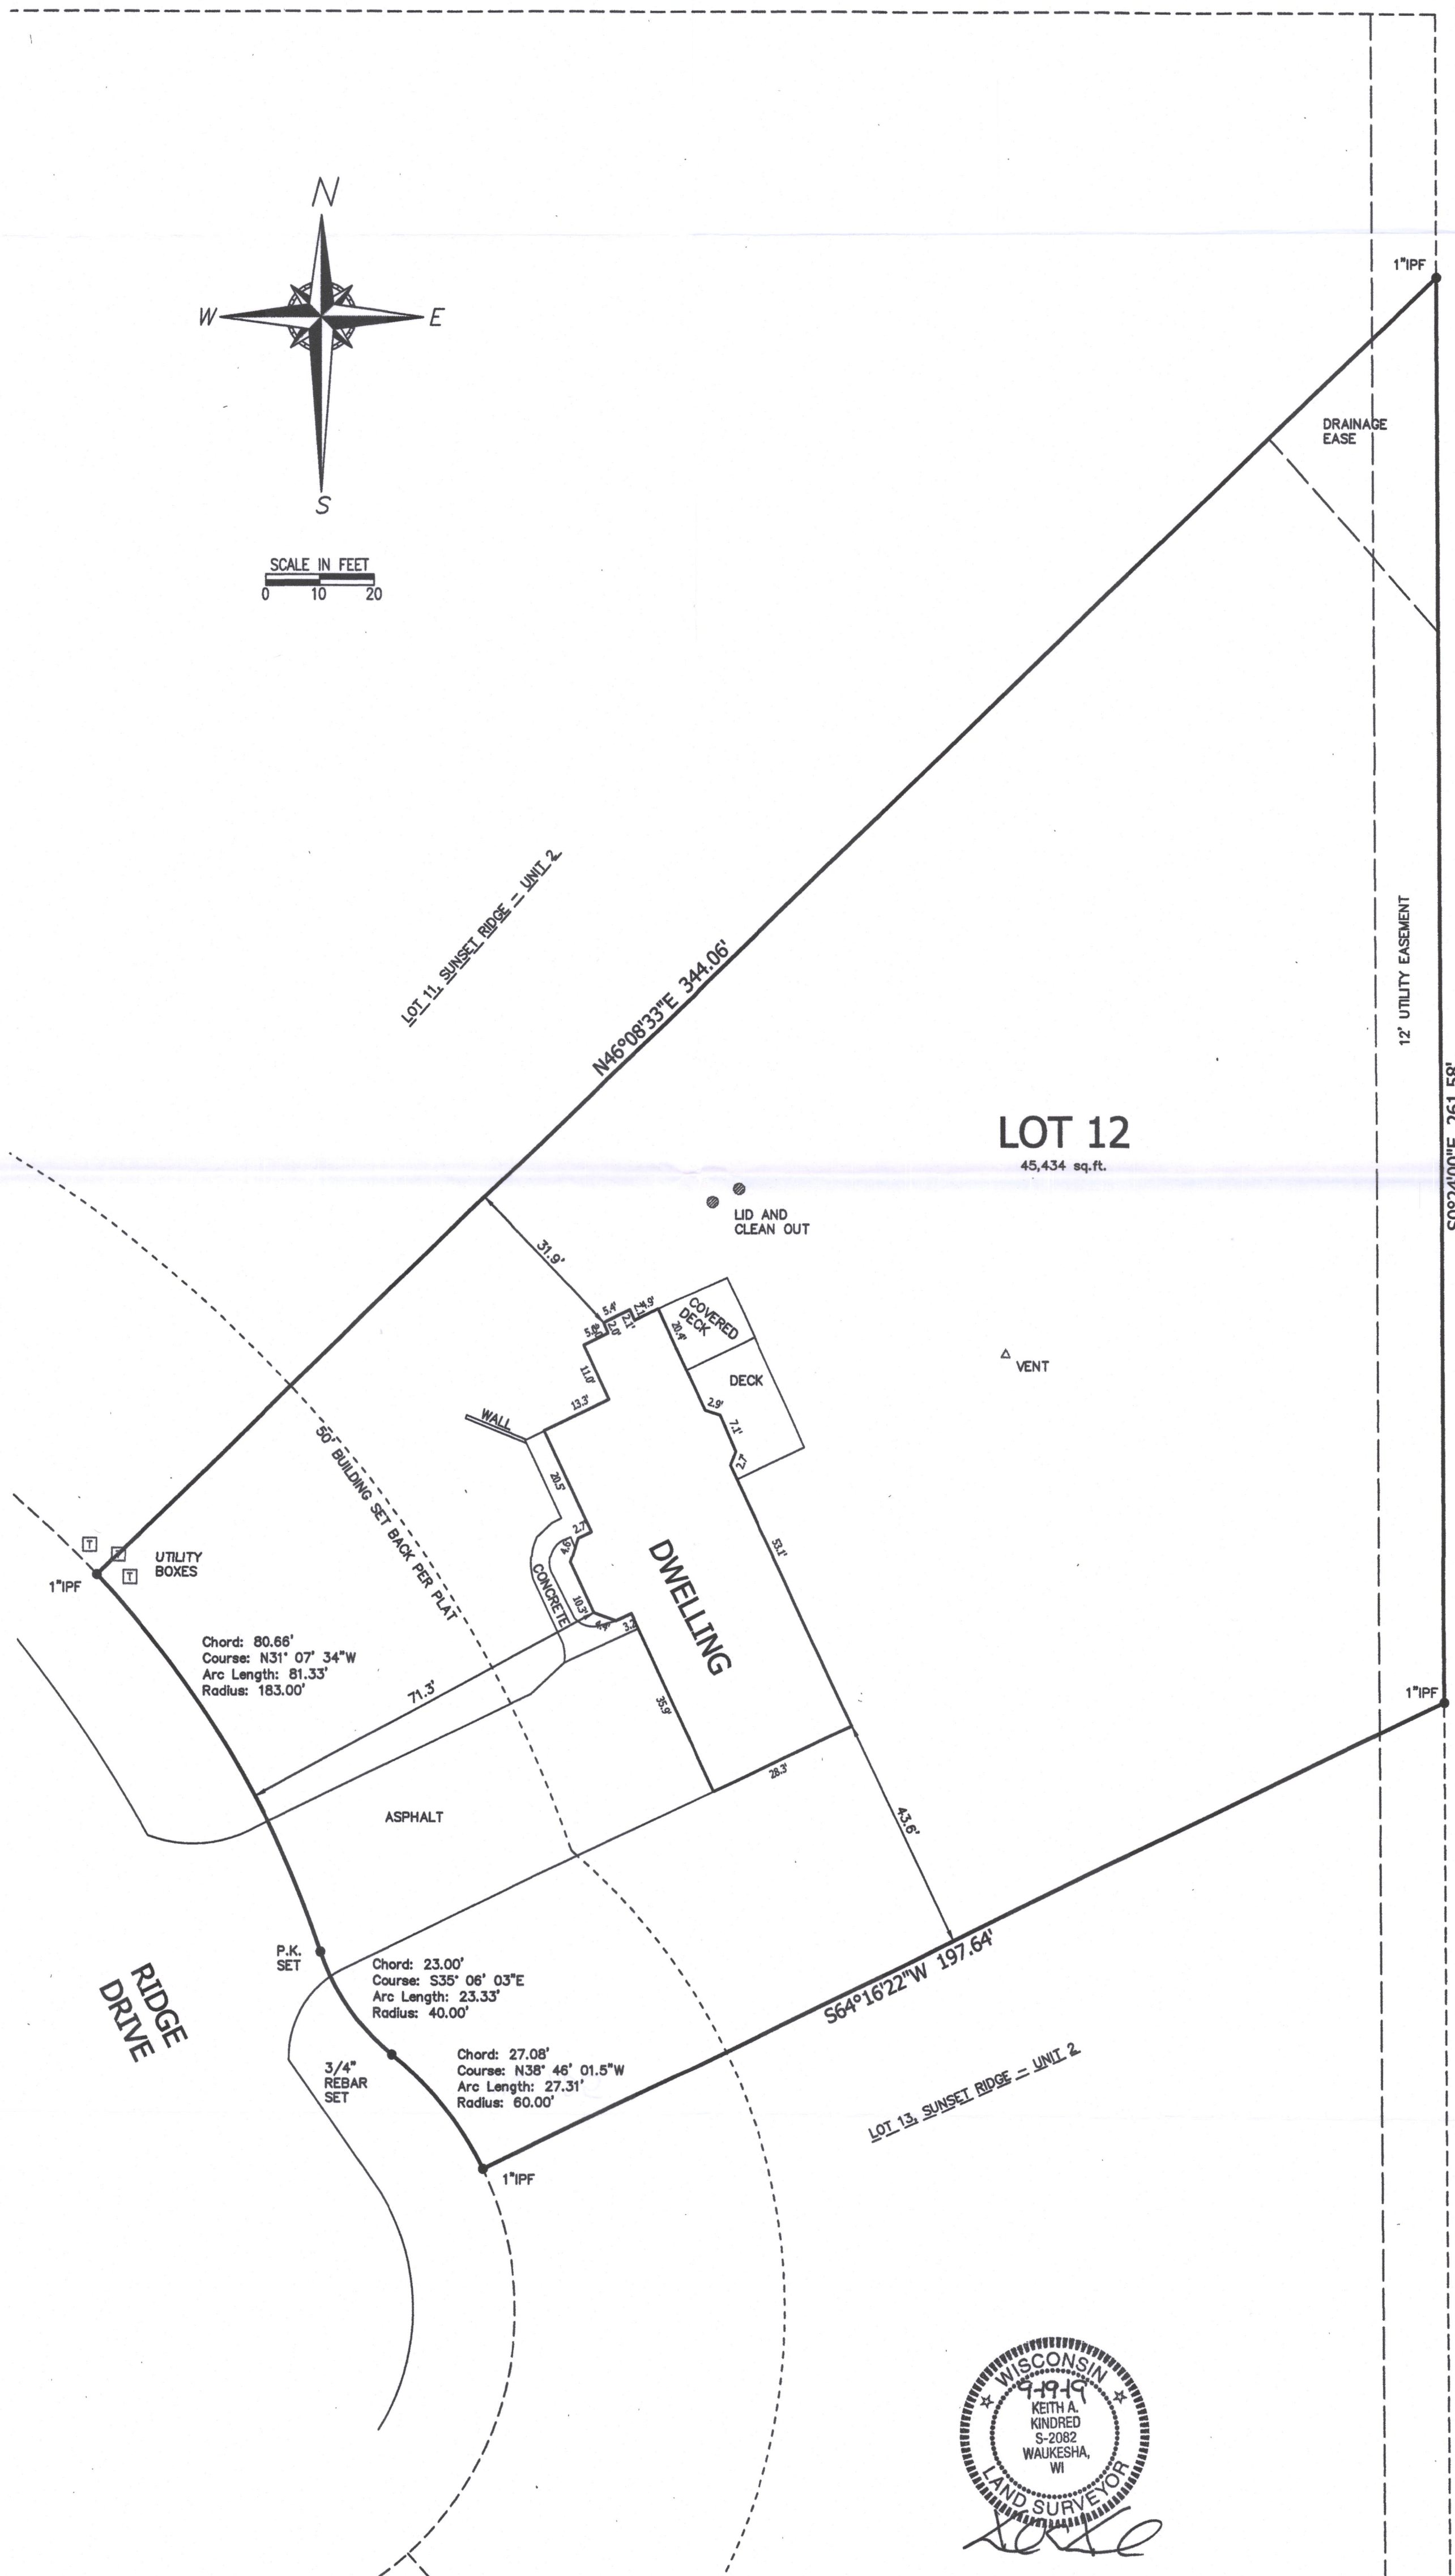


PLAT OF SURVEY

BEING ALL OF LOT 12 OF SUNSET RIDGE - UNIT 2
LOCATED IN THE NW 1/4 OF THE NW 1/4 OF SEC. 11 T.01N., R.16E.,
IN THE TOWN OF WALWORTH, WALWORTH COUNTY, WISCONSIN

SURVEYOR:
KEITH A. KINDRED, SLS 8-2082
SEH
501 MAPLE AVE
DELAFIELD, WI 53018
(414) 946-8819
KKINDRED@SEHINC.COM

SURVEY FOR:
JERRY TAYLOR
WS0757065 APPLEWOOD CT.
MUKWONAGO, WI 53149

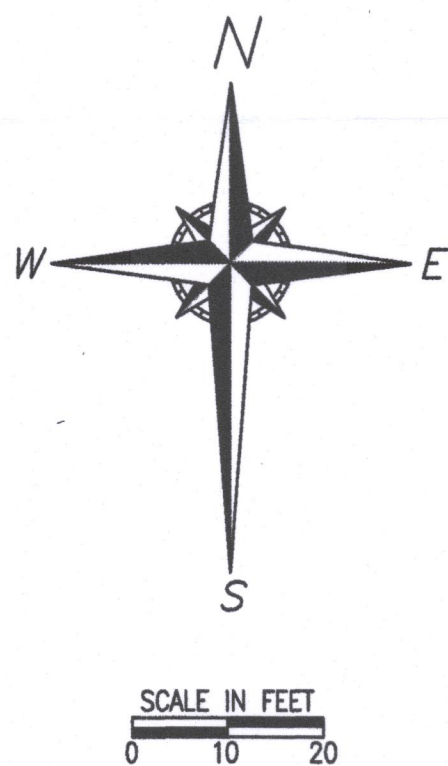

SURVEYOR'S CERTIFICATE:

I HEREBY CERTIFY THAT I HAVE SURVEYED THE ABOVE DESCRIBED PROPERTY AND THAT THE ABOVE MAP IS A TRUE REPRESENTATION THEREOF AND SHOWS THE SIZE AND LOCATION OF THE PROPERTY, ITS EXTERIOR BOUNDARIES, THE LOCATION OF ALL VISIBLE STRUCTURES AND DIMENSIONS OF ALL PRINCIPAL BUILDINGS THEREON, BOUNDARY FENCES, APPARENT EASEMENTS, ROADWAYS, AND VISIBLE ENCROACHMENTS, IF ANY.

THIS SURVEY IS MADE FOR THE USE OF THE PRESENT OWNERS OF THE PROPERTY, AND ALSO THOSE WHO PURCHASE, MORTGAGE, OR GUARANTEE THE TITLE THERETO WITHIN ONE (1) YEAR FROM DATE HEREOF.

