




Lot 4 of Certified Survey Map Number 1663, located in the Northeast Quarter of Section 11, Township 1 North, Range 16 East, Walworth County, Wisconsin, recorded January 25, 1988, in Volume 8 of Certified Surveys, page 19 as Document No. 158094.

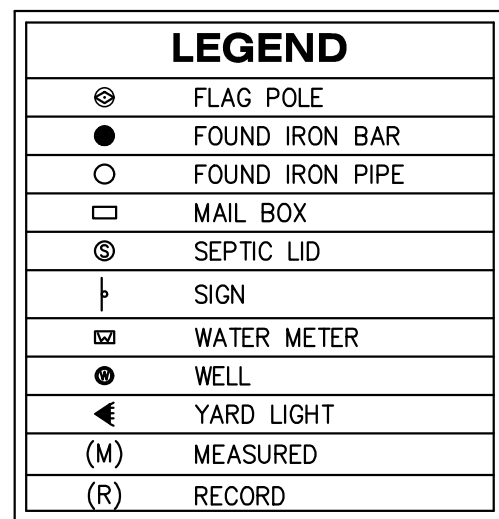


CLIENT: BERKSHIRE HATHAWAY HOME SERVICES
 DRAWN BY: TPS CHECKED BY: APG
 SCALE: 1"=20' SEC. 11 T. 01 R. 16 E.
 BASIS OF BEARING: WI S. ZONE NAD83/2011
 P.I.N.: EA166300004
 JOB NO.: 230398 I.D. LSS
 FIELDWORK COMP.: 05/26/23 BK. PG.
 ALL DISTANCES SHOWN IN FEET AND DECIMAL
 PARTS THEREOF CORRECTED TO 68° F. REF: _____

NOTE: Only those Building Line Restrictions or Easements shown on a Recorded Subdivision Plat are shown hereon unless the description ordered to be surveyed contains a proper description of the required building lines or easements.

- * No distance should be assumed by scaling.
- * No underground improvements have been located unless shown and noted.
- * No representation as to ownership, use, or possession should be hereon implied.
- * This Survey and Plat of Survey are void without original embossed or colored seal and signature affixed.

Compare your description and site markings with this plat and AT ONCE report any discrepancies which you may find.

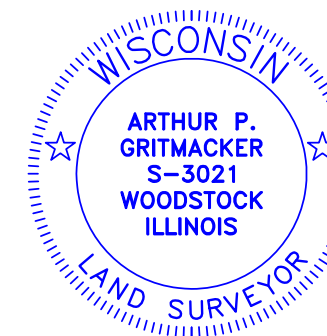[illegible]

In my professional opinion, and based on my observations, I hereby certify that the above described property has been surveyed under my direction and that the above map is a true representation thereof and shows the size and location of all visible structures, and dimensions of all principle buildings thereon, boundary fences, apparent easements, roadways, and visible encroachments, if any. This survey is made for the use of the present owners of the property, and also those who purchase, mortgage, or guarantee the title thereto within one year from the date hereof.

Dated at Woodstock, McHenry County, Illinois 05/31 A.D., 2023.

Vanderstappen Land Surveying, Inc.
Design Firm No. 184-002792

By: *Arthur Gutwachen*
Wisconsin Registered Land Surveyor No. S3021