


# Plat of Survey

of

## Lot 1 of Certified Survey Map No. 3403,




recorded in Vol. 19 of Certified Survey Maps of Walworth County on Page 241 as Document No. 498855 and located in the Southwest 1/4 of the Northeast 1/4 and the Northwest 1/4 of the Southeast 1/4 of Section 25, Town 1 North, Range 16 East, Town of Walworth, Walworth County, Wisconsin.

Surveyed for: **Scott & Glenna Schilthelm**  
W5003 Cobblestone Road  
Walworth, Wisconsin, 53184

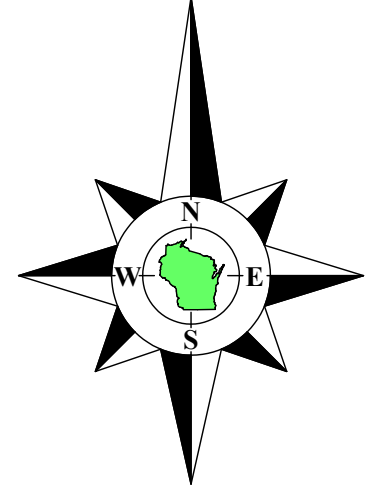

Bearings referenced to the South line of the Northeast 1/4 of Section 25-1-16, recorded as N88°53'41"E in the Wisconsin State Plane Coordinate System, South Zone, (NAD-27).

Coordinates are referenced to the Wisconsin State Plane Coordinate System, South Zone, (NAD-27).

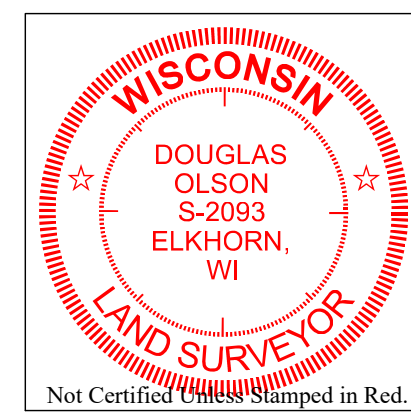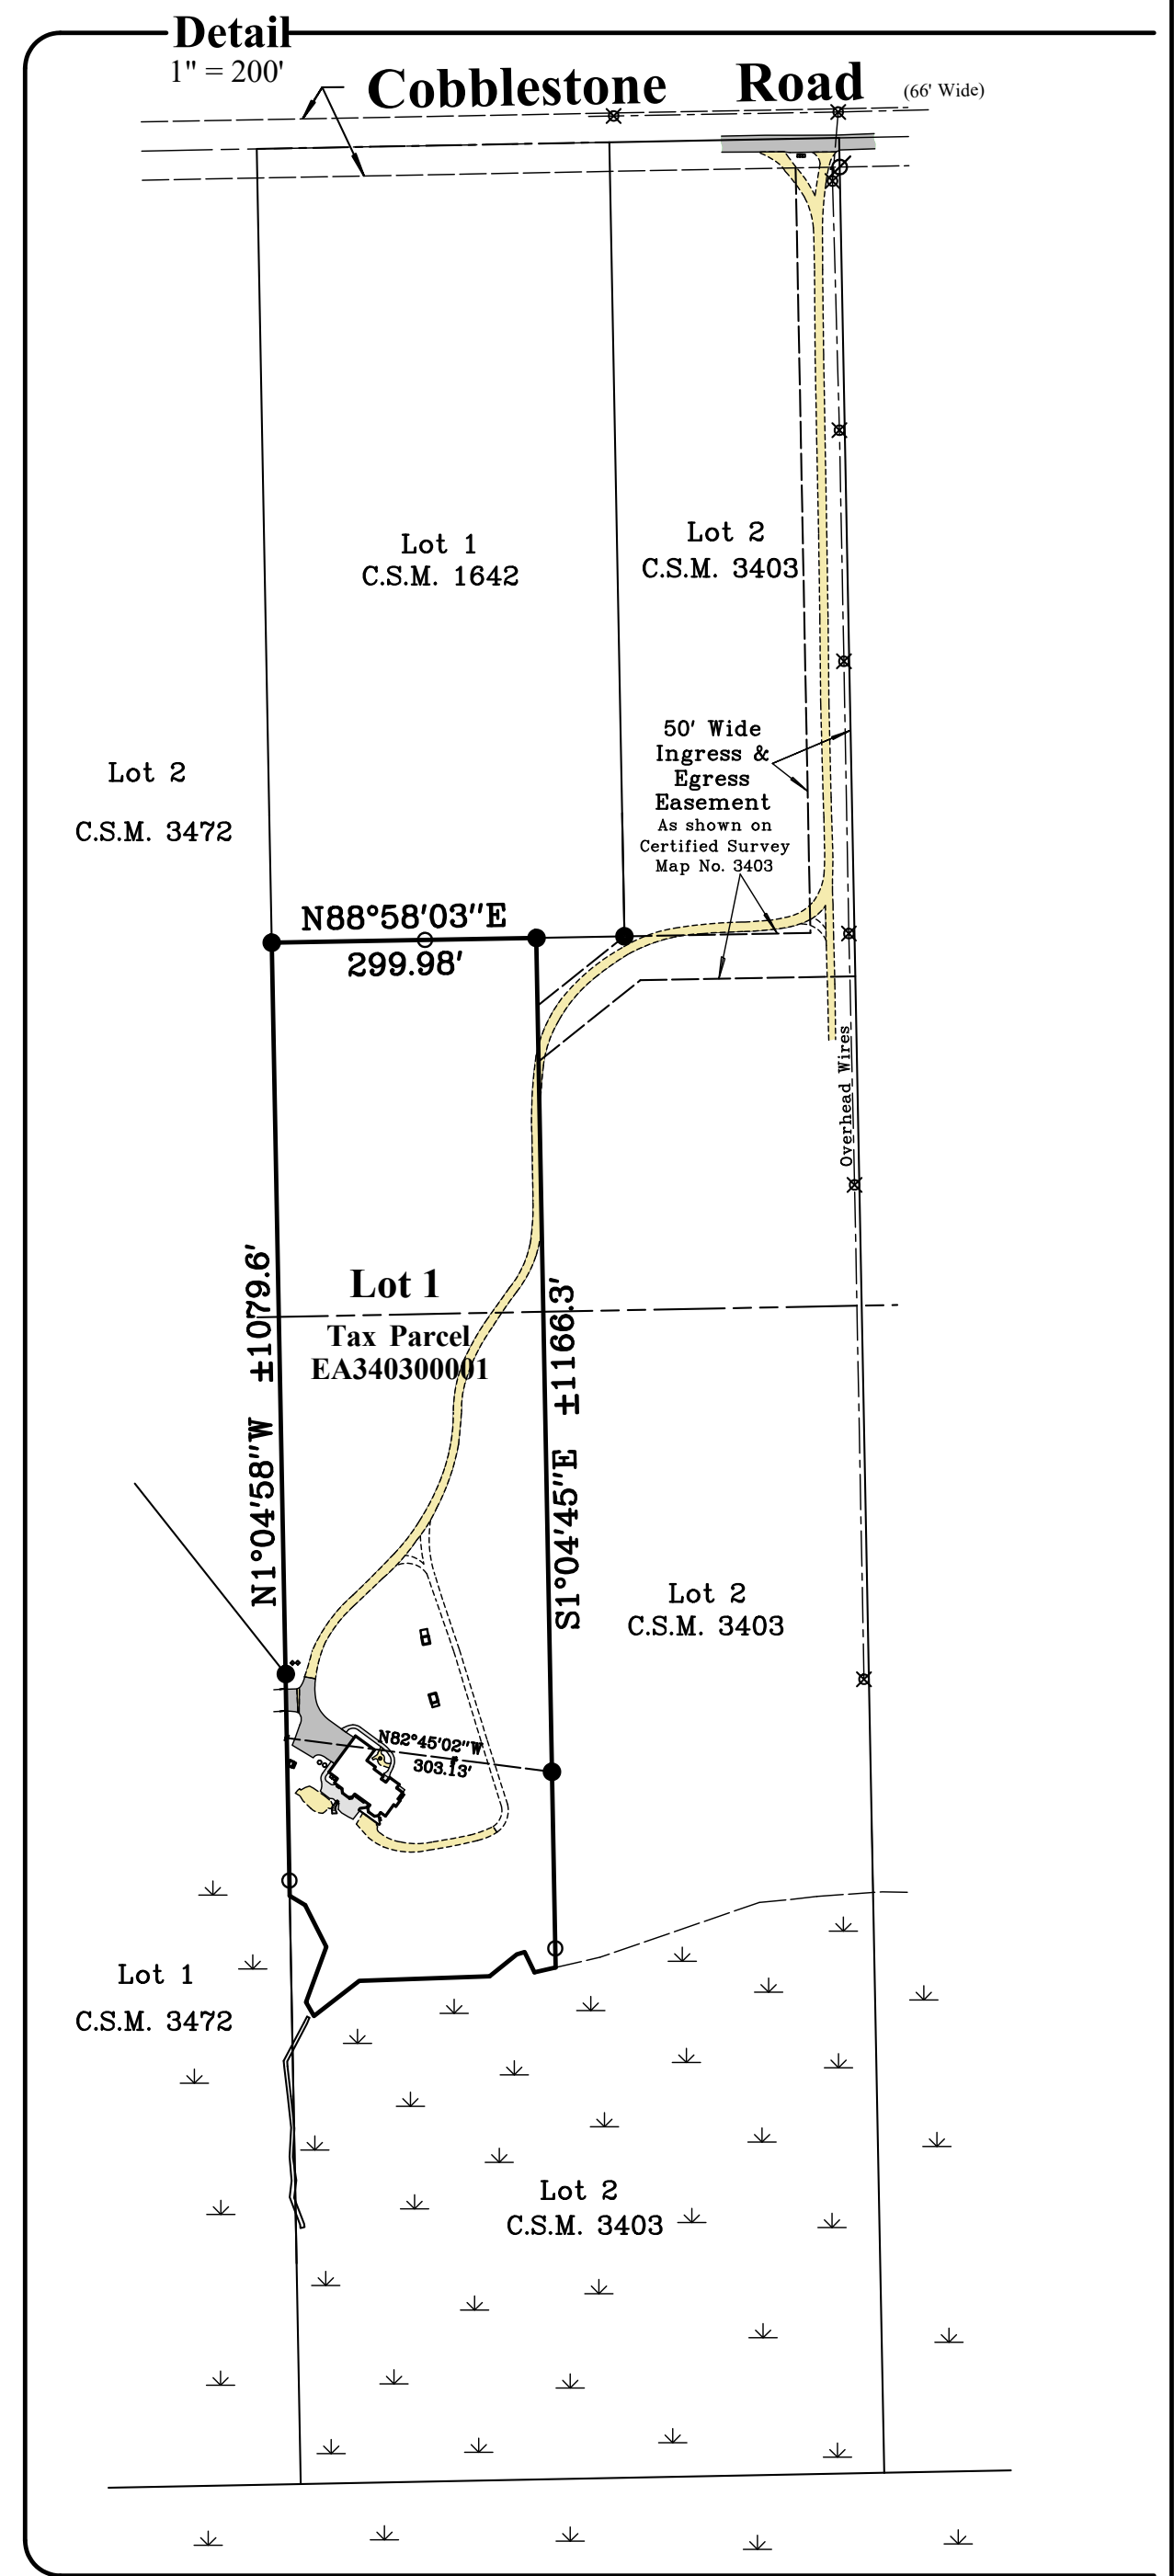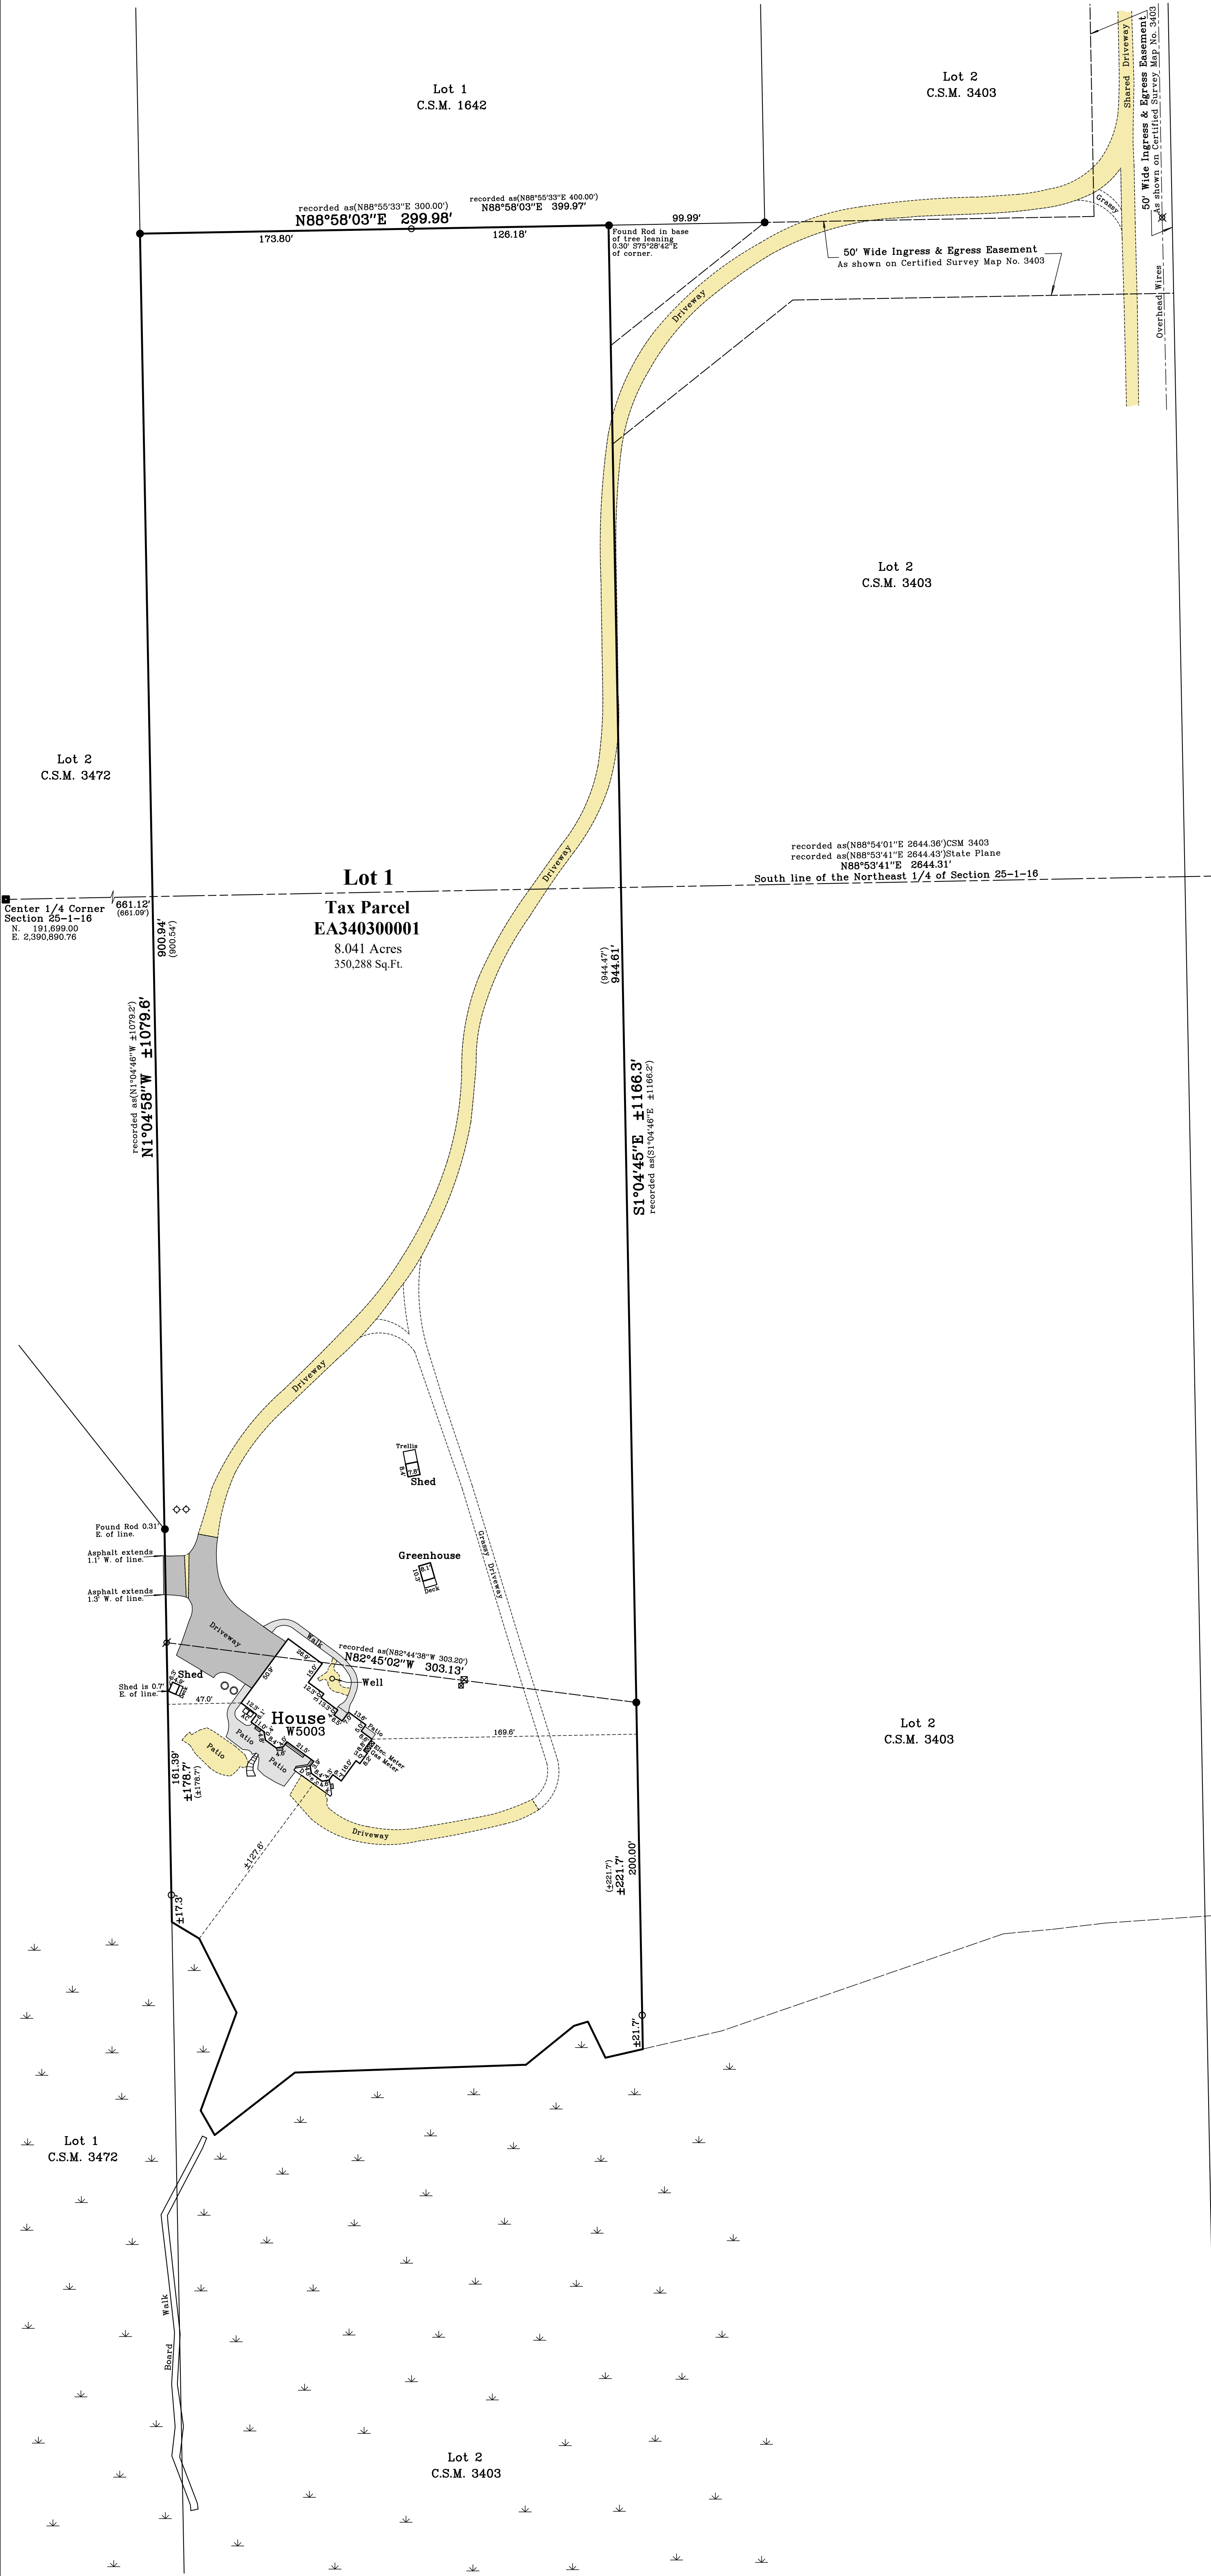

**Notes:**

- 1) This Plat of Survey is not certified unless signed and sealed in red ink.
- 2) This survey is subject to Wisconsin lien laws. This Plat of Survey is the notice of intent to file lien. Lien waiver required.
- 3) The Survey Date shown on this Plat of Survey is the completion date of the field work.

Copyright © 2023 by Olson Land Surveying, LLC.

All rights reserved. No part of this survey plat may be reproduced or transmitted in any form by any means - graphic, electronic, or mechanical, including photocopying, tracing, or information storage and retrieval systems - without permission in writing from Douglas G. Olson, Olson Land Surveying, LLC.

I hereby certify that I have surveyed the above described property in compliance with Chapter A-E 7 of the Wisconsin Administrative Code and that the map hereon is correct to the best of my professional knowledge and belief and shows the size and location of the property, its exterior boundaries, the location and dimensions of all visible structures thereon, boundary fences, apparent easements and roadways and visible encroachments, if any.

This survey is made for the exclusive use of the present owners of the property, and also those who purchase, mortgage or guarantee title thereto, within one year from the date hereof.


Douglas G. Olson  
Wisconsin Professional Land Surveyor - 2093

2023.033

Sheet 1 of 1 Sheets	
Drawing Name:	
Job Reference Number	2023.033
<b>Legend</b> of Symbols & Abbreviations ■ Found County Section Corner ● Found Iron Pipe ○ Found Iron Rod ( ) Recorded Information ⊗ Utility Pole ⊕ Utility Pedestal ○ Concrete Cover ⊕ Septic Vent ▨ Asphalt Surface ▨ Concrete Surface ▨ Gravel Surface ▨ Brick Pavers N North S South E East W West In Bearings ° Degrees ' Minutes " Seconds In Distances Feet " Inches No. Number NW Northwest NE Northeast Dia. Diameter	



45 South Wisconsin Street | P.O. Box 322  
Elkhorn, Wisconsin, 53121  
Telephone: (262) 723-3434  
Facsimile: (262) 723-8044  
Email: doug@olsonsurveying.com  
Website: www.olsonsurveying.com

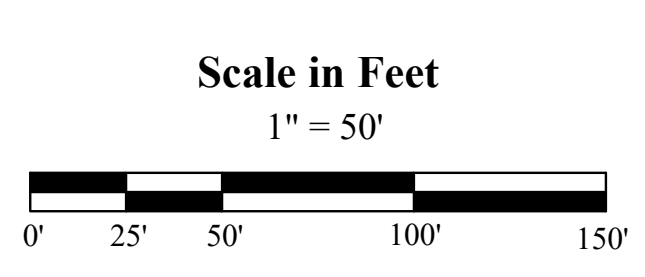

Survey date: September 27, 2023.  
Revisions: No. 1 - Detail