


Northwest corner of the East 1/4
of the Southeast 1/4 of Sec. 7-1-16.

DUNHAM SURVEYING, S.C.
SURVEYING & SUBDIVIDING
DELAVAN, WISCONSIN 53115

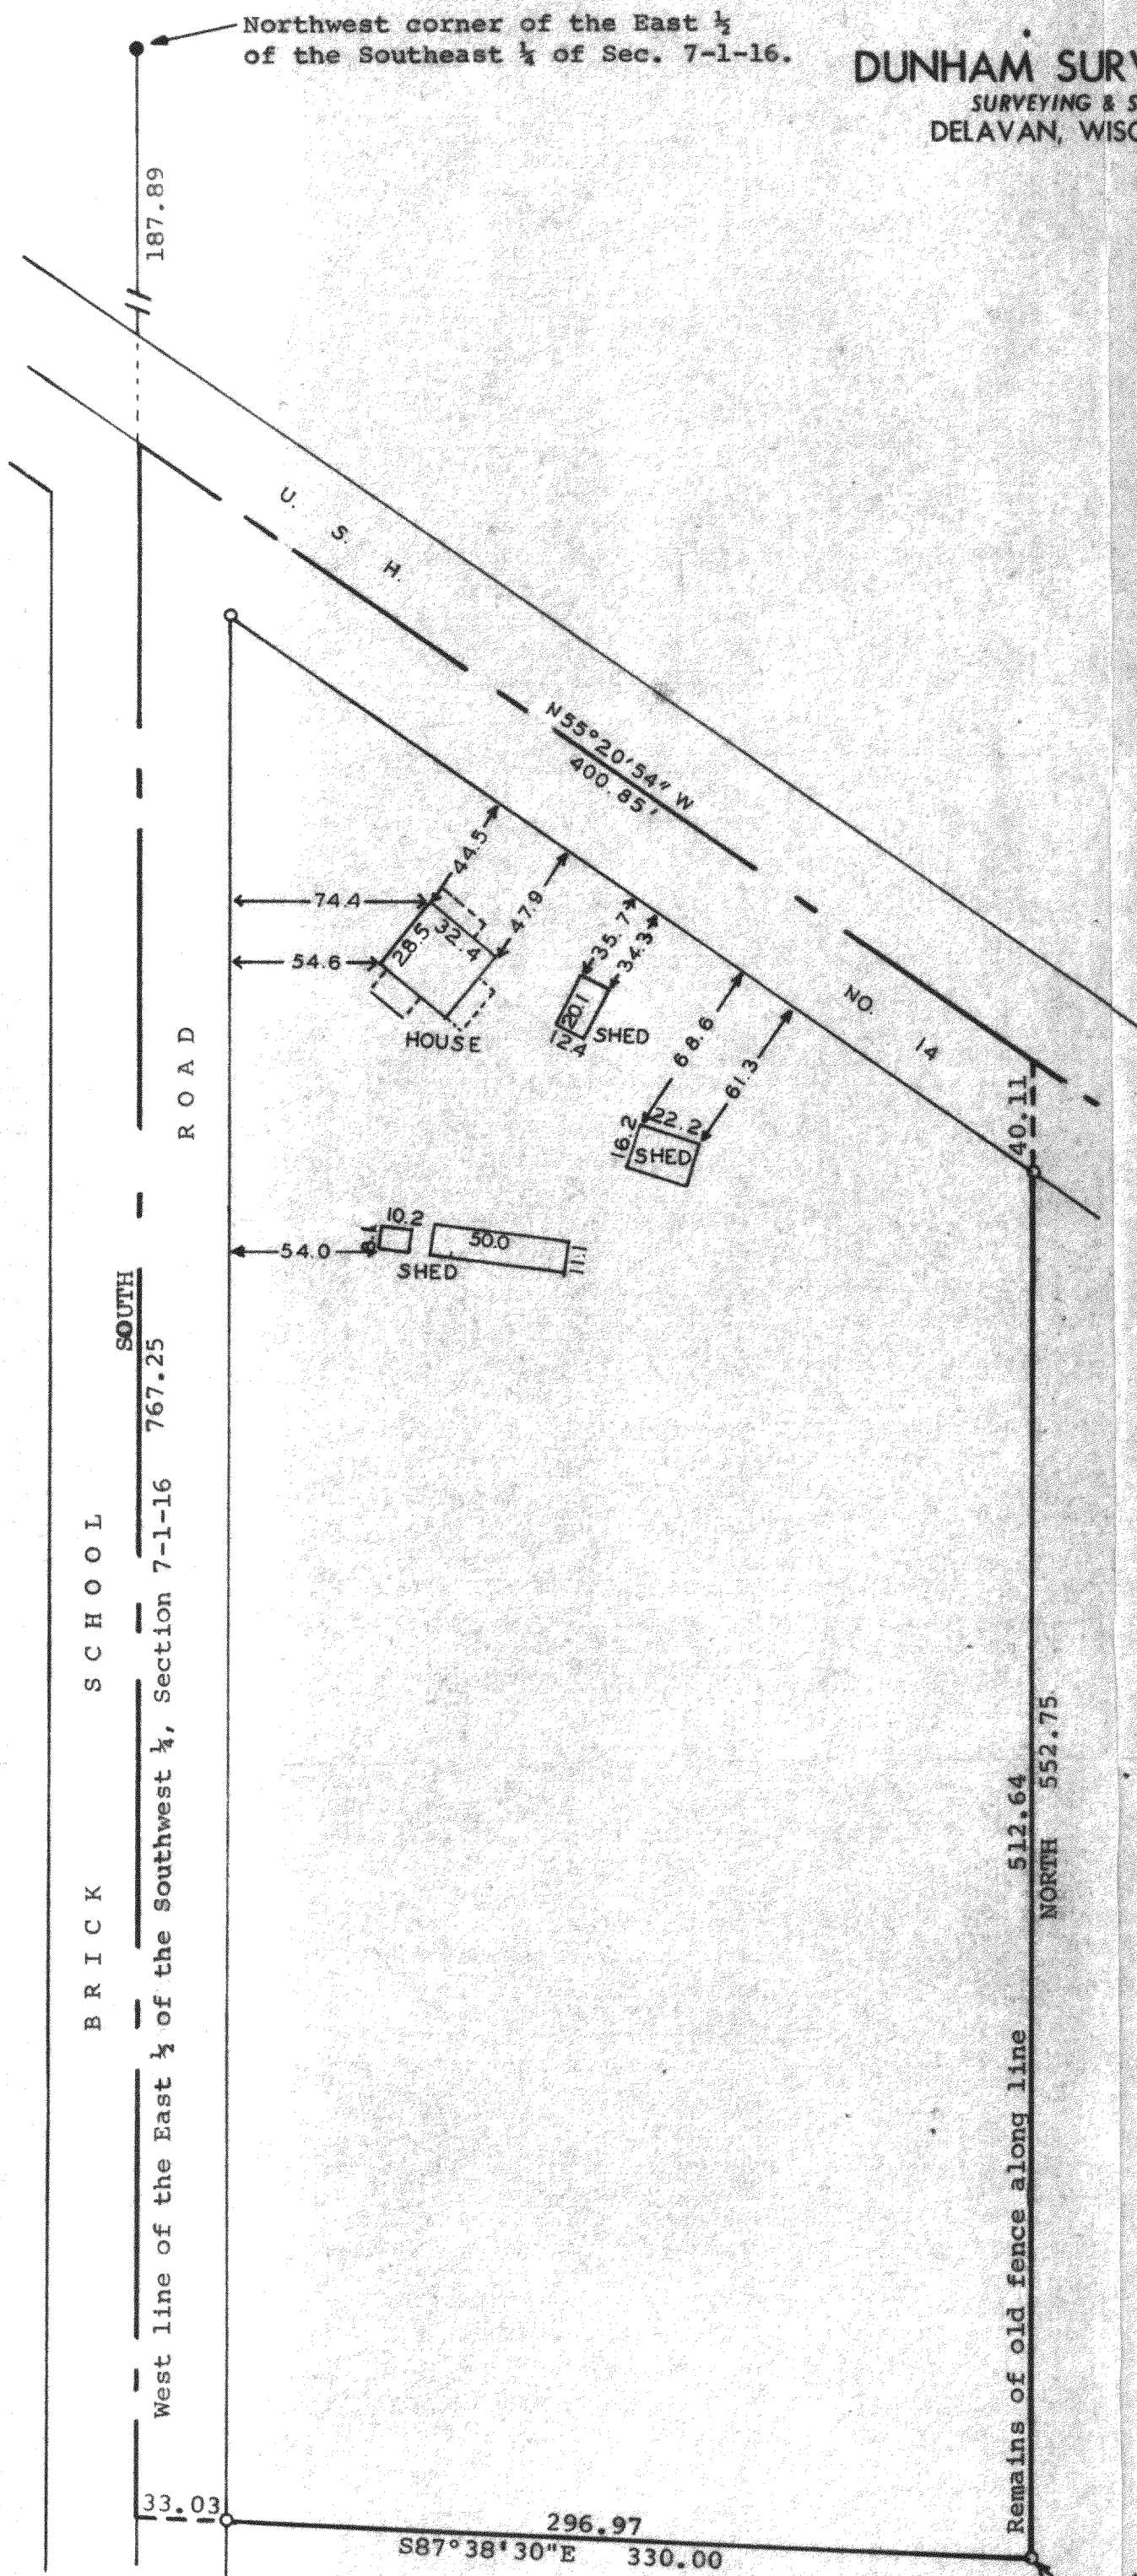

Scale - 1" = 60'
o = Iron Pipe
• = Concrete Monument


STATE OF WISCONSIN) SS
COUNTY OF WALWORTH)

I, George T. Dunham, Surveyor, certify that I have surveyed
the property described as follows,

A parcel of land located in the E 1/4 of the SE 1/4 of Sec. 7, T1N,
R16E, Walworth County, Wisconsin, described as follows:
Beginning at the intersection of the Centerline of
U. S. Highway No. 14 and the West line of said East 1/4;
thence South along said West line, 767.25 feet; thence
S87°38'30"E, 330.00 feet; thence North parallel with
the West line of said East 1/4, 552.75 feet to the center-
line of U. S. Highway No. 14; thence N55°20'54"W along
said centerline 400.85 feet to the place of beginning,
containing 5.00 acres of land.

and that the above map is a true representation thereon and shows
the location and size of the property, its exterior boundaries,
the location of all visible structures and dimensions of all
principal buildings thereon, boundary fences, apparent easements,
roadways and visible encroachments, if any.
This survey is made for the use of the present owners of the property,
and also those who purchase, mortgage, or guarantee the title
thereto within one (1) year from date hereof.
February 22, 1979

George T. Dunham
George T. Dunham, Surveyor

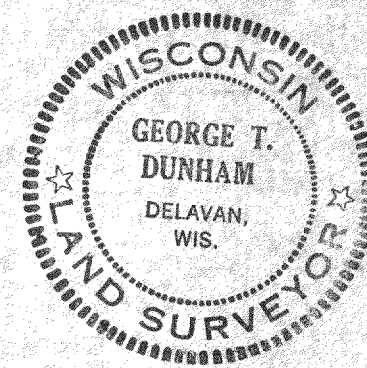

4.7' North of
old fence corner.

C S 1343