


ELKHORN, WI. 53121



PLAT OF SURVEY OF

CERTIFIED SURVEY NO. 554, LOCATED IN THE
S.E. 1/4 OF SECTION 23, T1N, R16E,
WALWORTH COUNTY, WISCONSIN.

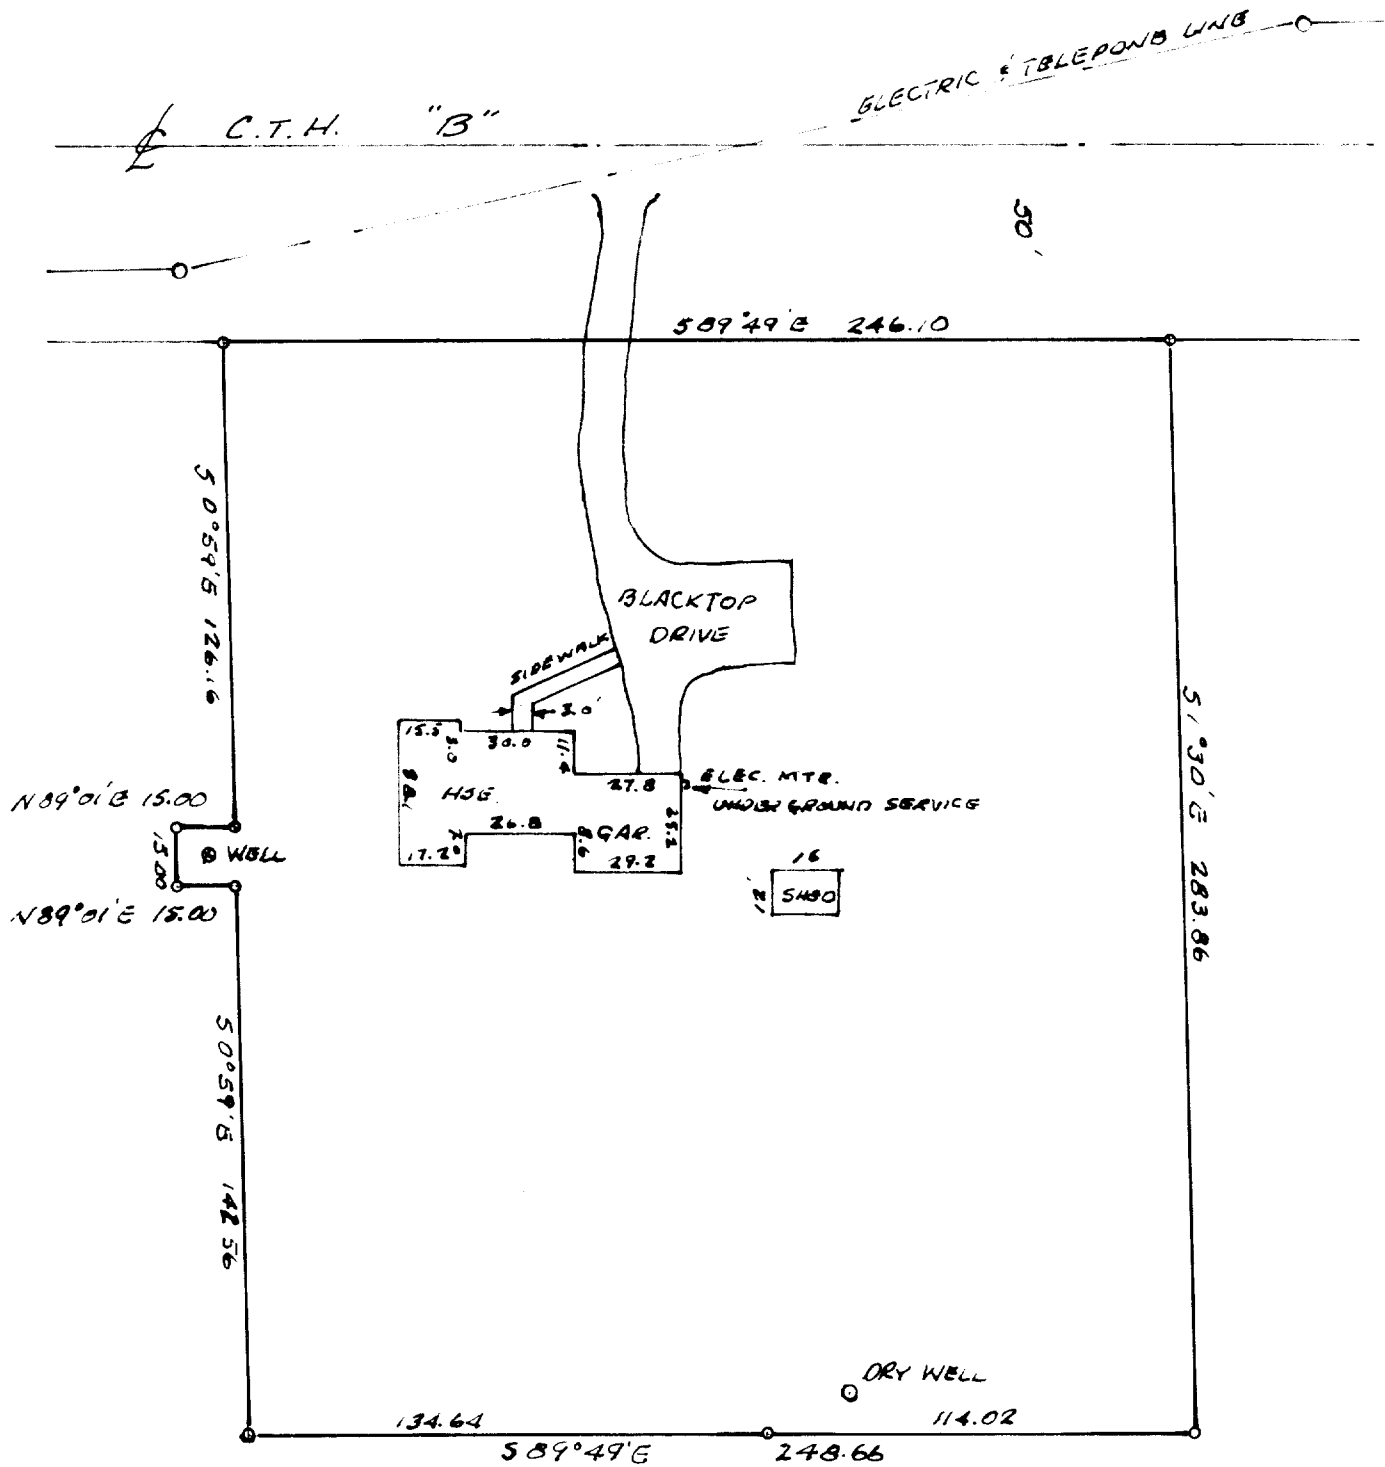

SCALE - 1" = 50'

0-IRON PIPB FOUND

SURVEYED FOR: RAULAND AGENCY
WALWORTH, WI.

I HEREBY CERTIFY THAT I HAVE SURVEYED THE ABOVE DESCRIBED PROPERTY, THAT THE PLAT SHOWN HEREON IS AN ACCURATE SURVEY, A TRUE REPRESENTATION THEREOF, CORRECTLY SHOWS THE EXTERIOR BOUNDARY LINES ON SAID PROPERTY AND THE CORRECT MEASUREMENTS THEREOF AND ALL BUILDINGS THEREON.

THOMAS P. A. JENSEN, RLS 1084

DATE: JULY 28, 1983

C.S.M. 554

116-175-J

1923.040