

SEP 30 1985


KOLB LAND CONSULTING, INC.
LAND SURVEYING • SUBDIVIDING • LAND PLANNING

929 WILLIAMS STREET

LAKE GENEVA, WISCONSIN 53147

414-248-3697

LAKE AVENUE

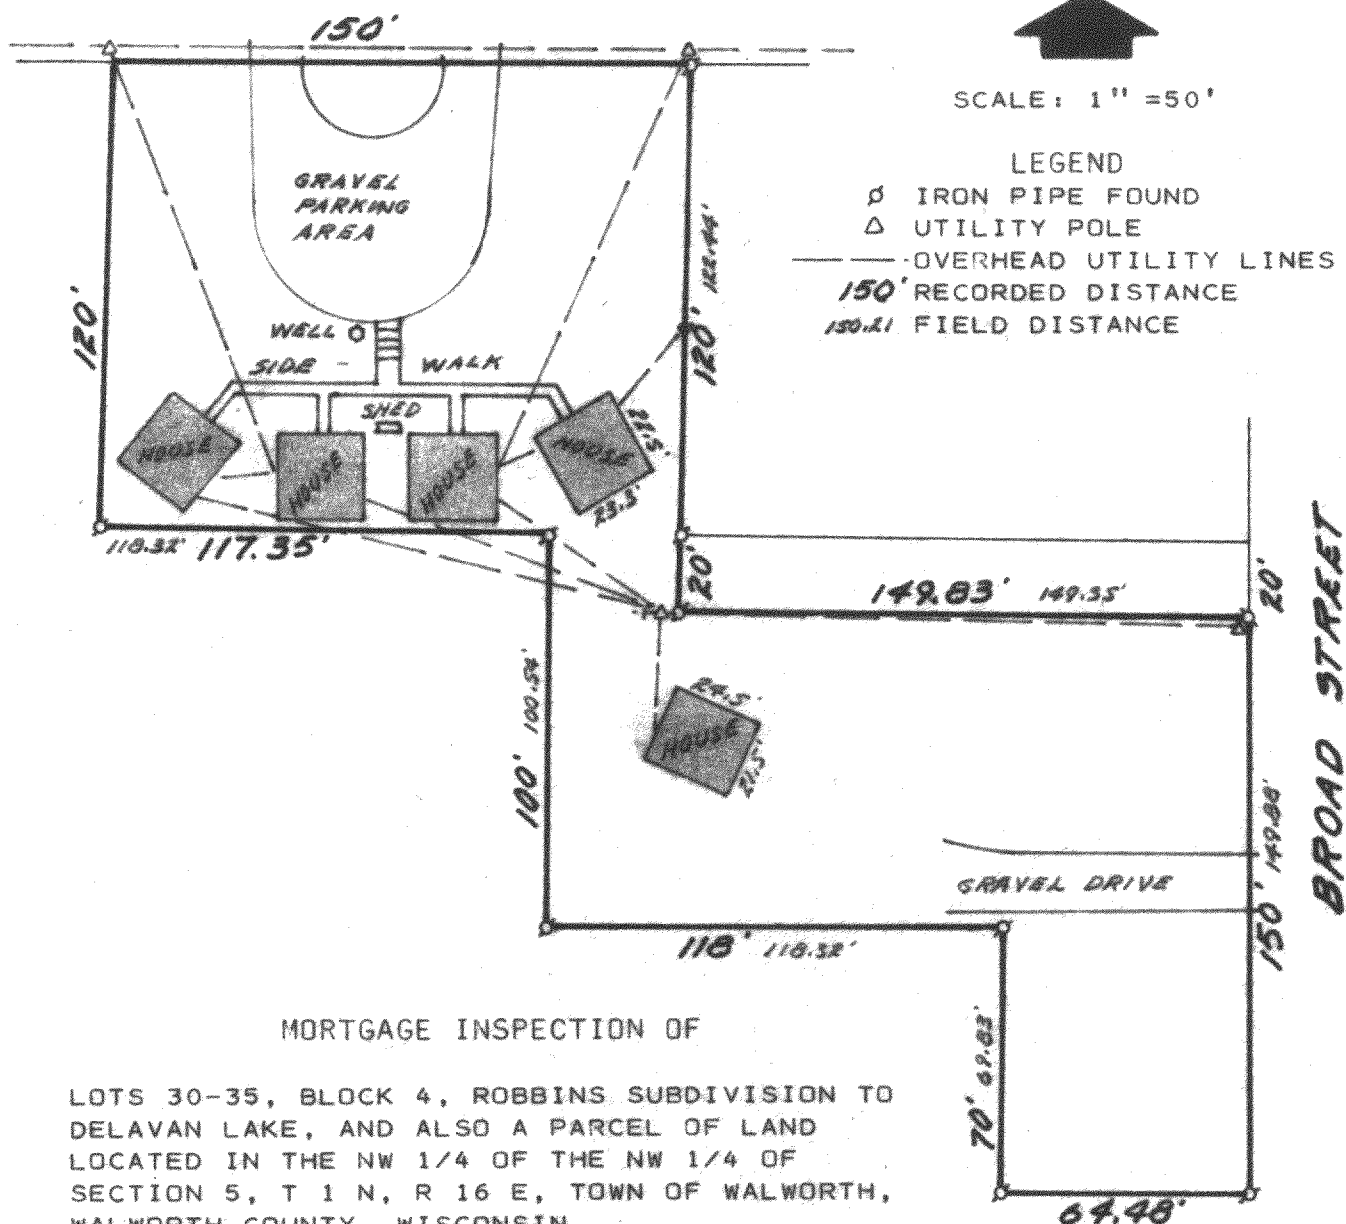

MORTGAGE INSPECTION OF

LOTS 30-35, BLOCK 4, ROBBINS SUBDIVISION TO
DELANVAN LAKE, AND ALSO A PARCEL OF LAND
LOCATED IN THE NW 1/4 OF THE NW 1/4 OF
SECTION 5, T 1 N, R 16 E, TOWN OF WALWORTH,
WALWORTH COUNTY, WISCONSIN.
TAX PARCELS: W-5-16B & ER-14

ORDERED BY: ANCHOR SAVINGS & LOAN ASSOC-
IATION
500 E. WALWORTH AVE.
DELAVER, WI. 53115

OWNER: GERALD DOEBEL
3101 MISSOURI AVE.
LAS CRUCES, NM. 88001

NOTE: COMPLIANCE WITH A-E 3, 5(F), 6(A), (B), (C), (D) AND 7 HAS BEEN WAIVED BY THE CLIENT, IN AGREEMENT WITH THE SURVEYOR AS PERMITTED IN A-E 5.01(B).

Harold H. Holt

HAROLD H. KOLB

WISCONSIN REGISTERED LAND SURVEYOR, S-187

DATE APRIL 24, 1985

REVISÉ

REVISÉD

Key No. ER-00014

116-195v