


KOLB LAND CONSULTING, INC.
LAND SURVEYING • SUBDIVIDING • LAND PLANNING

LAKE GENEVA, WISCONSIN 53147

WHITEWATER, WISCONSIN 53190

LOT 1
9.174 ACRES

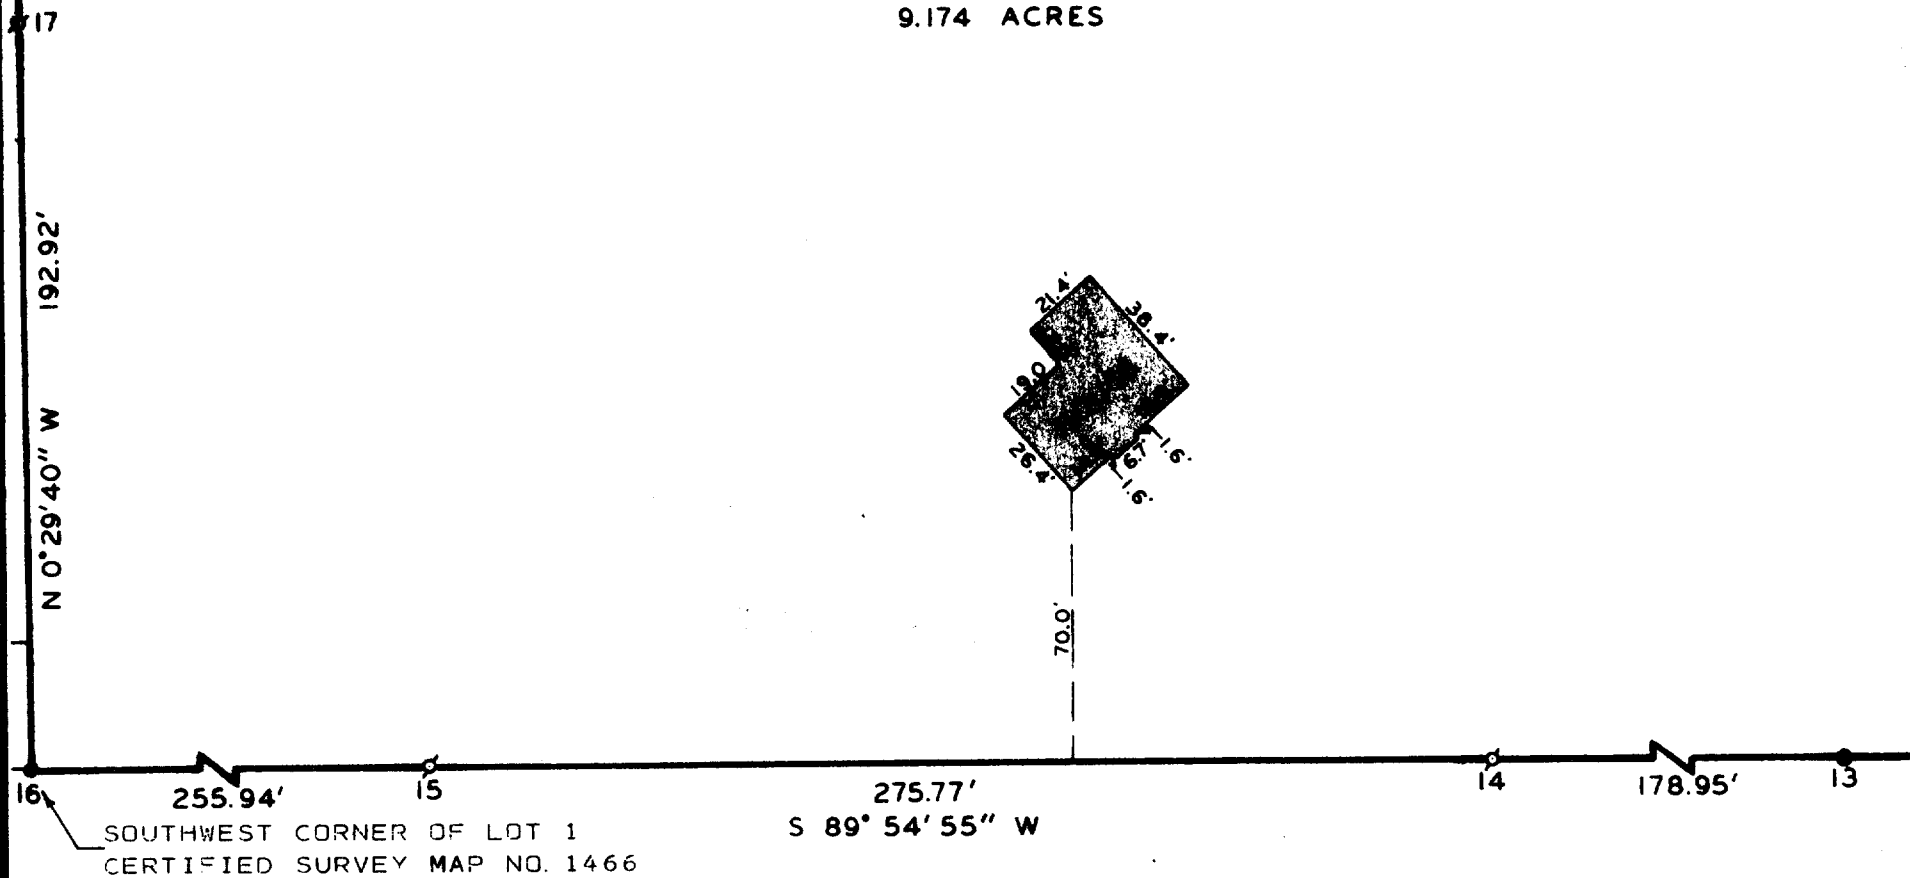


HOUSE LOCATION ON

LOT 1 OF CERTIFIED SURVEY MAP NO 1466, LOCATED IN THE NORTHWEST 1/4
OF SECTION 11, T 1 N, R 16 E, TOWN OF WALWORTH, WALWORTH COUNTY, WIS.

ORDERED BY: HOME DESIGN MFG.
P.O. BOX 126
FONTANA, WI 53125

NOTE: REFER TO CERTIFIED SURVEY MAP NO. 1466
FOR LOT CORNER NUMBERS.

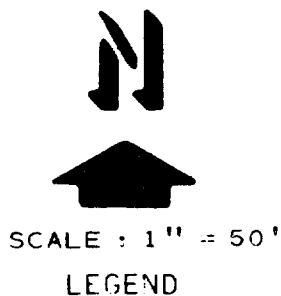

- - IRON PIPE FOUND
- - CONCRETE MONUMENT FOUND (5" DIA.)



I, HAROLD H. KOLB, DO HEREBY CERTIFY
THAT I HAVE SURVEYED THE PROPERTY HEREON
DESCRIBED ACCORDING TO THE OFFICIAL
RECORDS, AND THAT THE PLAT HEREON IS A
CORRECT REPRESENTATION OF THE LOT LINES
AND PRINCIPAL LINES OF THE BUILDINGS
THEREON TO THE BEST OF MY KNOWLEDGE AND
BELIEF.

HAROLD H. KOLB
WISCONSIN REGISTERED LAND SURVEYOR, S-187
DATE JANUARY 21, 1988