


KOLB LAND CONSULTING, INC.
LAND SURVEYING • SUBDIVIDING • LAND PLANNING


LAKE GENEVA, WISCONSIN 53147

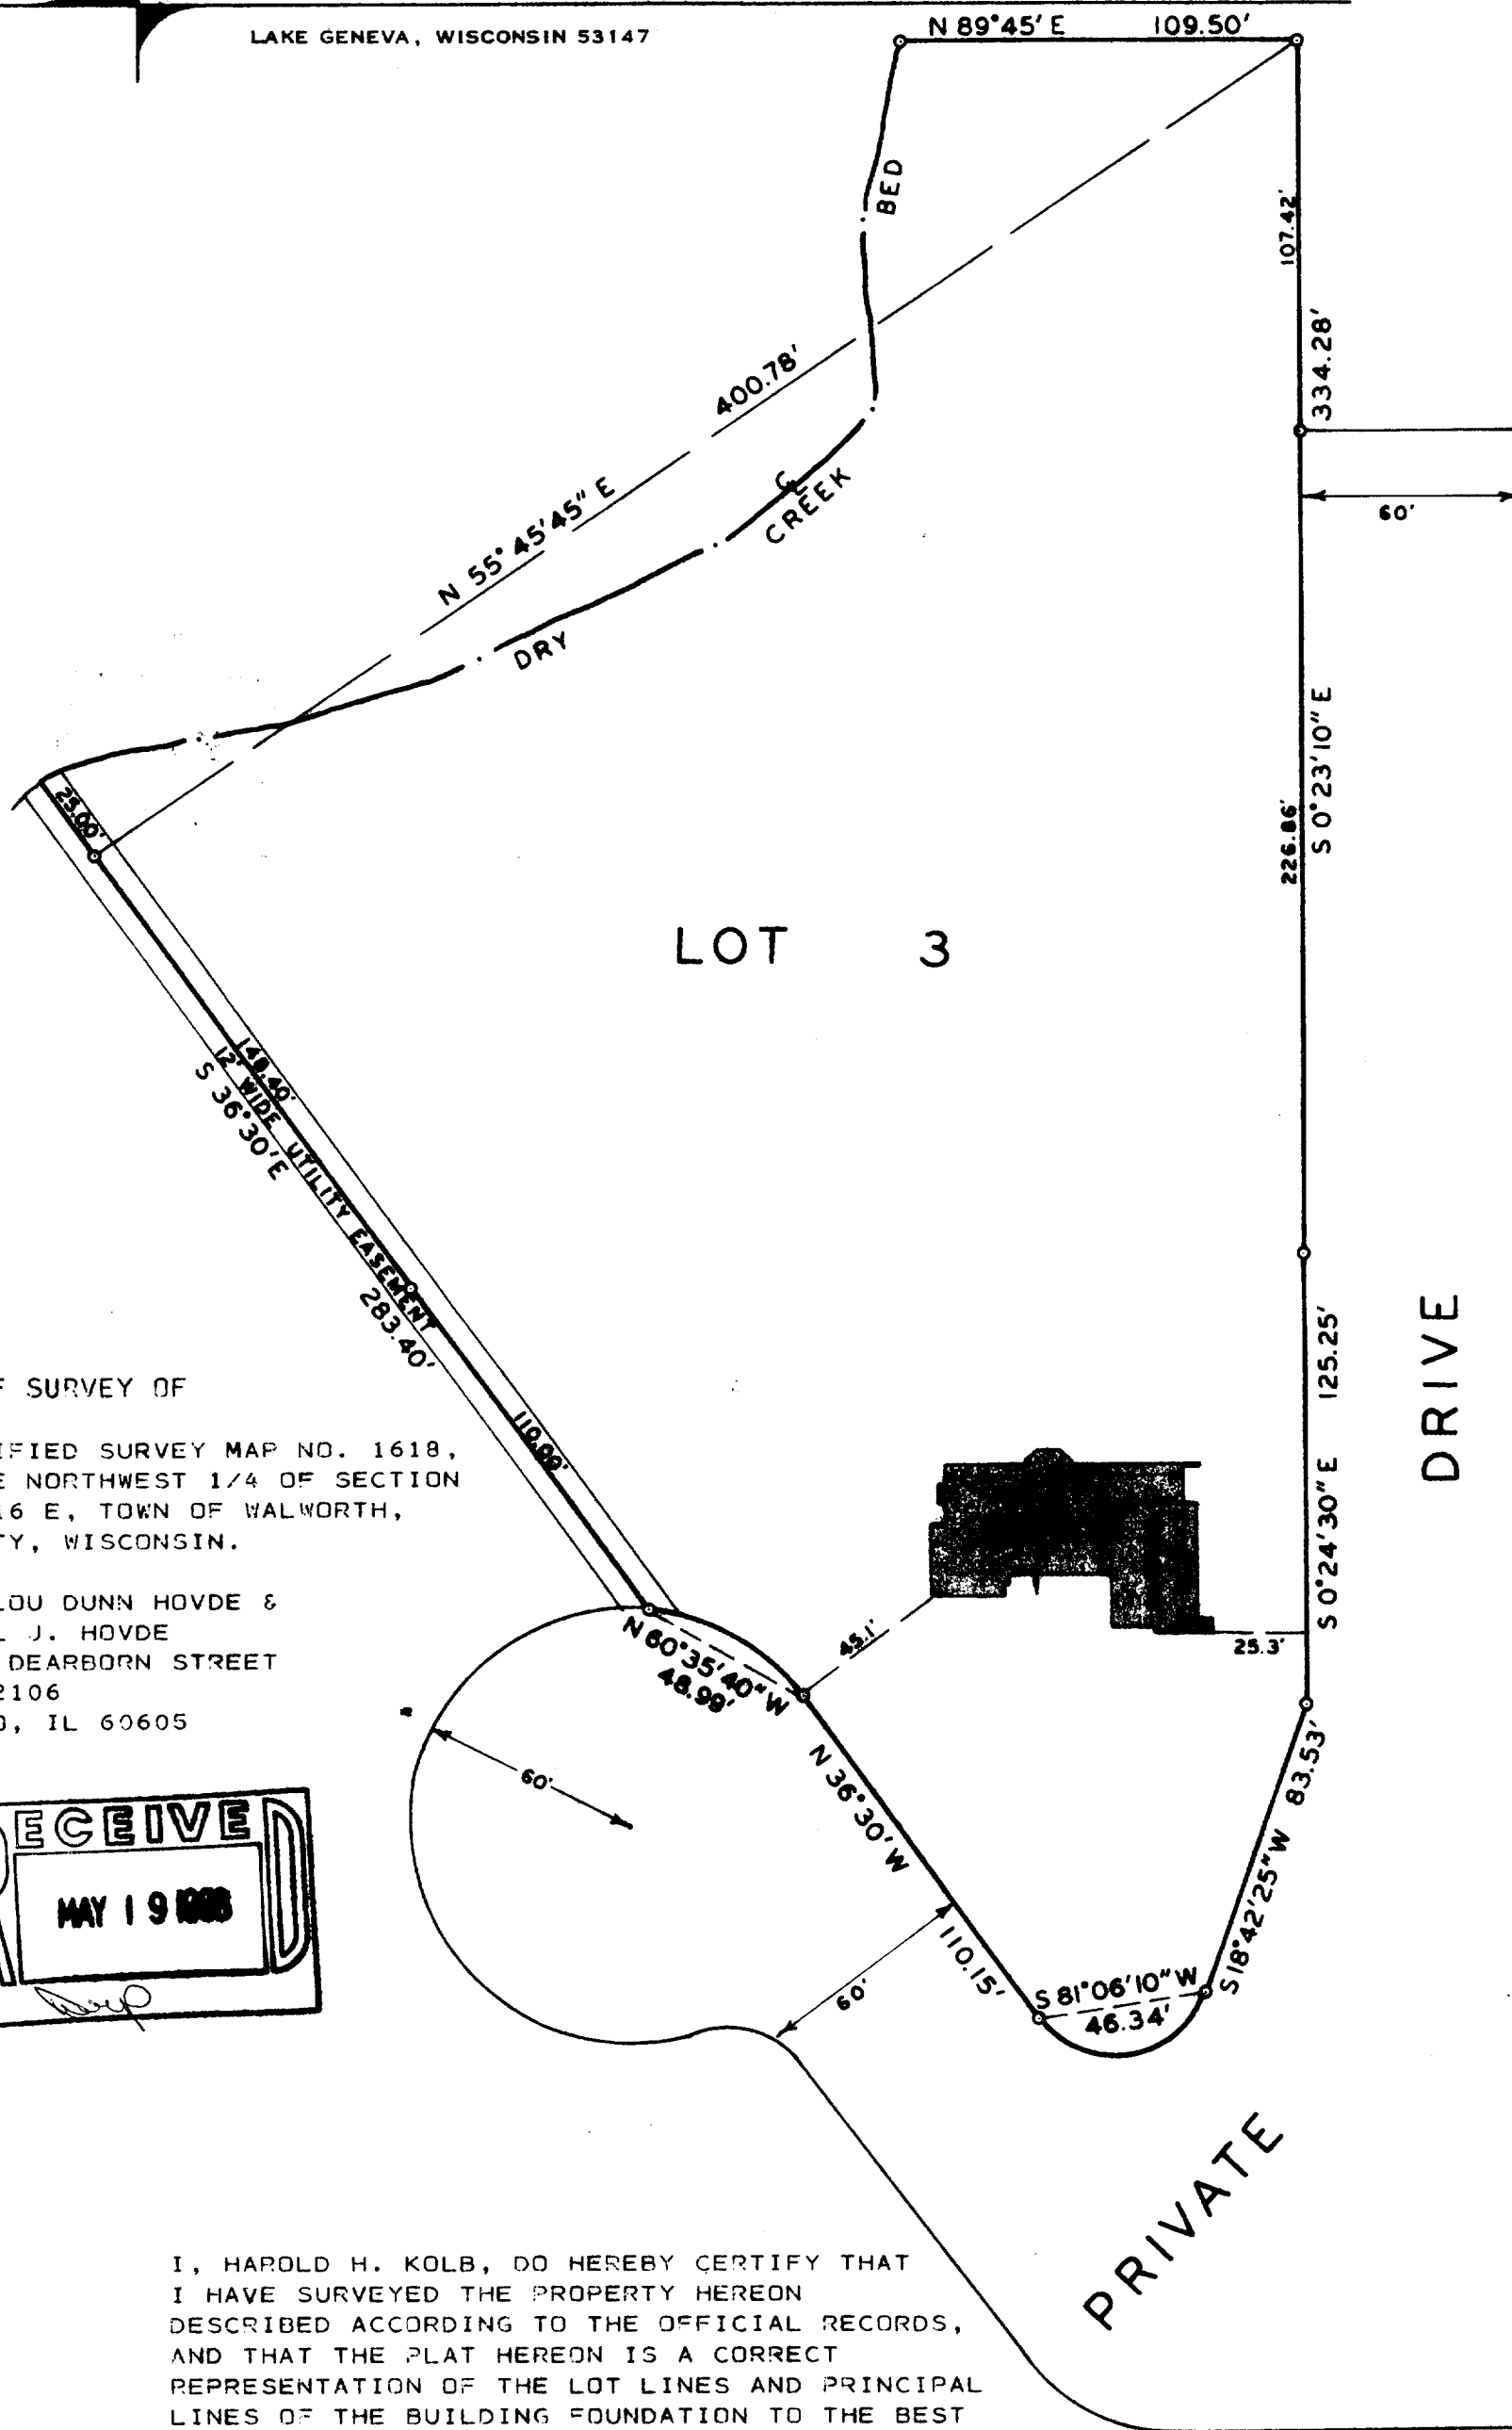

PLAT OF SURVEY OF

LOT 3 OF CERTIFIED SURVEY MAP NO. 1618,
LOCATED IN THE NORTHWEST 1/4 OF SECTION
11, T 1 N, R 16 E, TOWN OF WALWORTH,
WALWORTH COUNTY, WISCONSIN.

OWNER: BETTY LOU DUNN HOVDE &
RUSSELL J. HOVDE
600 S. DEARBORN STREET
APT. #2106
CHICAGO, IL 60605

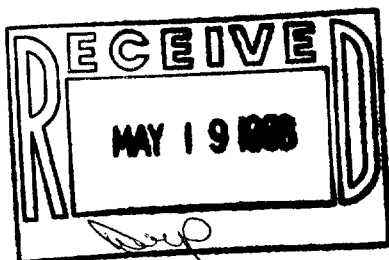

SCALE: 1" = 50'
LEGEND

o - IRON ROD FOUND

I, HAROLD H. KOLB, DO HEREBY CERTIFY THAT
I HAVE SURVEYED THE PROPERTY HEREON
DESCRIBED ACCORDING TO THE OFFICIAL RECORDS,
AND THAT THE PLAT HEREON IS A CORRECT
REPRESENTATION OF THE LOT LINES AND PRINCIPAL
LINES OF THE BUILDING FOUNDATION TO THE BEST
OF MY KNOWLEDGE AND BELIEF.
SURVEY NOT VALID UNLESS SURVEYOR'S SIGNATURE
IS IN RED.

HAROLD H. KOLB
WISCONSIN REGISTERED LAND SURVEYOR, S-187
DATE JANUARY 14, 1988