
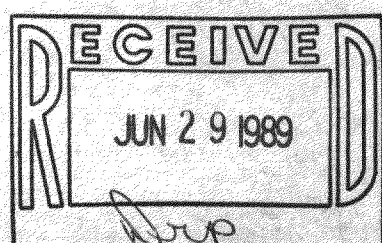


DUNHAM SURVEYING, S.C.
SURVEYING & SUBDIVIDING
DELAVER, WISCONSIN 53115

N

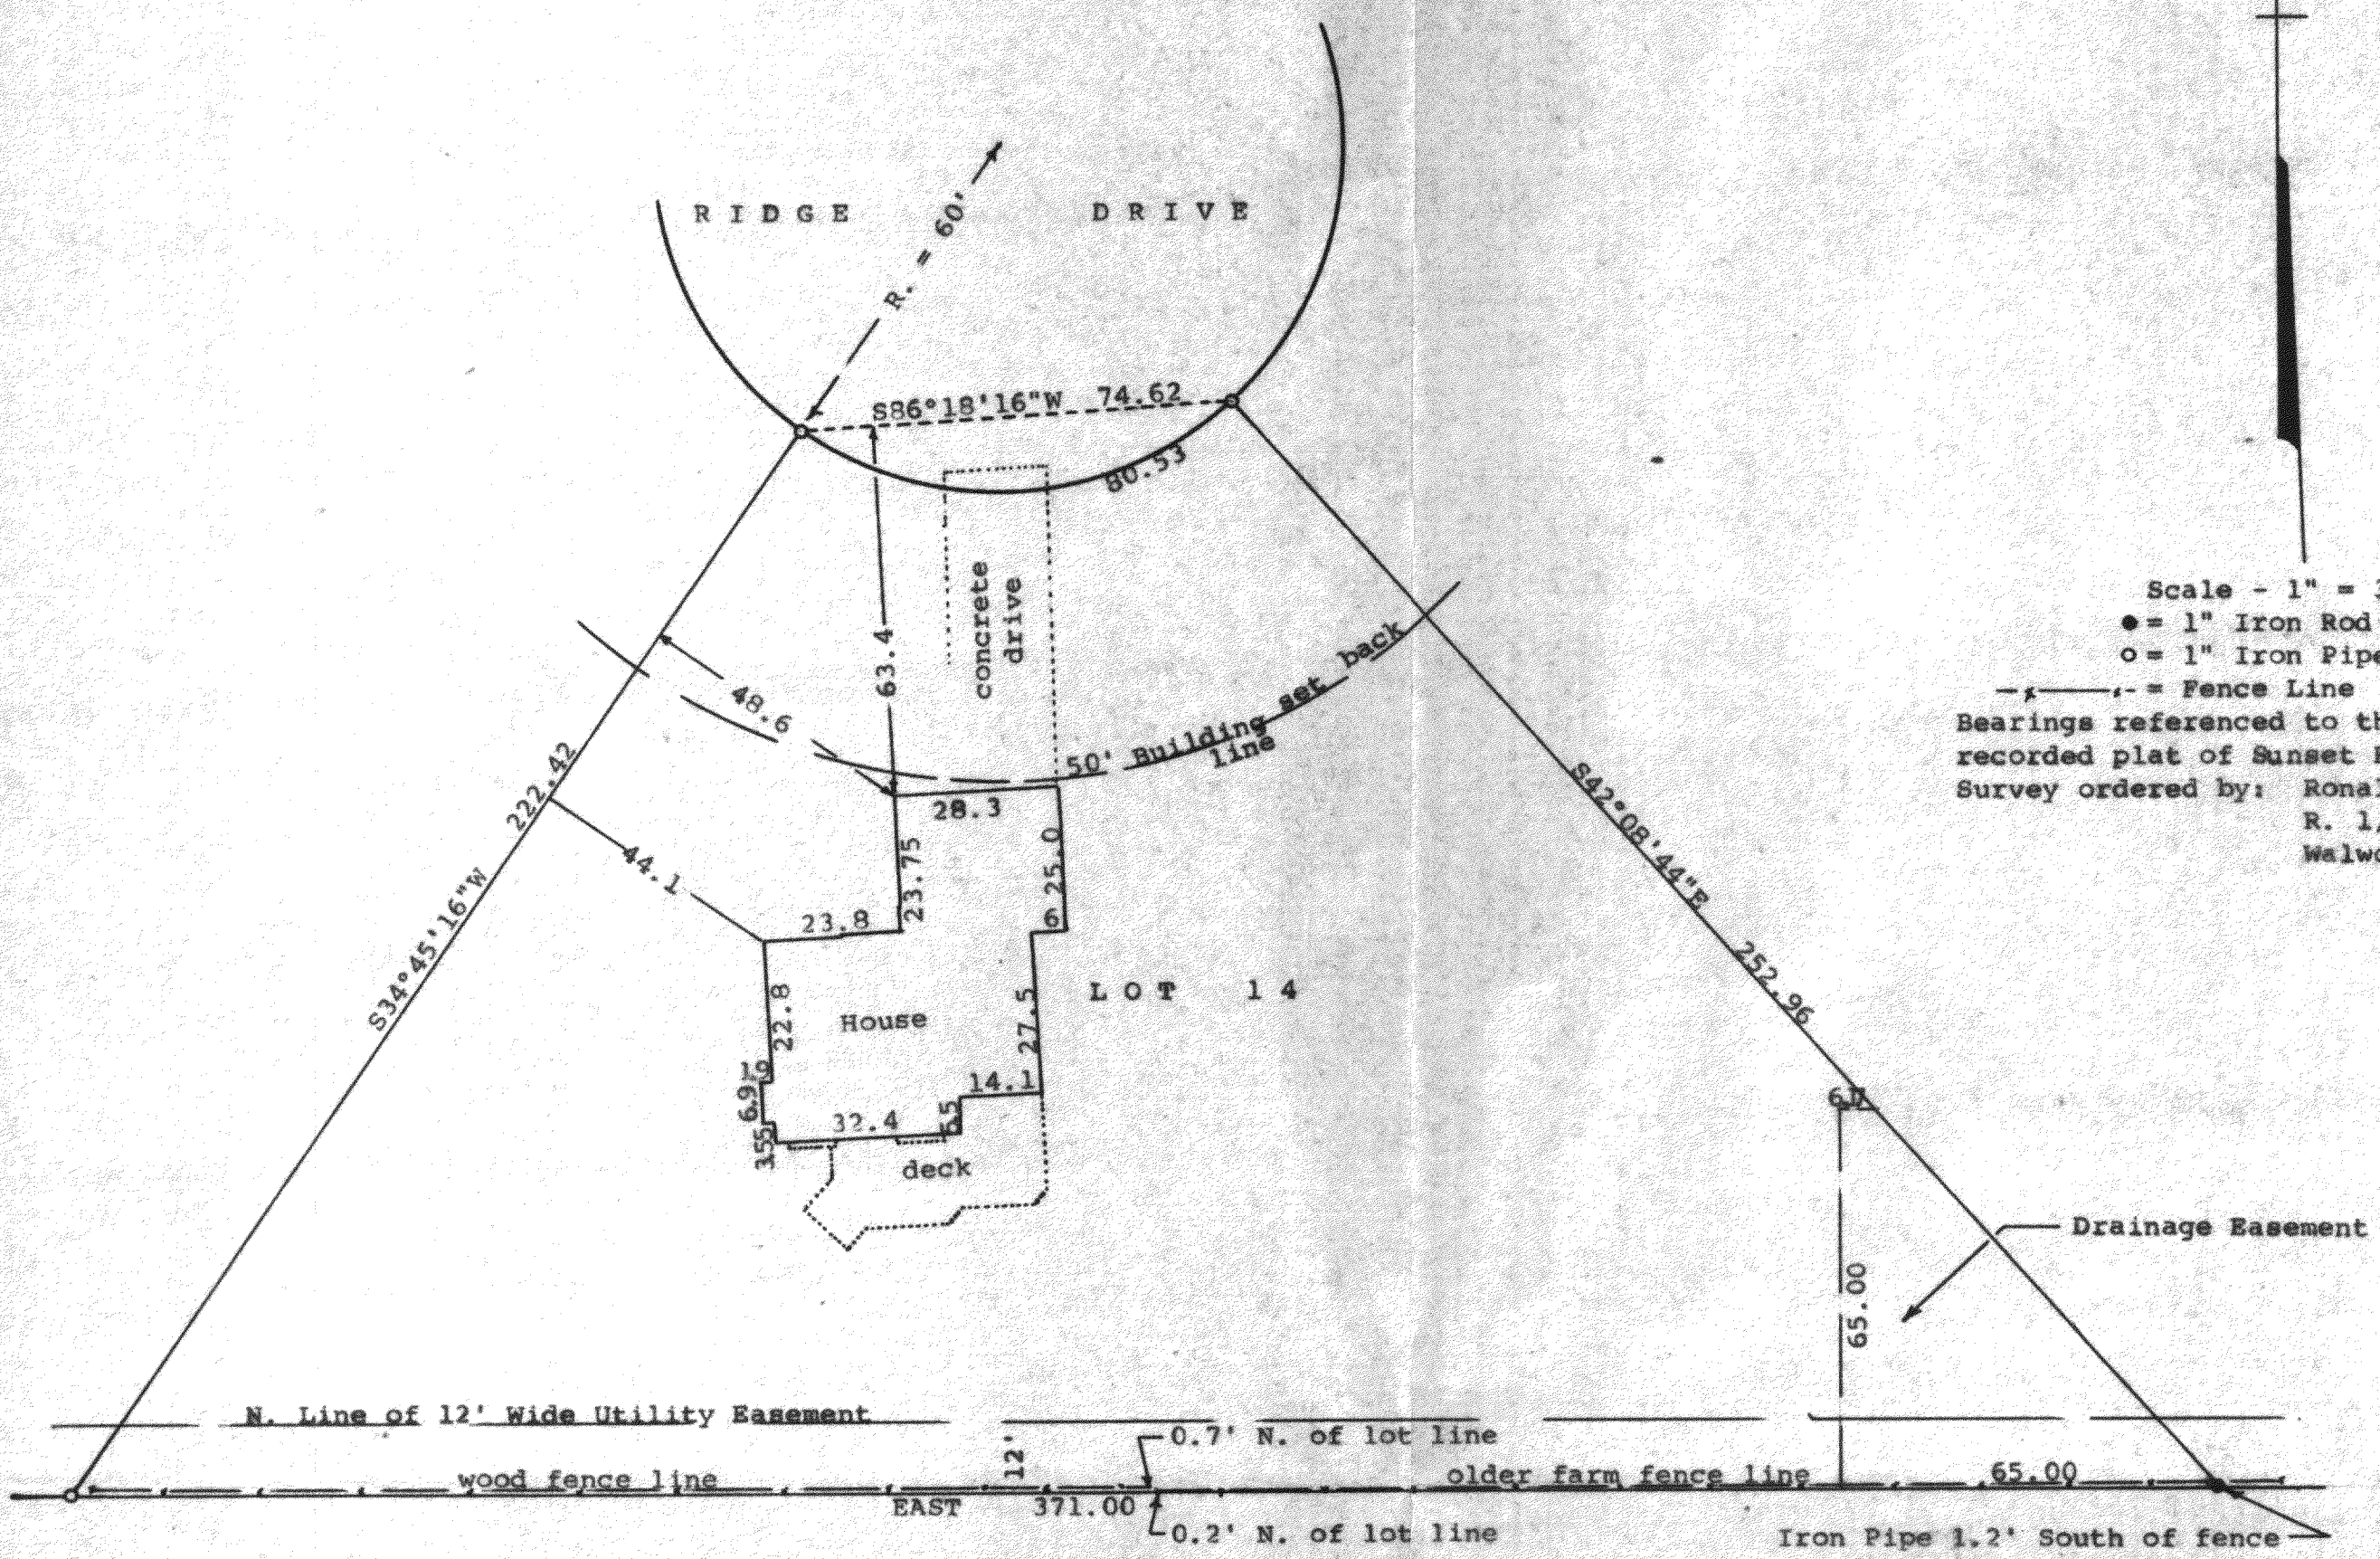

STATE OF WISCONSIN) SS
COUNTY OF WALWORTH)

I, George T. Dunham, Surveyor, certify that I have surveyed the property described as follows:

Lot 14 in Sunset Ridge - Unit 2, located in the NW $\frac{1}{4}$ of the NW $\frac{1}{4}$ of Section 11, T 1 N, R 16 E, Walworth County, Wisconsin and that the plat shown above is a correct representation thereof and shows the size and location of the property, its exterior boundaries, the location of all visible structures and dimensions of all principal buildings thereon, boundary fences, apparent easements, roadways and visible encroachments, if any, and that I have surveyed the property hereon described, according to the official records, to the best of my knowledge and belief.

November 9, 1988

116-264

George T. Dunham
George T. Dunham, Surveyor

