
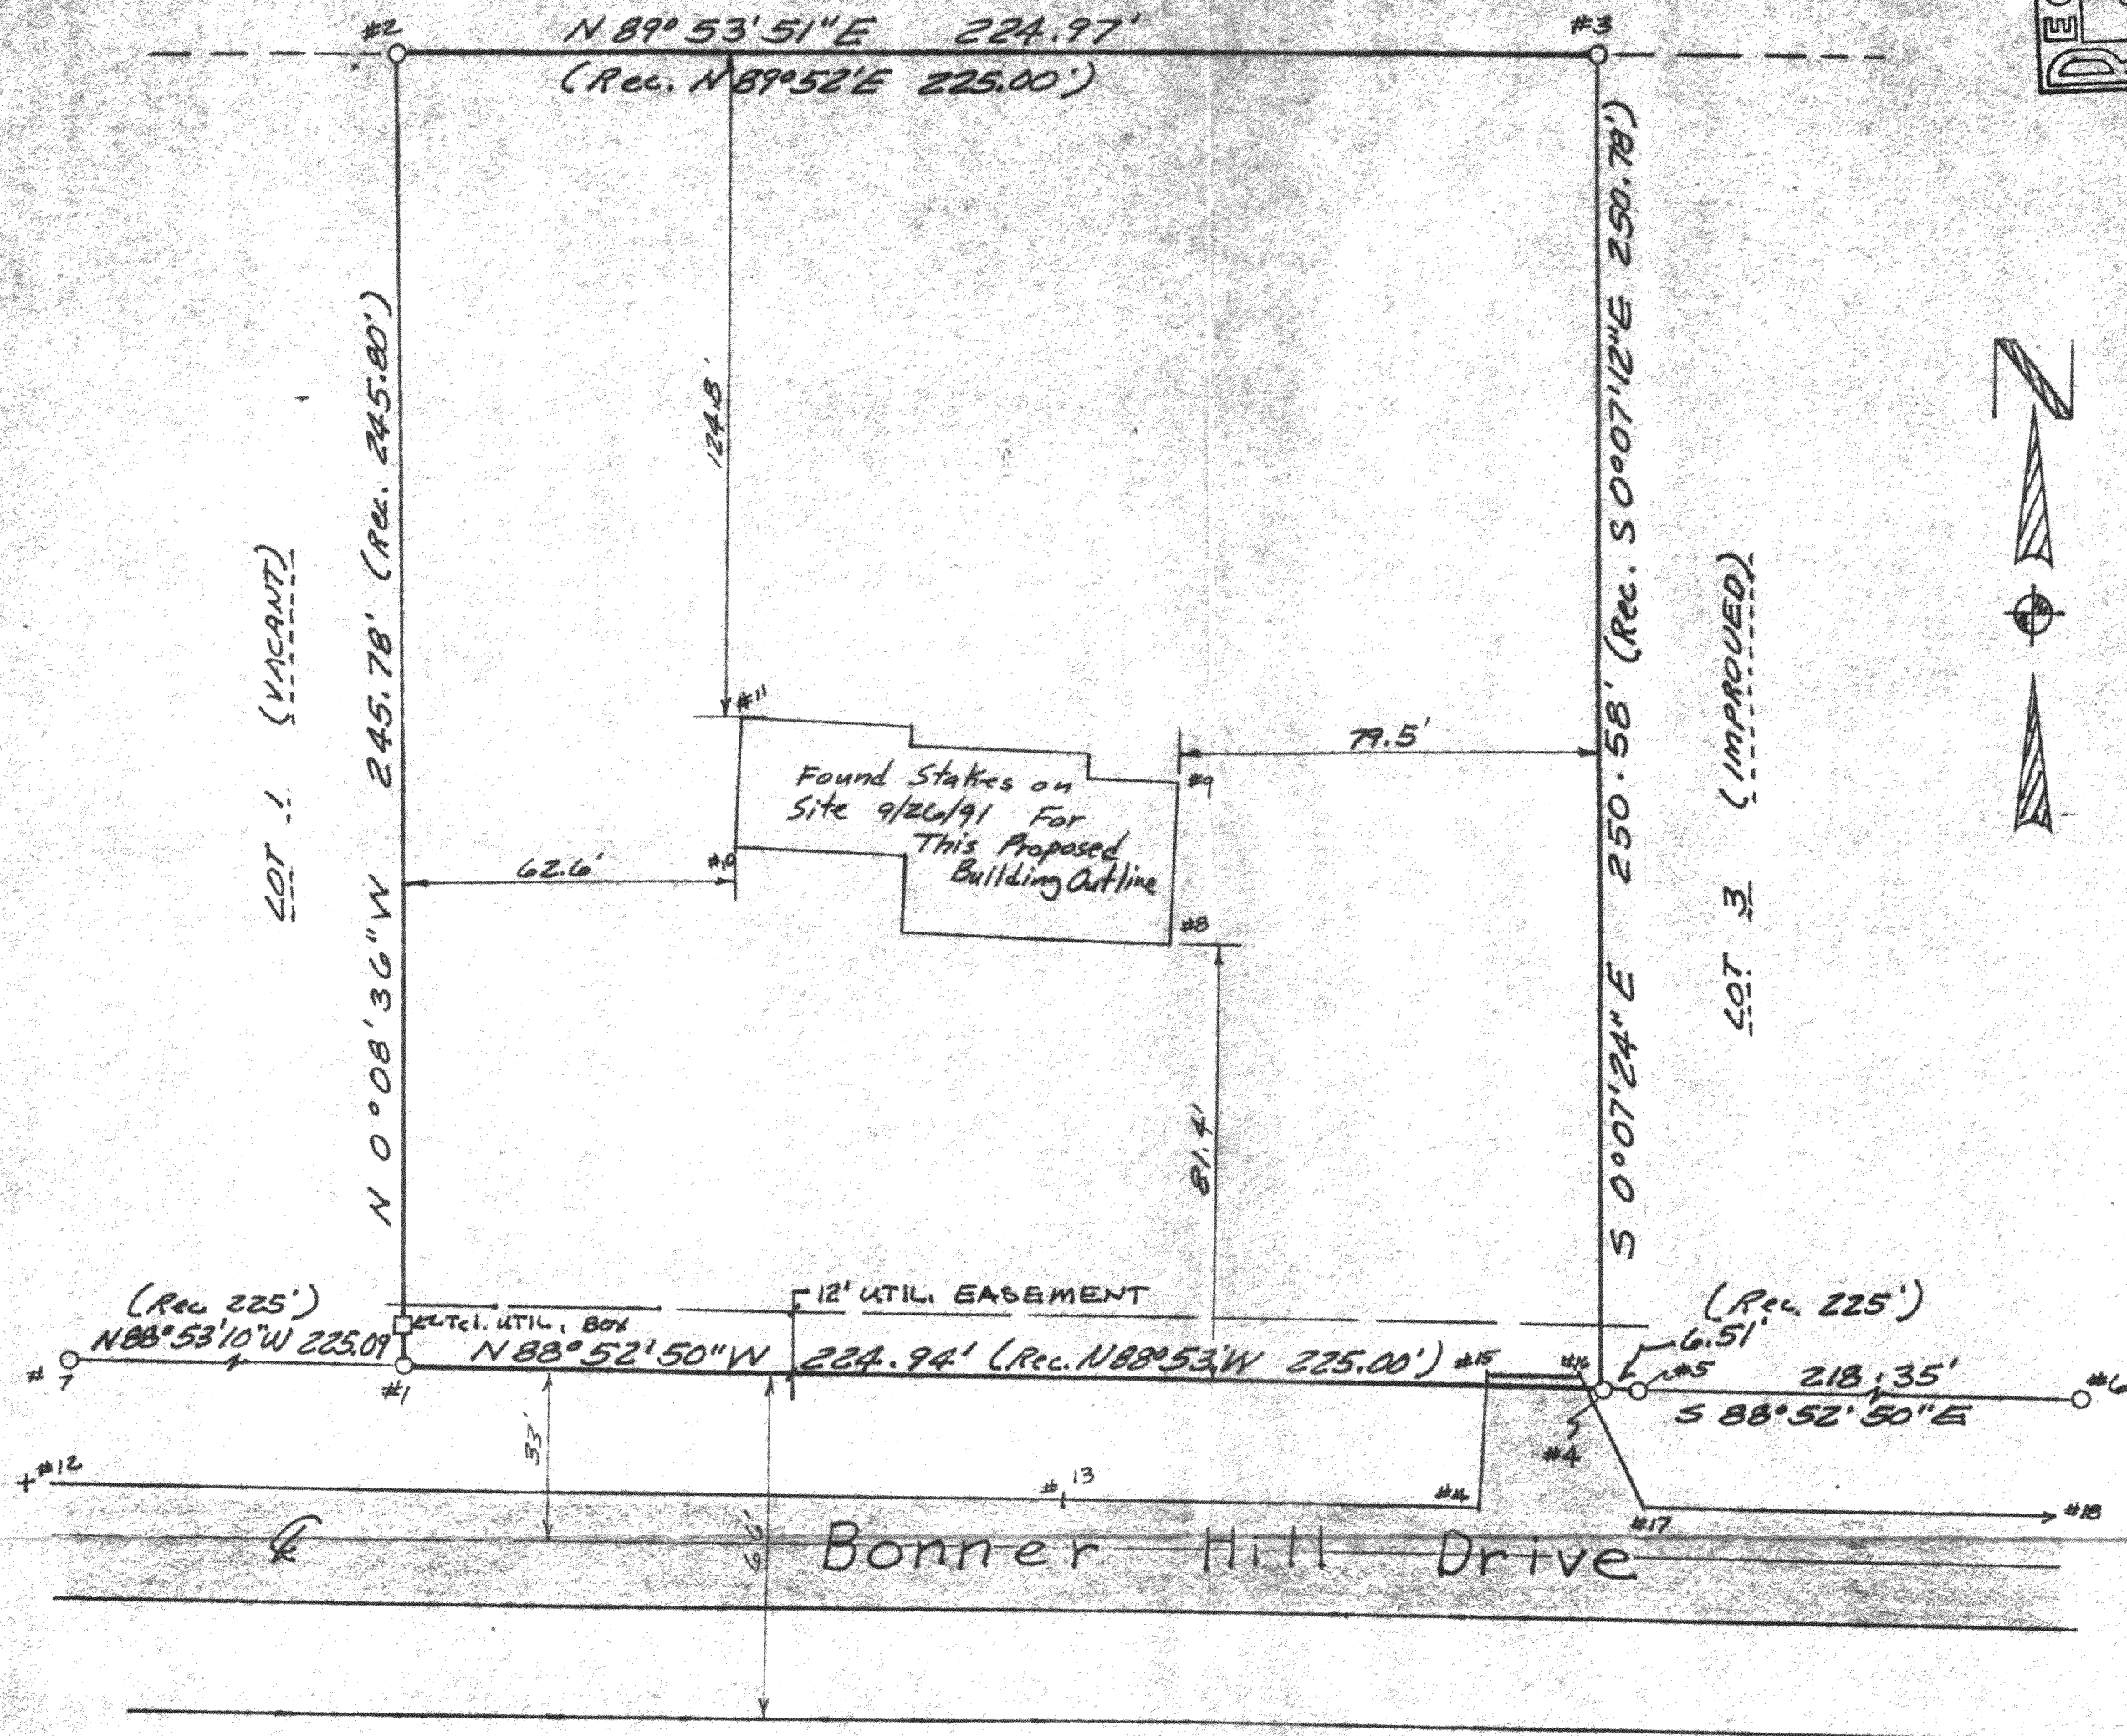


10 0 10 20 30 40 50 60 70 80 90 100 110 120 130 140 150 160 170 180 190 200
MAP SCALE IN FEET

UNPLATTED LANDS W-22-B

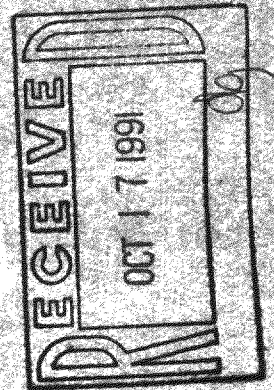

BOUNDARY AND AREA OF LOT 2 AS FOUND TO BE MONUMENTED

- 1 TO 2 N 0 - 8 - 36 W 245.78 FT
- 2 TO 3 N 89 - 53 - 51 E 224.97 FT
- 3 TO 4 S 0 - 7 - 24 E 250.58 FT
- 4 TO 1 N 88 - 52 - 50 W 224.94 FT

AREA 55822 SF 1.2815 ACRES

COORDINATE LIST 3547092791\

POINT DESCRIBED	NORTH	EAST
/ 1 FP 1.0 D	500.000	500.000/
/ 2 FP 1.0 D	745.779	499.385/
/ 3 FP 1.0 D	746.182	724.358/
/ 4 FP 1.0 D	495.605	724.897/
/ 5 FP 2.0 D	495.478	731.406/
/ 6 FP 1.0 D	491.212	949.714/
/ 7 FP 2.0 D	504.376	274.953/
/ 8 BLDR STK	578.623	643.492/
/ 9 BLDR STK	608.517	645.175/
/ 10 BLDR STK	597.106	562.387/
/ 11 BLDR STK	621.129	563.834/
/ 12 EOP	477.609	429.910/
/ 13 EOP	474.149	623.830/
/ 14 EOP	472.203	701.613/
/ 15 EOP	498.110	703.001/
/ 16 EOP	498.013	720.381/
/ 17 EOP	472.838	732.388/
/ 18 EOP	472.076	802.926/

ALL BEARINGS MEASURED RELATIVE TO WEST LINE LOT 2 ASSIGNED RECORD BEARING


LEGAL DESCRIPTION OF PROPERTY SURVEYED

LOT 2 OF OCTOBER HILLS LOCATED IN THE NORTHEAST 1/4 OF THE SOUTHEAST 1/4 OF SECTION 22, TOWN 1 NORTH, RANGE 16 EAST, WALWORTH COUNTY, WISCONSIN ACCORDING TO THE PLAT THEREOF RECORDED IN CABINET "B" ON SLIDE 33 IN THE OFFICE OF THE WALWORTH COUNTY REGISTER OF DEEDS ON JANUARY 25TH 1979 AS DOCUMENT NO. 43388.

I HEREBY CERTIFY THAT THIS MAP IS A TRUE AND ACCURATE REPRESENTATION OF THE BOUNDARY LINES AND LOCATION OF STAKES FOUND MARKING PROPOSED IMPROVEMENTS TO THE BEST OF MY PROFESSIONAL KNOWLEDGE AND BELIEF.

Robert A. Farris
ROBERT A. FARRIS RLS

WORK ORDERED BY THELEN TOTAL CONSTRUCTION
PROPOSED PETERSON RESIDENCE

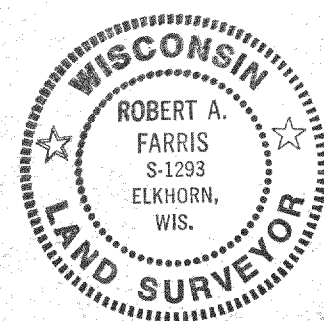

FARRIS, HANSEN & ASSOCIATES, INC.
Engineering, Architecture, Surveying
7 Ridgway Court P.O. Box 437
ELKHORN, WISCONSIN 53121
Office: (414) 723-2096
Fax: (414) 723-5886

REVISIONS

PROJECT NO
3547
DATE
9/27/91
SHEET NO
1 of 1