


**SURVEYING & SUBDIVIDING
DELAYAN, WISCONSIN 53115**

SOUTH SHORE DRIVE

(LAKE ROAD)

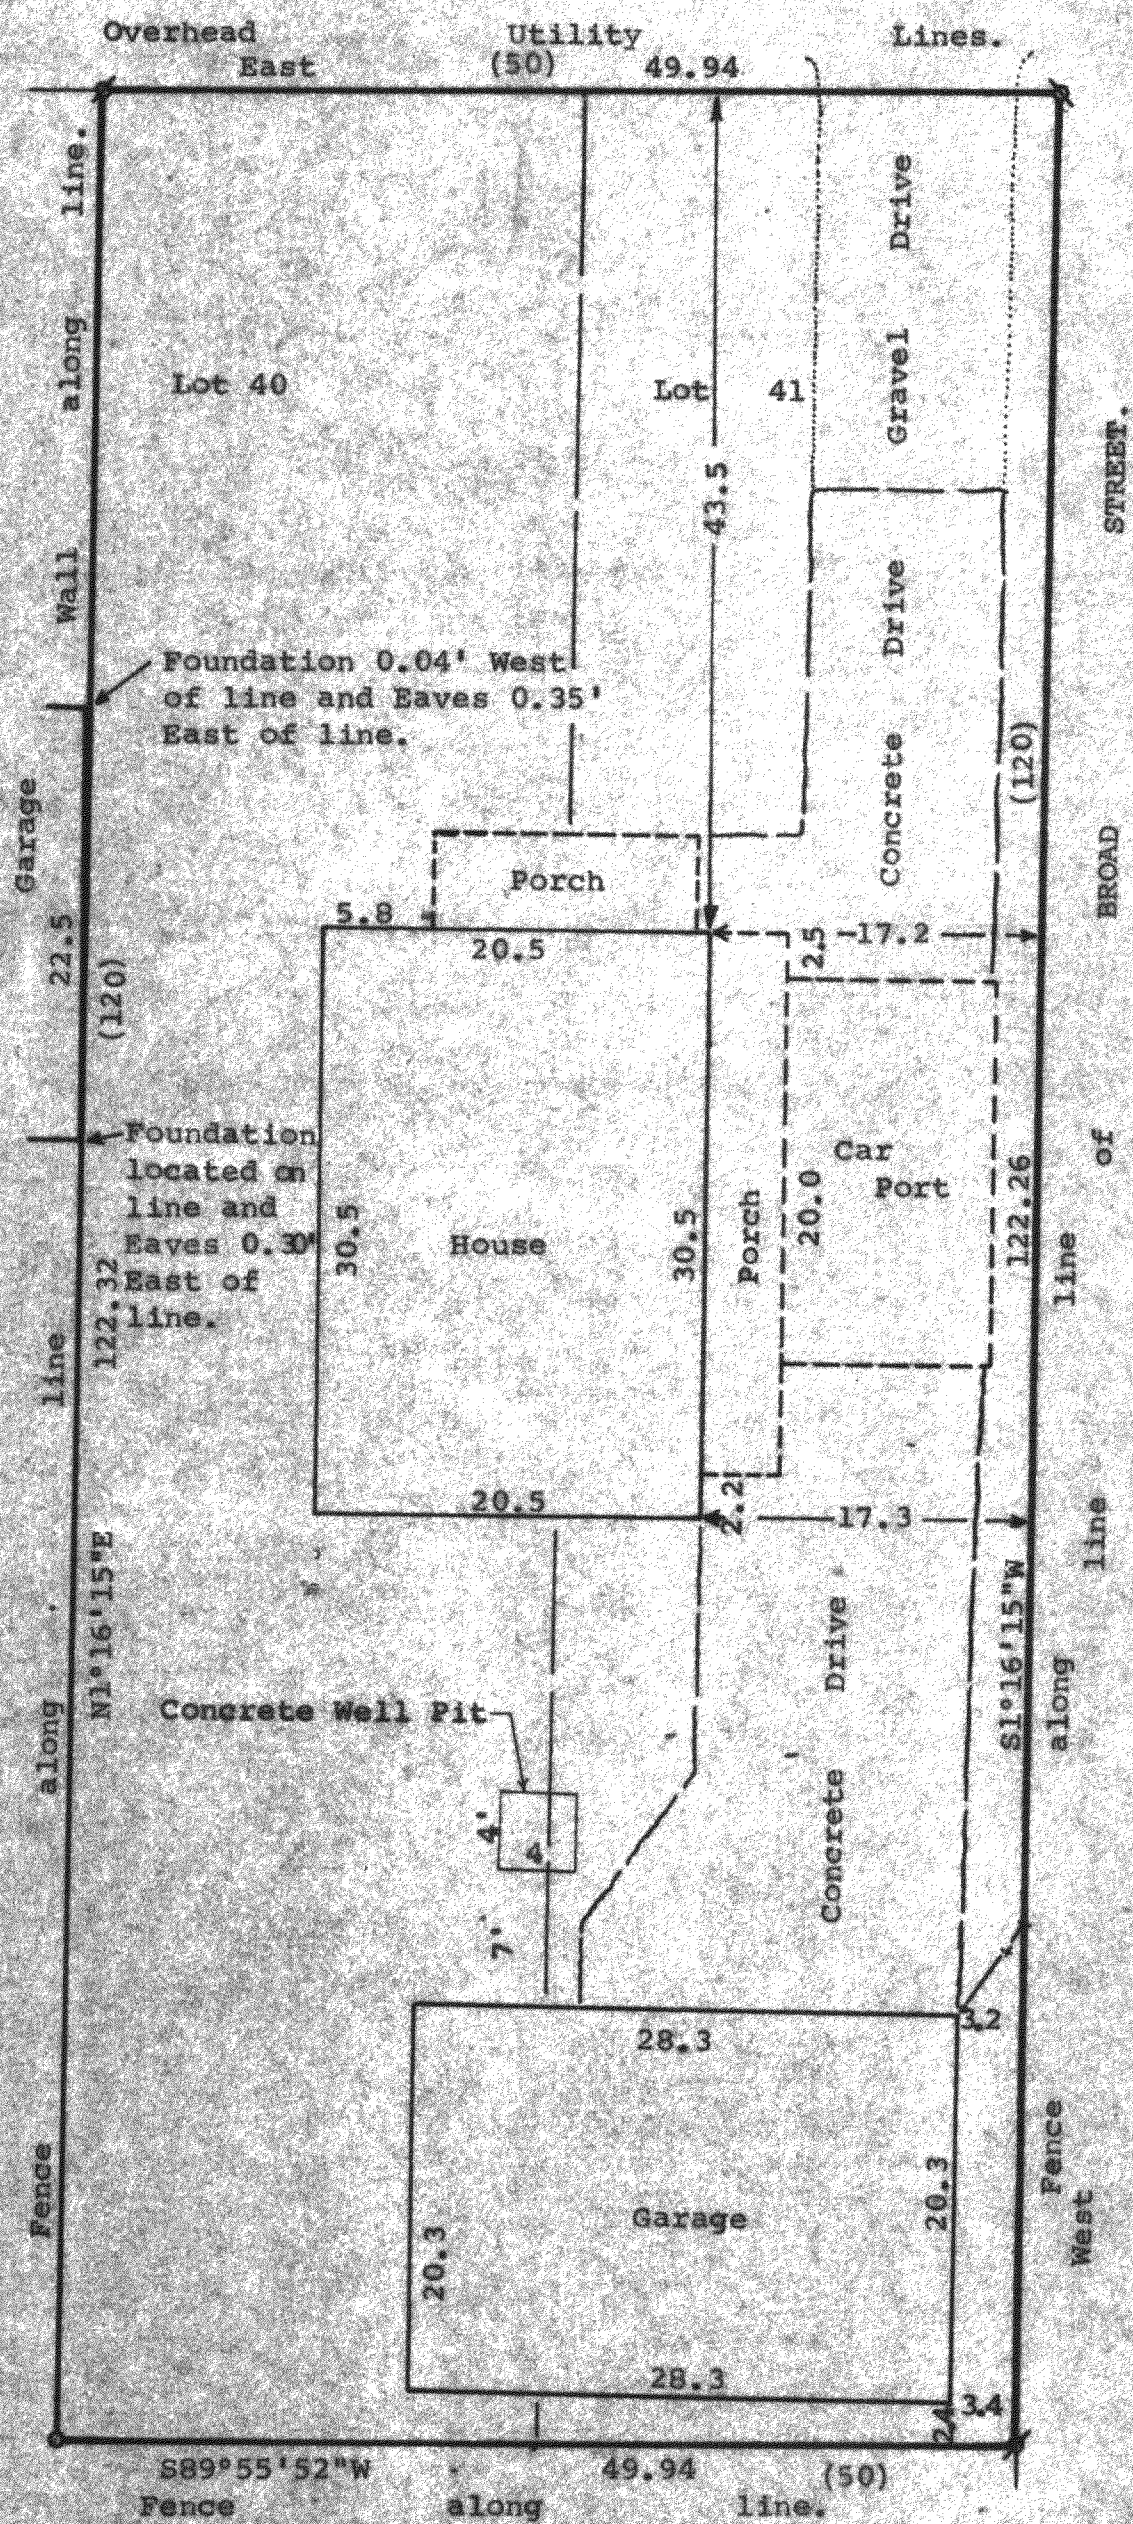

Updating and recertification on May 26, 1992 ordered by:
The Rauland Agency
118 Kenosha
Walworth, WI 53184

STATE OF WISCONSIN)
COUNTY OF WALWORTH) SS

I, Richard C. Schulz, Surveyor, certify that I have surveyed the property described as follows,
Lots 40 and 41, Block 4 of Robbins Subdivision,
located in the Northwest ¼ of Section 5, T1N, R16E,
Walworth County, Wisconsin.



and that the map shown above is a true representation thereof and shows the size and location of the property, its exterior boundaries, the location of all visible structures and dimensions of all principal buildings thereon, boundary fences, apparent easements, roadways and visible encroachments, if any, and that I have surveyed the property hereon described according to the official records to the best of my knowledge and belief.

July 19, 1984.

Updated and recertificated to
this 26th day of May, 1992

Richard C. Schulz
Richard C. Schulz, Surveyor

George T. Dunham
George T. Dunham, Surveyor

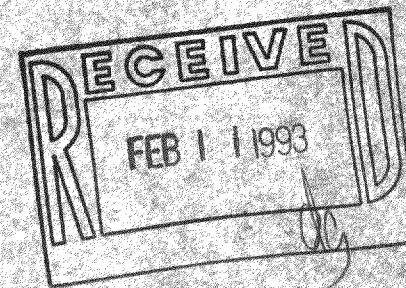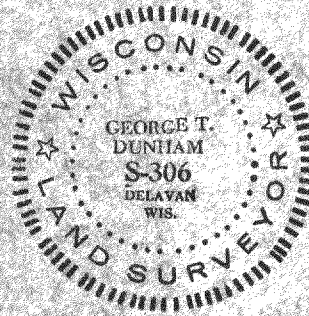

ER-19

116-360

116-186