
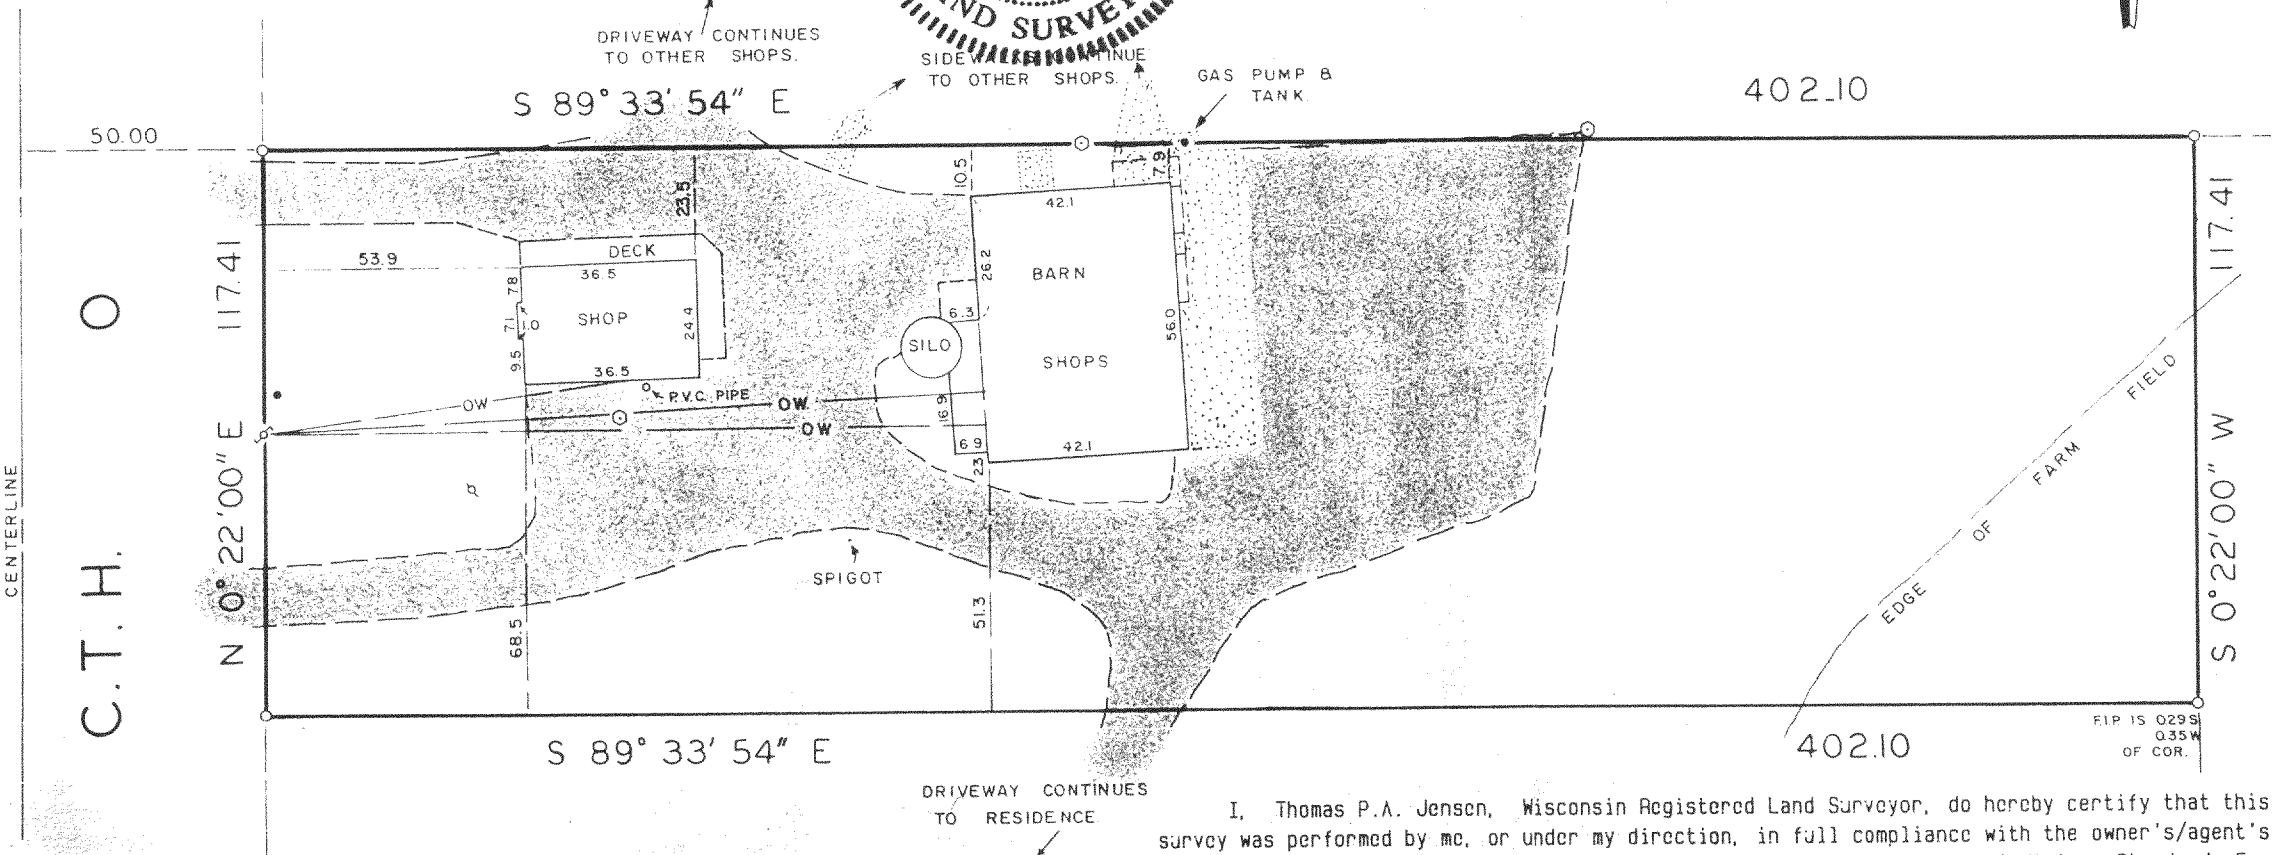


Plat of Survey

of
Lot 1 of Certified Survey Map No. 1359, located in the Northwest 1/4 of the
Northeast 1/4 of Section 6, Town 1 North, Range 16 East, Town of WALWORTH
Walworth County, Wisconsin.

Surveyed for: Stephen Miller/Bob Rauland
118 Kenosha Street
Walworth, Wisconsin. 53184


Bearings referenced to C.S.M. 1359.

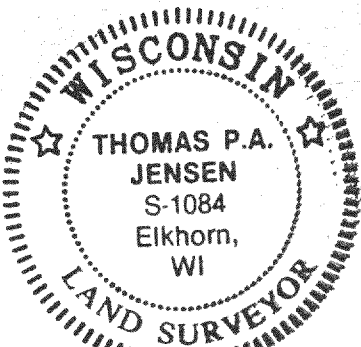

Copyright © 1991 by Jensen Surveying & Mapping S.C.
All rights reserved. No part of this survey plat may be reproduced or transmitted in any form
by any means - graphic, electronic, or mechanical, including photocopying, tracing, or infor-
mation storage and retrieval systems - without permission in writing from Thomas P.A. Jensen.

I, Thomas P.A. Jensen, Wisconsin Registered Land Surveyor, do hereby certify that this
survey was performed by me, or under my direction, in full compliance with the owner's/agent's
instructions and Chapter A-E 7 of the Wisconsin Administrative Code 'Minimum Standards For
Property Surveys', and that this map is an accurate representation thereof to the best of my
knowledge and belief.

Note: This survey plat is not
certified unless signed
and sealed in red ink.

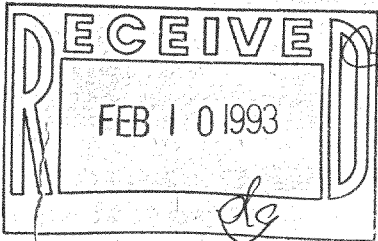

Legend

- o ~ Found iron pipe
- ~ Concrete surface
- ~ Blacktop surface
- ~ Utility pole
- ~ Gas valve
- o ~ Concrete Cover
- ~ Well

Jensen Surveying & Mapping S.C.

45 South Wisconsin Street P.O. Box 322
Elkhorn, Wisconsin. 53121.
(414) 723-3434

Mapping date: December 20, 1991

Revisions:

Sheet 1 of 1 Sheets

Job reference number:

1991.222

EA-1359-1

Scale: 1" = 40'



EA-1359-1



116-365

Plat of Survey

of
Lot 1 of Certified Survey Map No. 1359, located in the Northwest 1/4 of the
Northeast 1/4 of Section 6, Town 1 North, Range 16 East, Town of WALWORTH
Walworth County, Wisconsin.

Surveyed for: Stephen Miller/Bob Rauland
118 Kenosha Street
Walworth, Wisconsin. 53184


Bearings referenced to C.S.M. 1359.

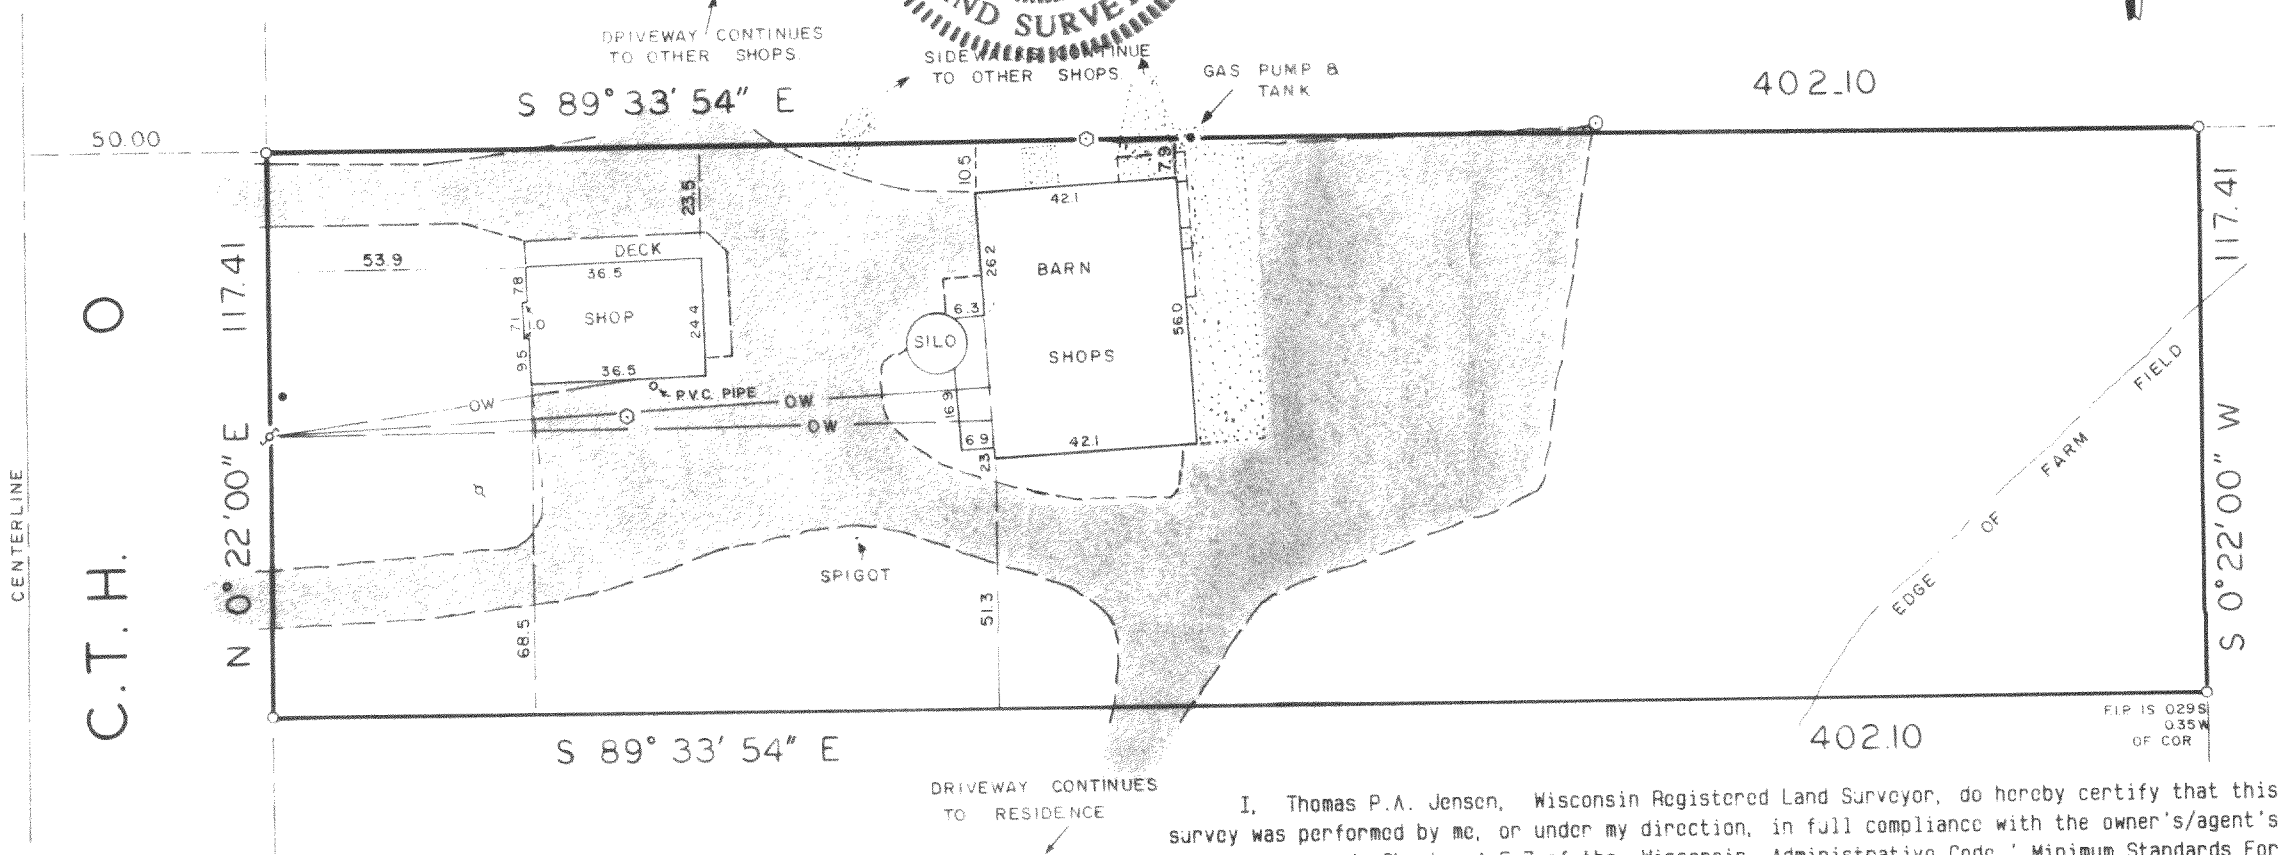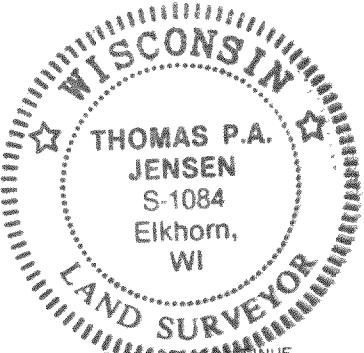

Copyright © 1991 by Jensen Surveying & Mapping S.C.
All rights reserved. No part of this survey plat may be reproduced or transmitted in any form
by any means - graphic, electronic, or mechanical, including photocopying, tracing, or infor-
mation storage and retrieval systems - without permission in writing from Thomas P.A. Jensen.

I, Thomas P.A. Jensen, Wisconsin Registered Land Surveyor, do hereby certify that this
survey was performed by me, or under my direction, in full compliance with the owner's/agent's
instructions and Chapter A-E 7 of the Wisconsin Administrative Code 'Minimum Standards For
Property Surveys', and that this map is an accurate representation thereof to the best of my
knowledge and belief.

Note: This survey plat is not
certified unless signed
and sealed in red ink.

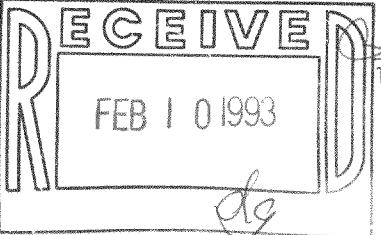


Thomas P.A. Jensen R.L.S. 1084

Legend

- o Found iron pipe
- Concrete surface
- Blacktop surface
- Utility pole
- Gas valve
- Concrete Cover
- Well

Jensen Surveying & Mapping S.C.

45 South Wisconsin Street P.O. Box 322
Elkhorn, Wisconsin. 53121.
(414) 723-3434

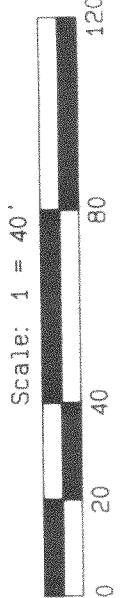

Mapping date: December 20, 1991

Revisions:

Sheet 1 of 1 Sheets

Job reference number:

1991.222

116-365

EA-1359-1