



**ABELL
SURVEYING & MAPPING
DELAVER, WISCONSIN 53115
414-728-6737**

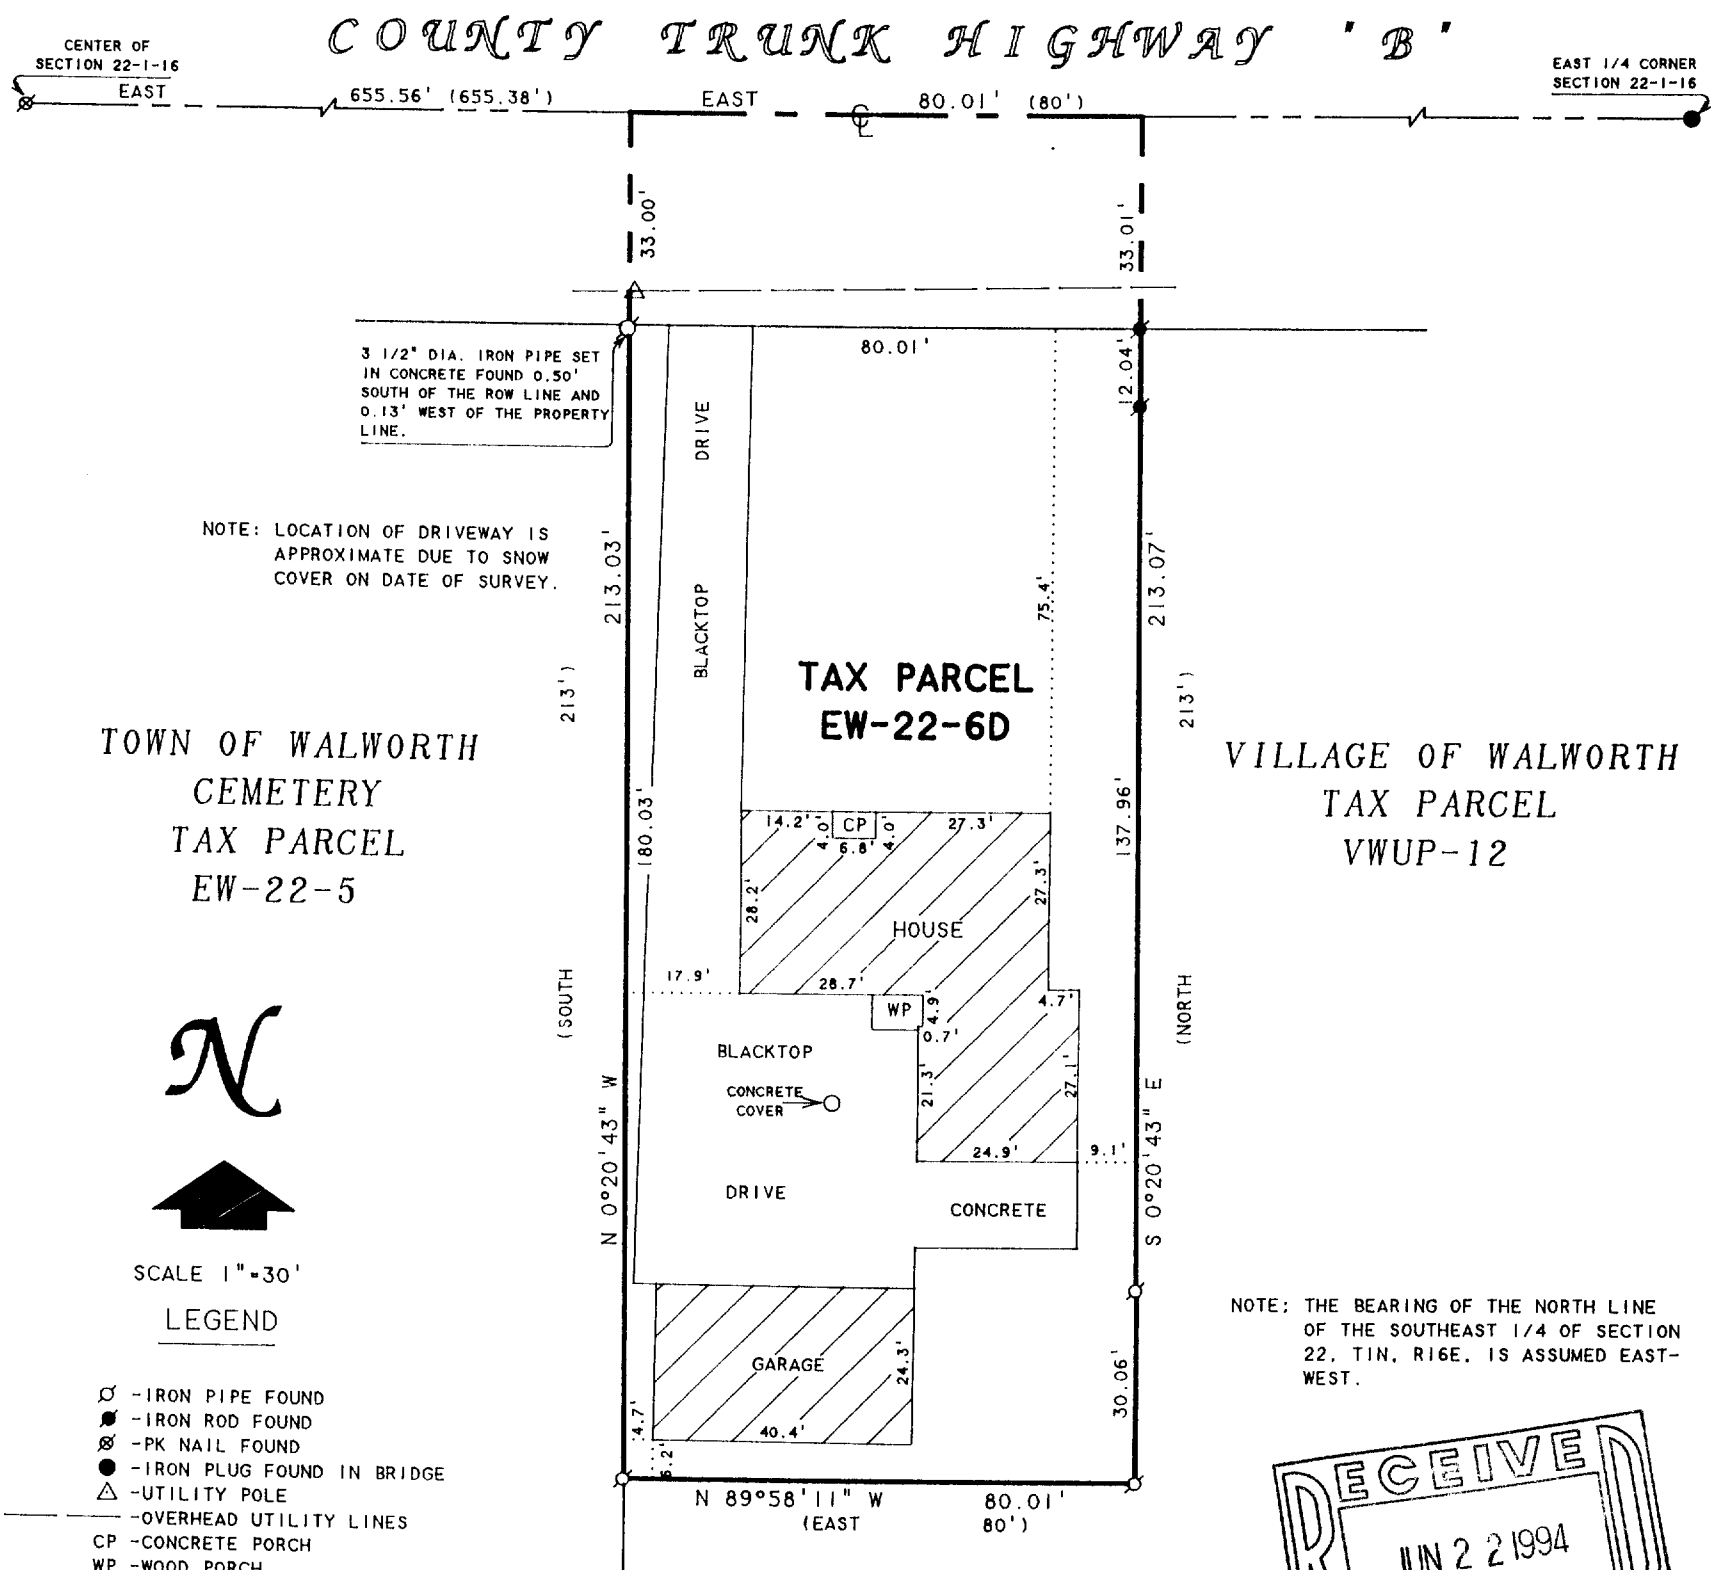

NOTE: THE BEARING OF THE NORTH LINE OF THE SOUTHEAST 1/4 OF SECTION 22, T.1N, R.16E, IS ASSUMED EAST-WEST.

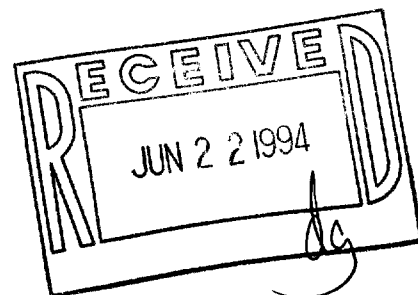

A parcel of land located in the SE $\frac{1}{4}$ of Sec. 22, T.1N, R.16E. of Walworth County, Wisconsin, described as follows to-wit: Commencing at the N.W. corner of said SE $\frac{1}{4}$; thence E'ly along the N. line of said SE $\frac{1}{4}$, 655.38 ft. to the place of beginning; thence S'ly along the E. line of the cemetery property 213.00 feet; thence E'ly parallel with the N. line of said SE $\frac{1}{4}$, 80.00 feet; thence N'ly parallel with the E. line of the cemetery property 213.00 feet; thence W'ly along the N. line of said SE $\frac{1}{4}$, 80.00 ft. to the place of beginning, Walworth County, WI, 1/n/o Donald Zell and Frances Zell as husband and wife reflected by deed recorded on May 17, 1962, in Vol. 577 of Deeds, p. 387 as document no. 538747 and deed recorded September 14, 1964, in Vol. 610 of Deeds, p. 63 as document no. 563319.

ORDERED BY: ZELL WOODWORKING
1299 CENTER STREET
DELAVER, WI 53115

I HEREBY CERTIFY THAT I HAVE SURVEYED THE ABOVE DESCRIBED PROPERTY AND THAT THE ABOVE MAP IS A TRUE REPRESENTATION THEREOF AND SHOWS THE SIZE AND LOCATION OF THE PROPERTY, ITS EXTERIOR BOUNDARIES, THE LOCATION OF ALL VISIBLE STRUCTURES AND DIMENSIONS OF ALL PRINCIPAL BUILDINGS THEREON, BOUNDARY FENCES, APPARENT EASEMENTS, ROADWAYS AND VISIBLE ENCROACHMENTS, IF ANY, TO THE BEST OF MY KNOWLEDGE AND BELIEF.

THIS SURVEY IS MADE FOR THE USE OF THE PRESENT OWNERS OF THE PROPERTY, AND ALSO THOSE WHO PURCHASE, MORTGAGE, OR GUARANTEE THE TITLE THERETO WITHIN ONE (1) YEAR FROM DATE HEREON.

David F. Abell

DAVID F. ABELL
WISCONSIN REGISTERED LAND SURVEYOR, S-1596

February 17, 1994

DATE: February 17, 1994 JOB NUMBER - 93195
NOTE: THIS IS NOT A CERTIFIED COPY UNLESS SEALED.

EW-22-6D

116-404