


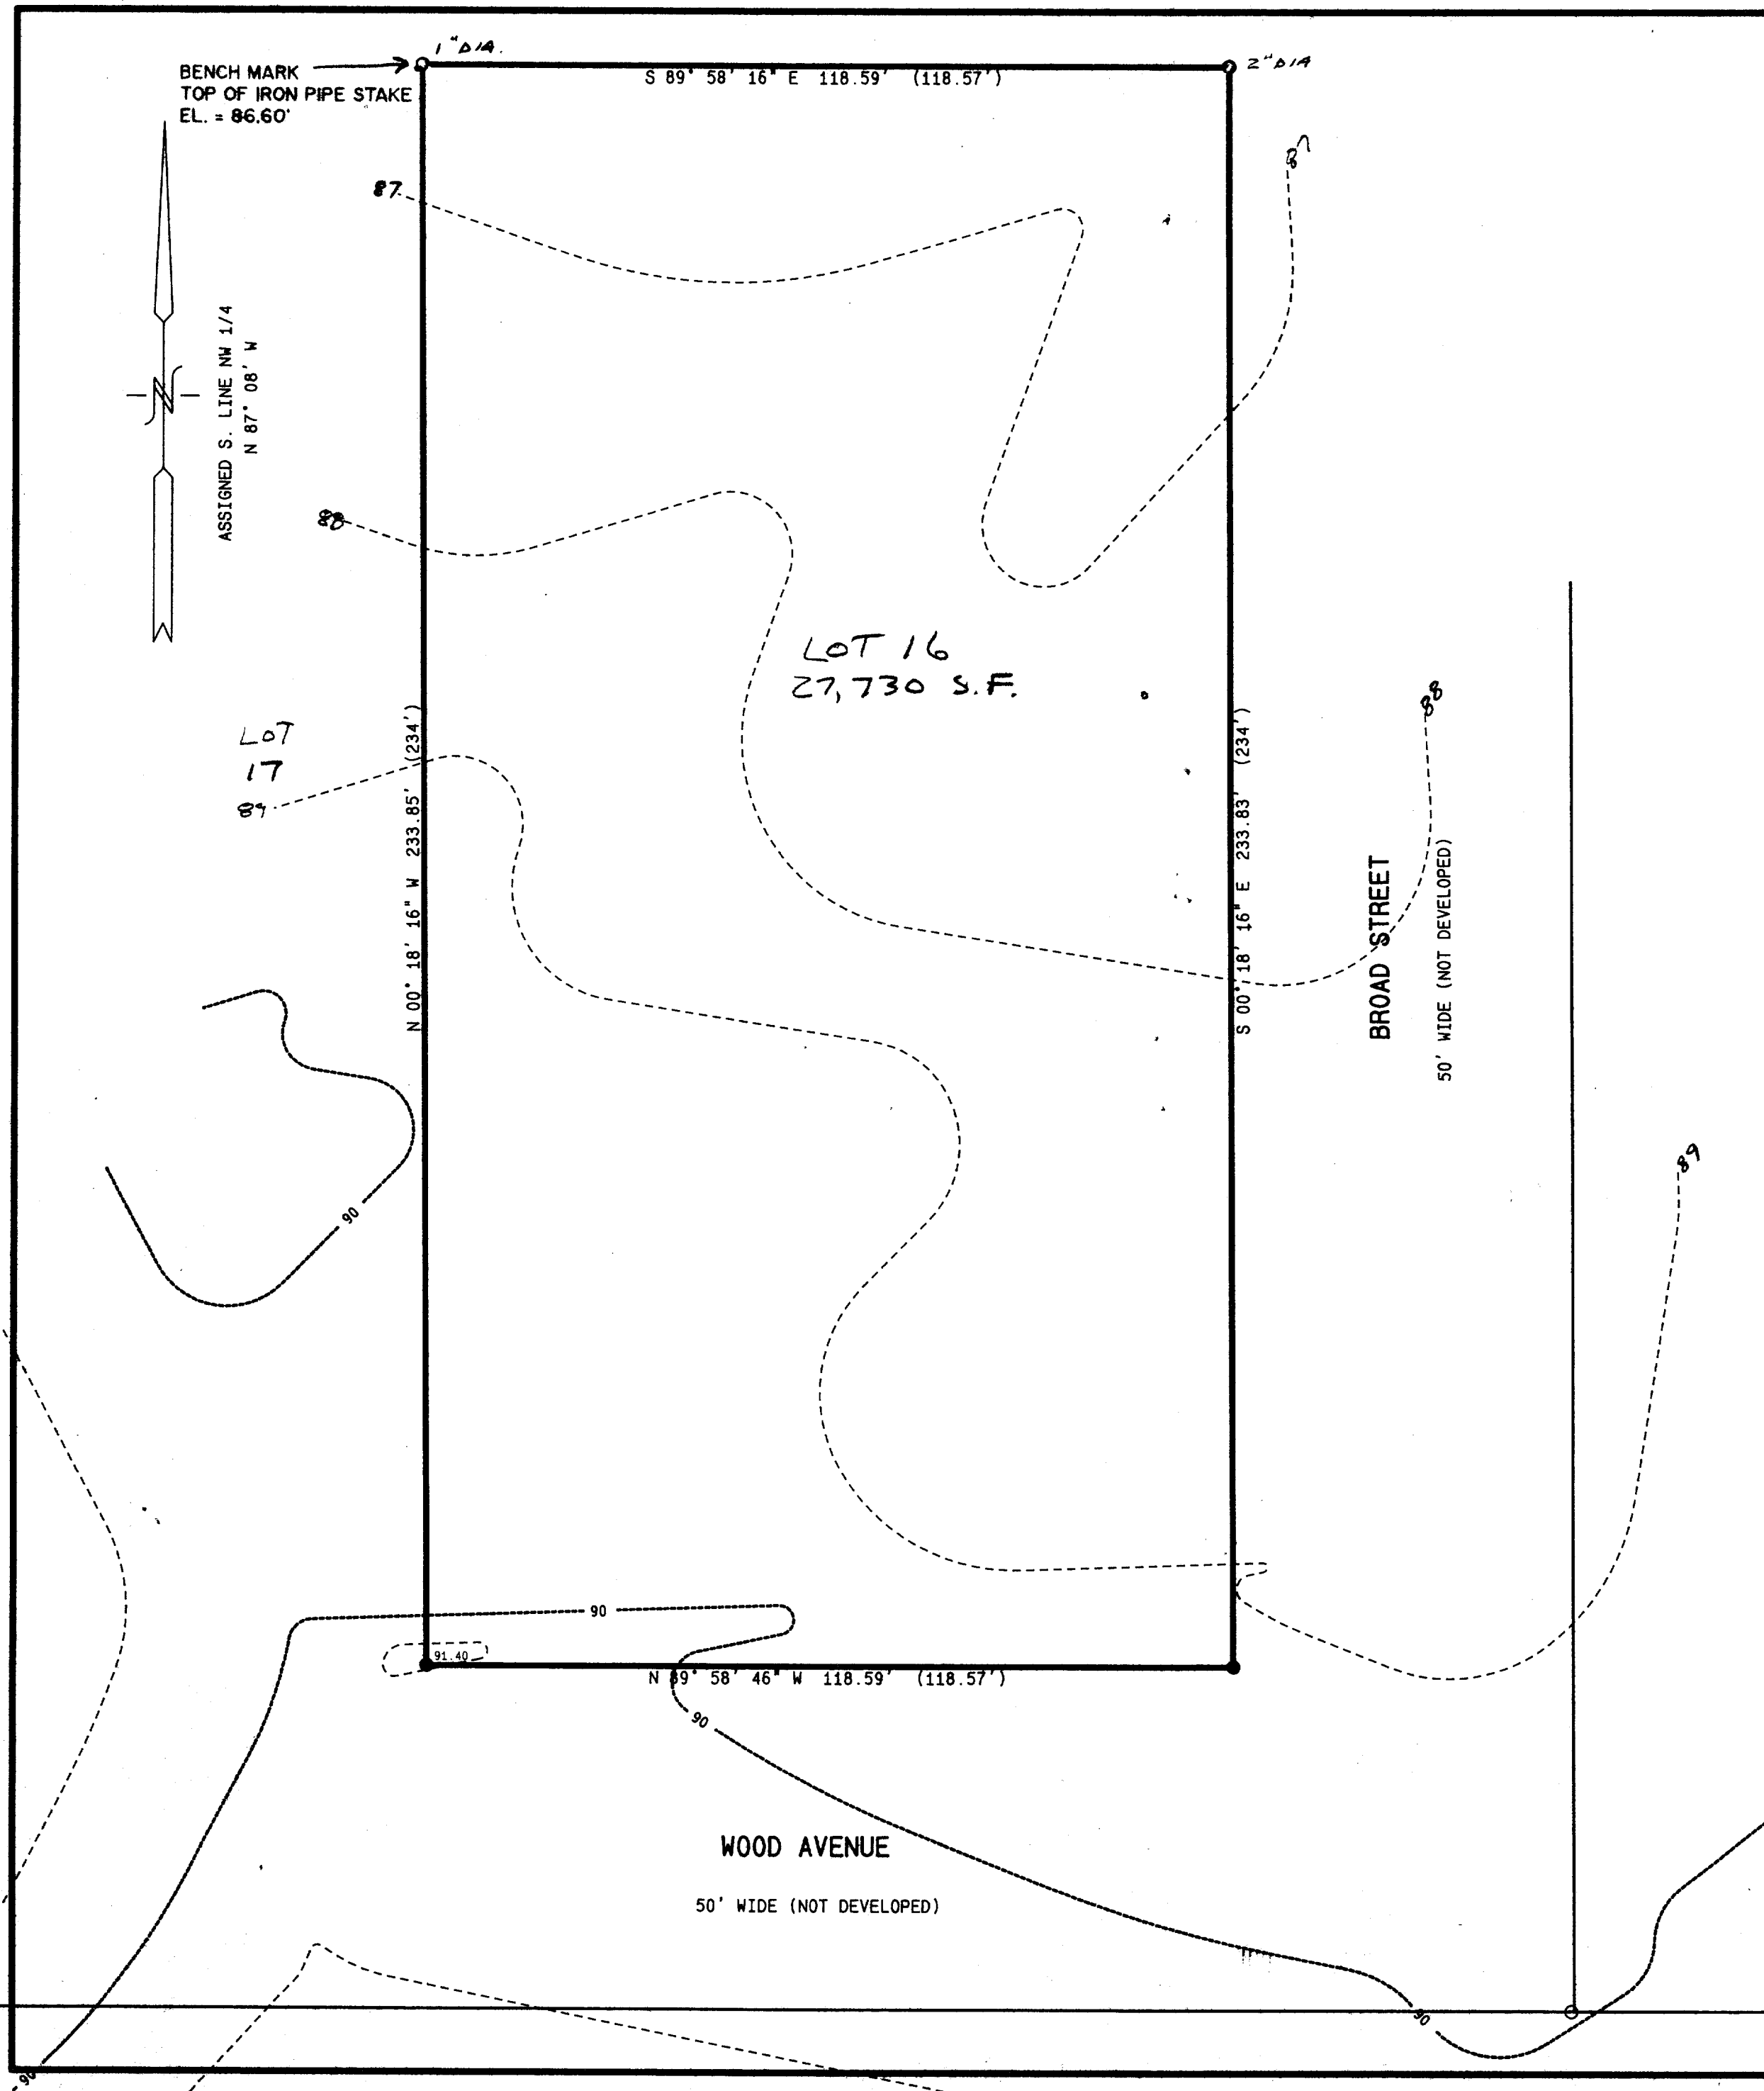


PLAT OF SURVEY
LOT 16
ADDITION NO. 1 TO ROBBINS SUBDIVISION
NW 1/4 SECTION 5, TOWN 1 NORTH, RANGE 16 EAST
WALWORTH COUNTY, WISCONSIN

NOTE: COPIES OF THIS MAP TO WHICH THE FOLLOWING CERTIFICATE WILL APPLY ARE BLUE LINE PRINTS SHOWING SURVEYOR'S ORIGINAL SEAL AND SIGNATURE IN BLACK INK. COPIES BY ANY OTHER MEANS MAY HAVE ALTERATIONS WHICH DO NOT REPRESENT THE SURVEYOR'S WORK PRODUCT.

I HEREBY CERTIFY THAT THE ABOVE DESCRIBED PROPERTY HAS BEEN SURVEYED UNDER MY DIRECTION AND THAT THE ABOVE MAP IS A TRUE REPRESENTATION THEREOF AND SHOWS THE SIZE AND LOCATION OF THE PROPERTY AND ITS EXTERIOR BOUNDARIES. THIS SURVEY IS MADE FOR THE USE OF THE PRESENT OWNERS OF THE PROPERTY, AND ALSO THOSE WHO PURCHASE, MORTGAGE, OR GUARANTEE THE TITLE THERETO WITHIN ONE YEAR FROM THE DATE HEREOF.



DATED: 9/14/94

Peter S. Gordon

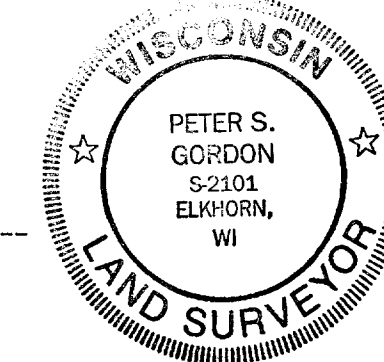

LEGEND

- SET IRON REBAR STAKE
- FOUND IRON REBAR STAKE
- FOUND CONCRETE COUNTY MONUMENT
- (xxx) = RECORDED AS
- FOUND IRON PIPE STAKE

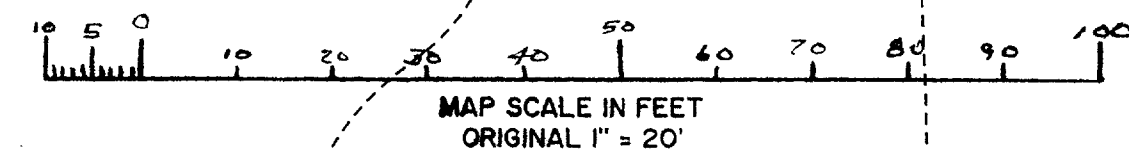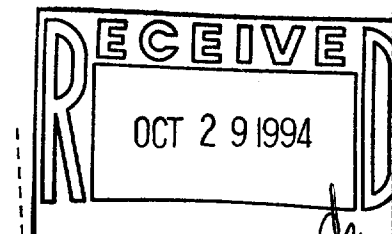

ERA-16

116-407

WORK ORDERED BY: LES JOHNSON
WALWORTH MANAGEMENT, INC.
P.O. BOX 955
WILLIAMS BAY, WISCONSIN

FARRIS, HANSEN & ASSOCIATES, INC.
Engineering, Architecture, Surveying
7 Ridgeway Court P.O. Box 437
ELKHORN, WISCONSIN 53121
Office: (414) 723-2098
Fax: (414) 723-5886

REVISIONS	
PROJECT NO.	4167
DATE	09-14-94
SHEET NO.	1 OF 1