


DUNHAM SURVEYING, S.C.
SURVEYING & SUBDIVIDING
DELAVER, WISCONSIN 53115

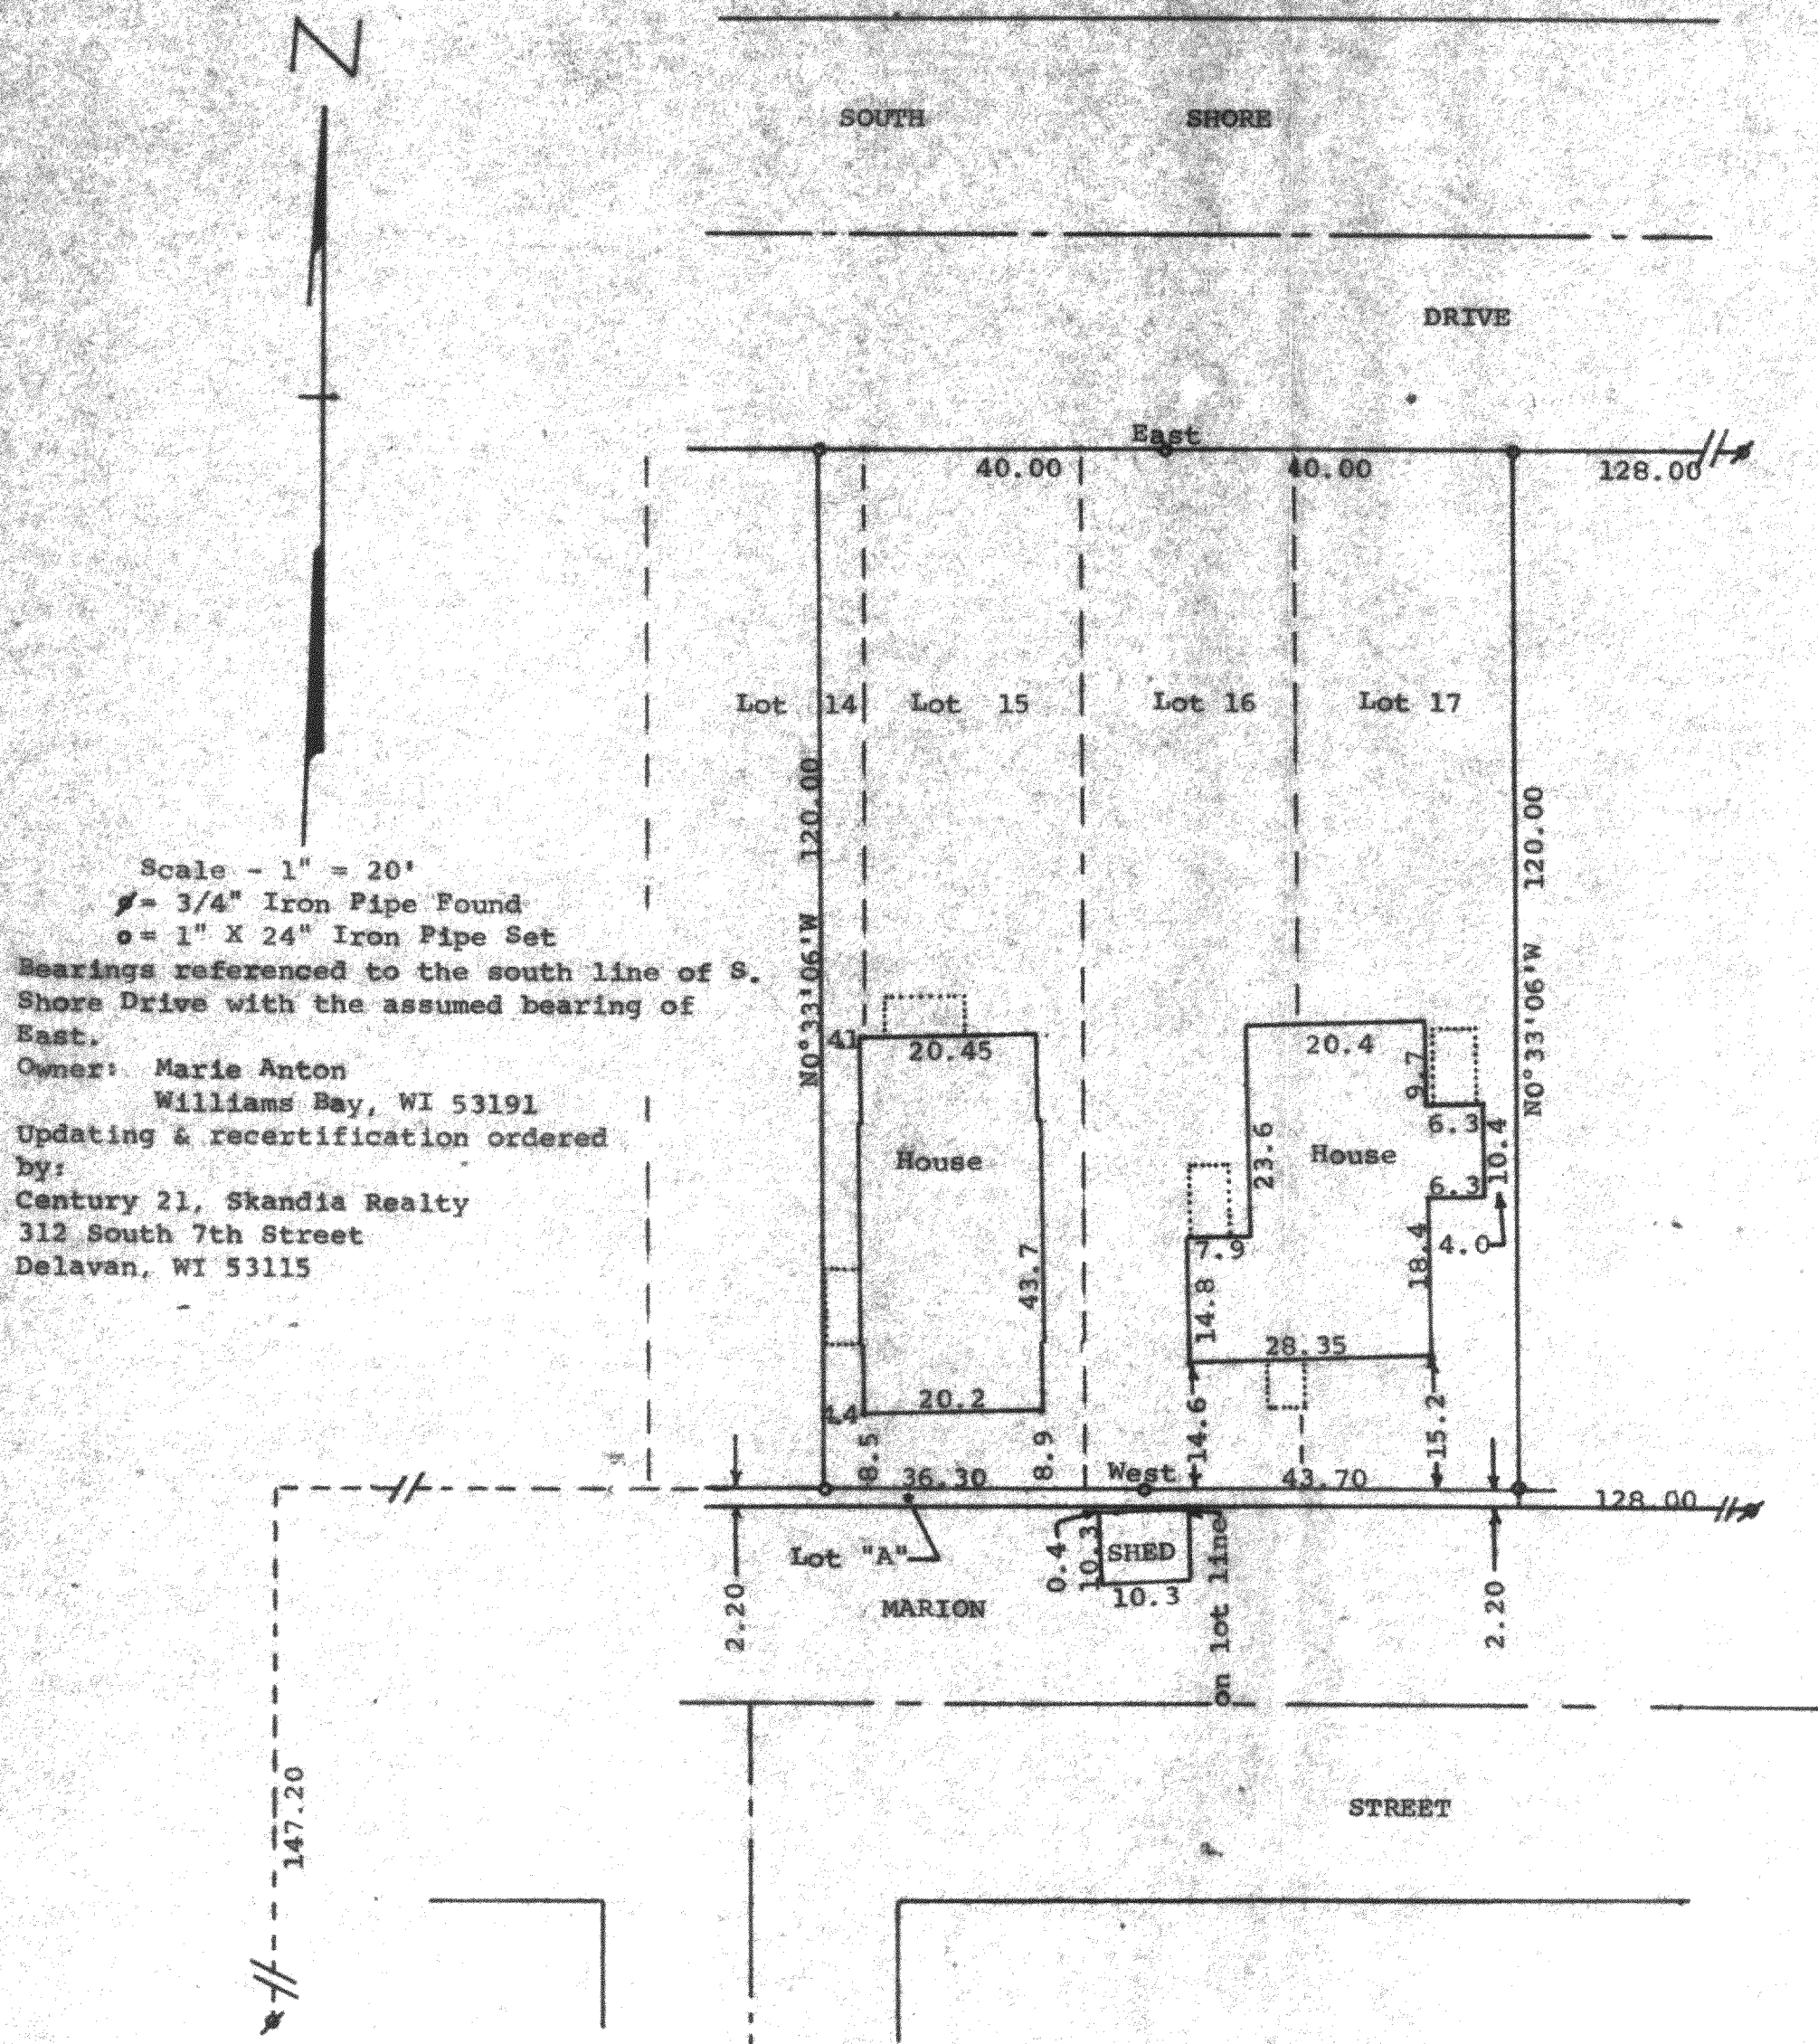

STATE OF WISCONSIN) SS
COUNTY OF WALWORTH)

I, George T. Dunham, Surveyor, certify that I have surveyed the property described as follows:

The East 5.00 feet of Lot 14, Lot 15, Lot 16 and Lot 17, Block 4, Robbins Subdivision, located in the Northwest 1/4 of Section 5, T 1 N, R 16 E, Walworth County, Wisconsin,

and that the above map is a correct representation thereof and shows the size and location of the property, its exterior boundaries, the location of all visible structures and dimensions of all principal buildings thereon, boundary fences, apparent easements, roadways and visible encroachments, if any, and that I have surveyed the property herein described according to the official records, to the best of my knowledge and belief.

August 7, 1987

Updated and recertified to this
19th day of April, 1994

George T. Dunham
George T. Dunham, Surveyor

