
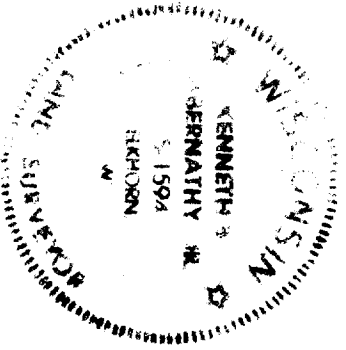
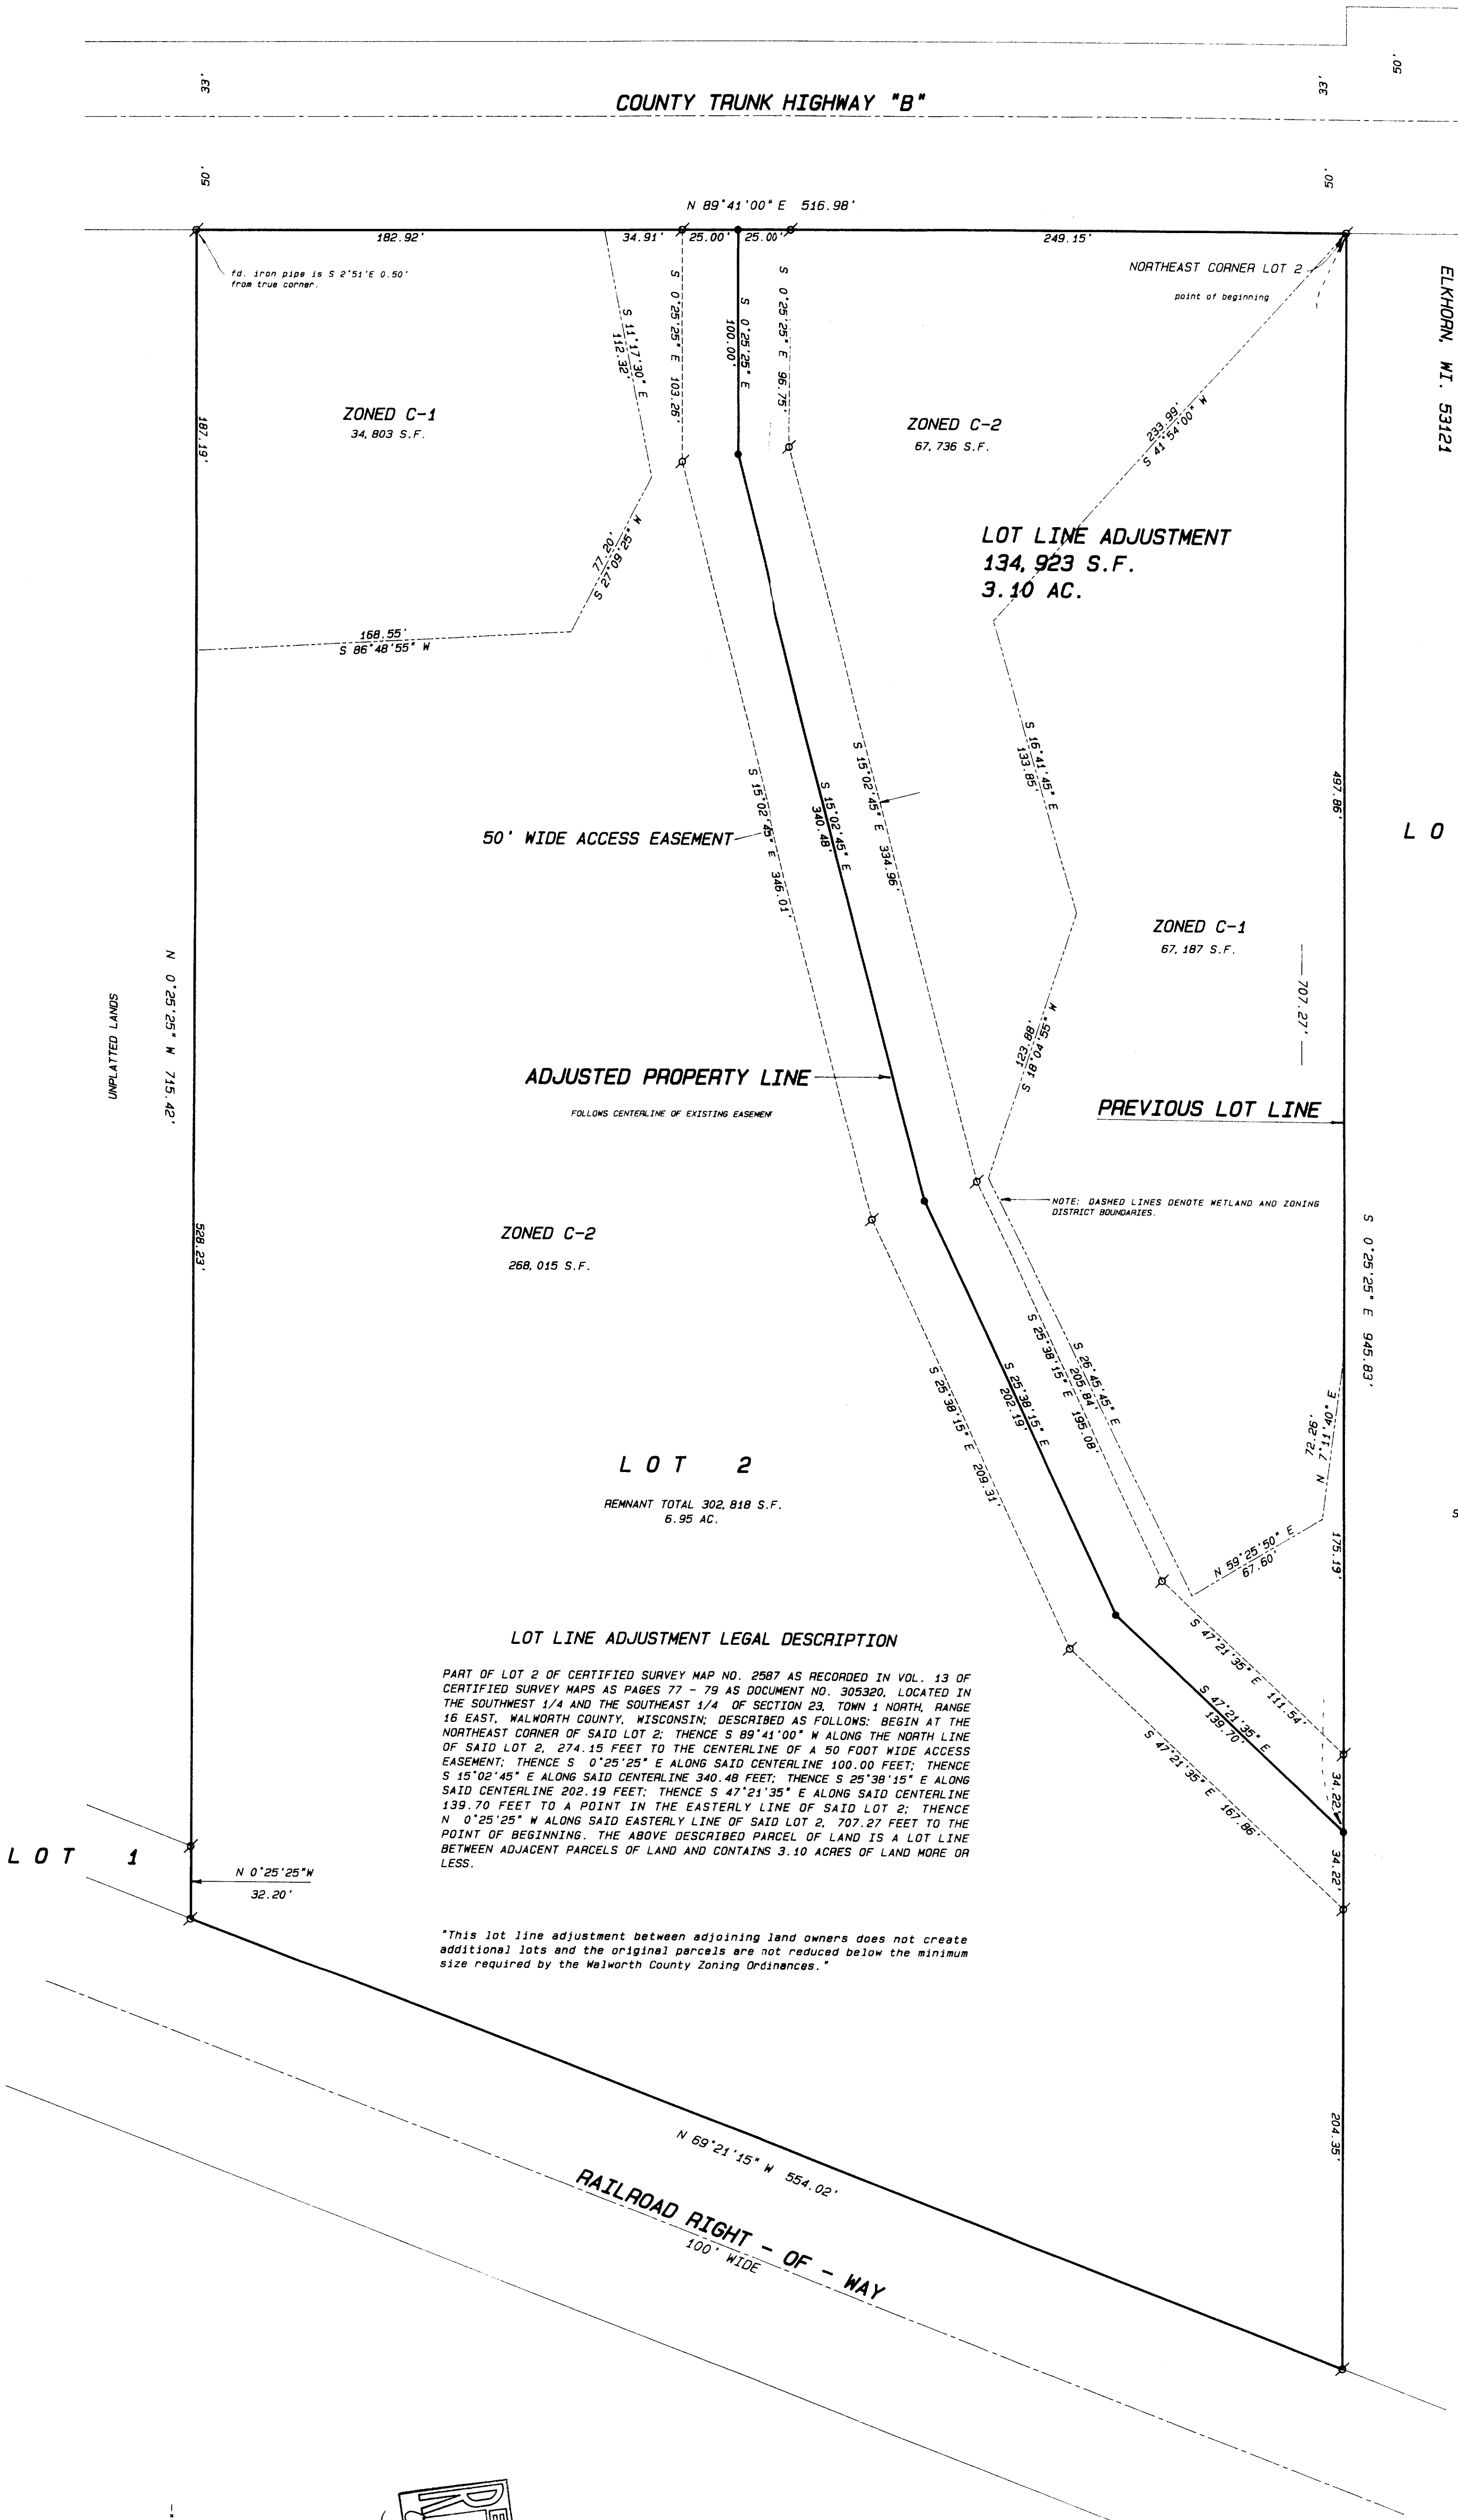


PLAT OF SURVEY

ORDERED BY: ATTY: DALE THORPE
GODFREY, NESHEK, WORTH & LEIBSLE, S.C.
41 NORTH WISCONSIN ST., P.O. BOX 260
ELKHORN, WI. 53121

LOT 3

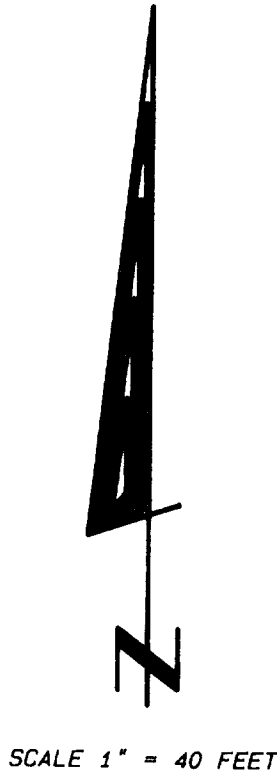

Kenneth B. Abernathy, Jr.
Wisconsin Registered Land Surveyor
S-1594
Date: 10-13-95 Job No. 95-912

EA-2587-2
11-17-95