


ABELL
SURVEYING & MAPPING
DELAVER, WISCONSIN 53115
414-728-6737



SCALE 1"=60'
LEGEND

- Ø - IRON PIPE FOUND
- WP - WOOD PORCH
- - UTILITY PED.
- f - TV SATELLITE ANTENNA
- () - RECORDED AS

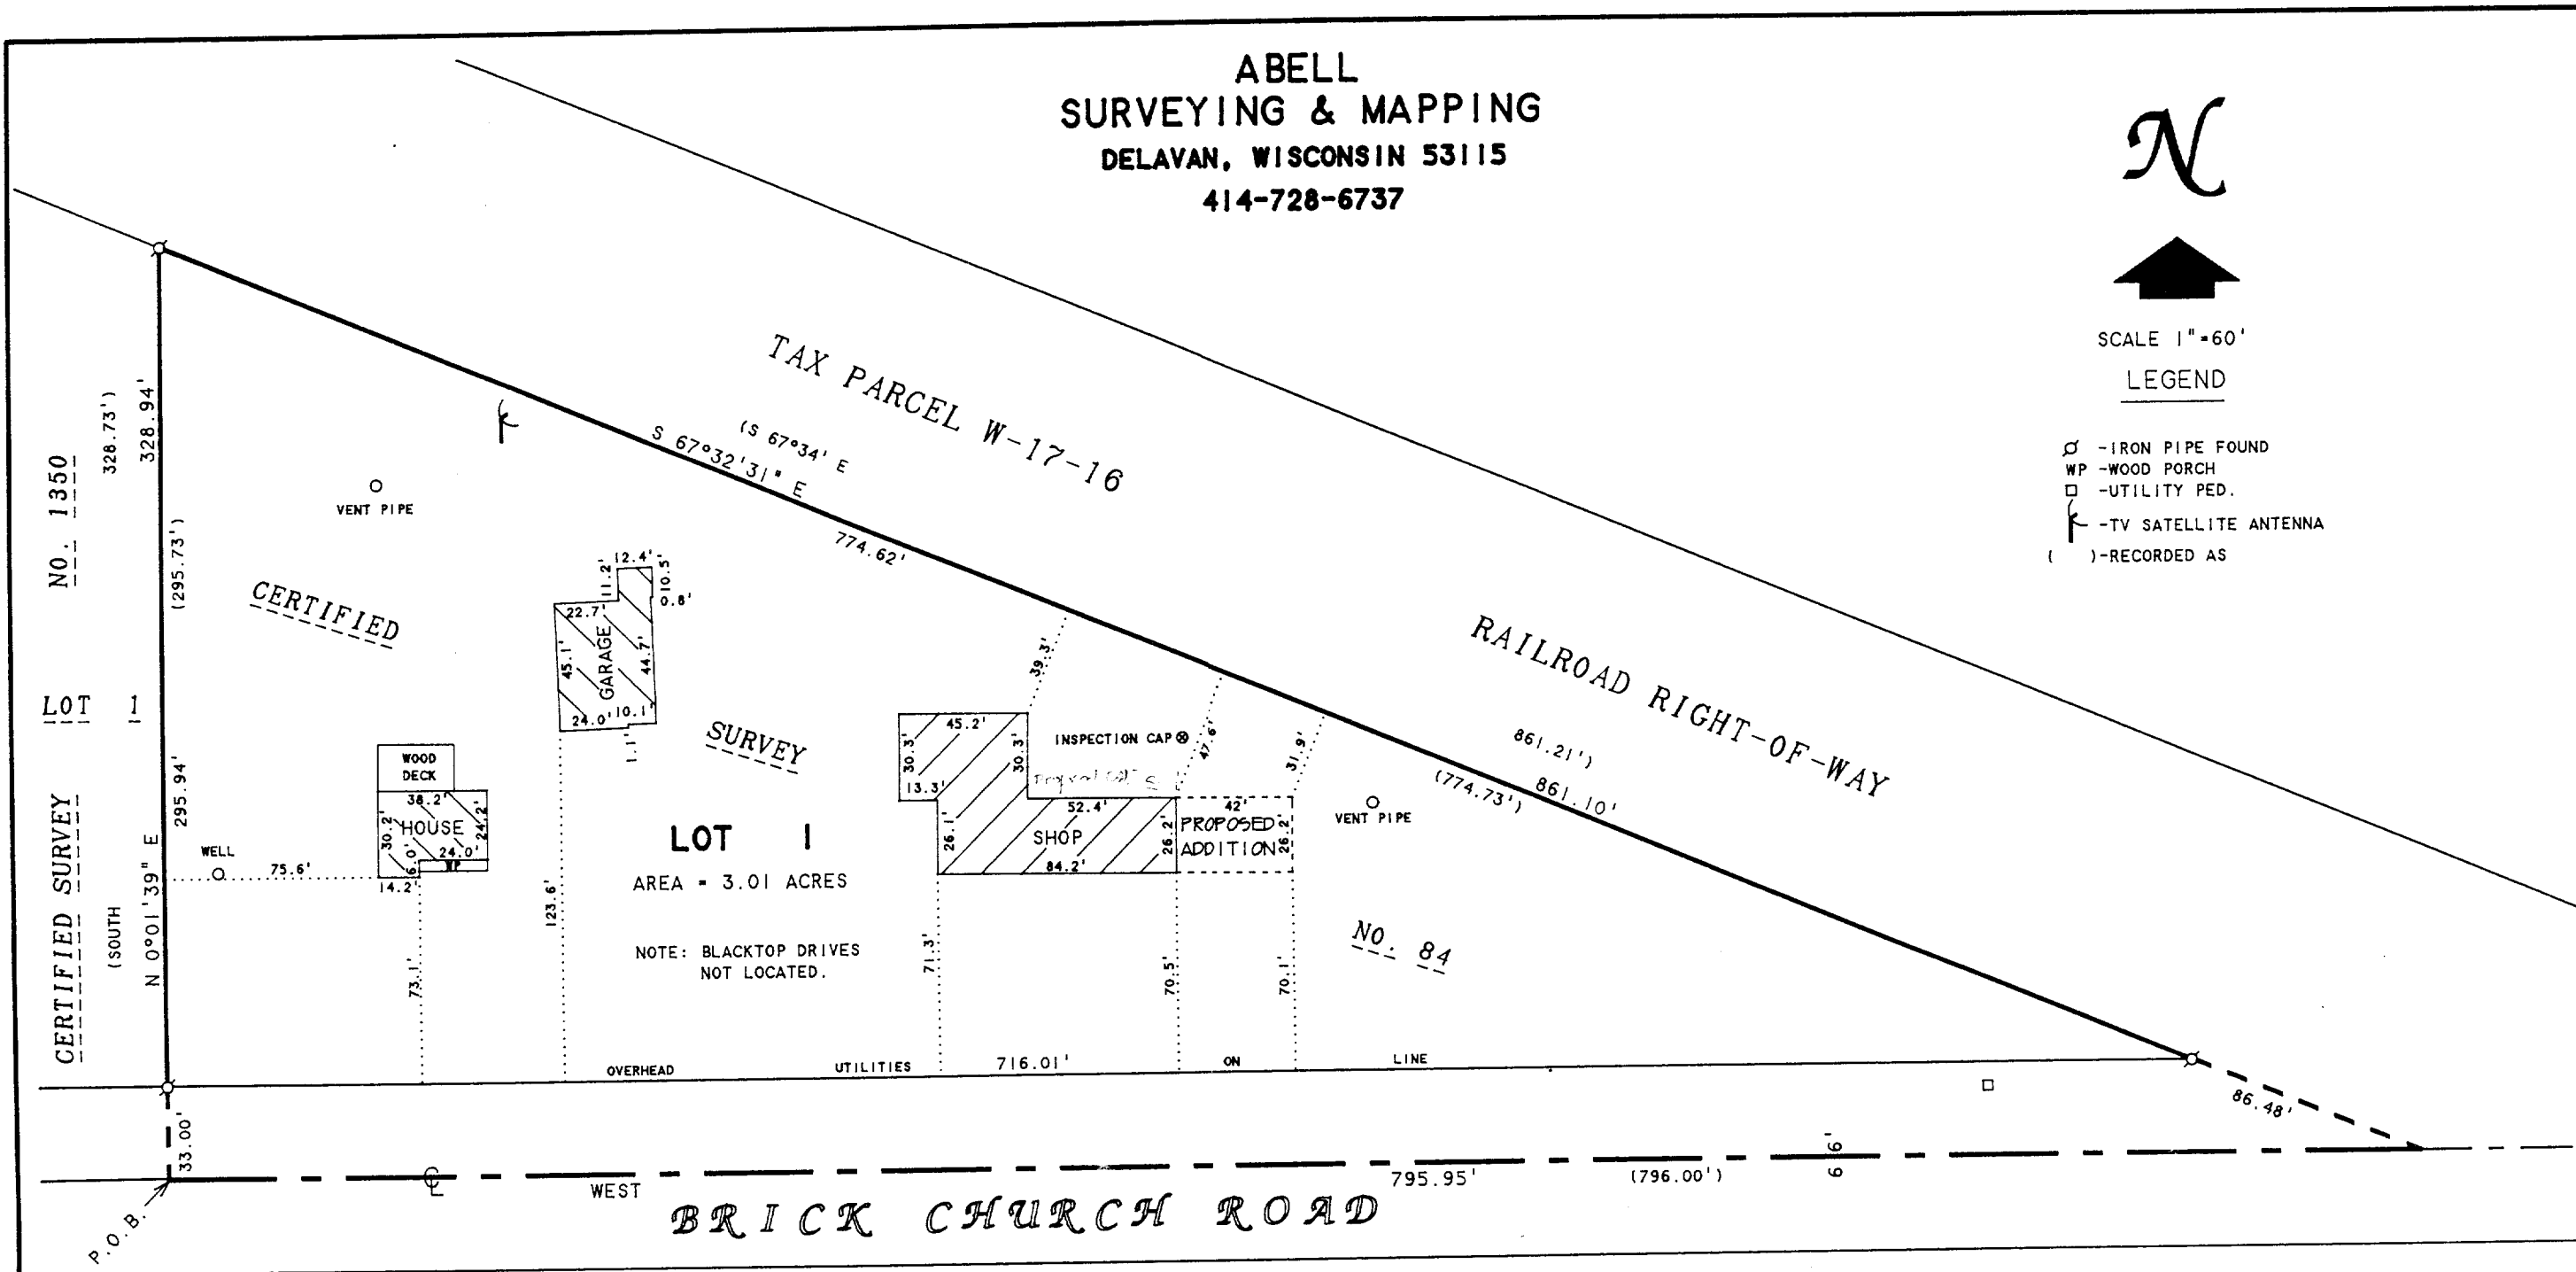

PLAT OF SURVEY OF

LOT 1, CERTIFIED SURVEY NO. 84, LOCATED
IN THE NORTHWEST 1/4 OF SECTION 17, T1N.
R16E, WALWORTH COUNTY, WISCONSIN.

ORDERED BY: RICHARD WETER
W6760 BRICK CHURCH ROAD
WALWORTH, WI 53184

I, DAVID F. ABELL, DO HEREBY CERTIFY THAT I HAVE SURVEYED THE PROPERTY HEREON
DESCRIBED ACCORDING TO THE OFFICIAL RECORDS AND THAT THE PLAT HEREON IS A
CORRECT REPRESENTATION OF THE PROPERTY LINES TO THE BEST OF MY KNOWLEDGE AND
BELIEF.


David F. Abell

DAVID F. ABELL
WISCONSIN REGISTERED LAND SURVEYOR, S-1596

December 11, 1995

DATE: _____ JOB NUMBER - 95206
NOTE: THIS IS NOT A CERTIFIED COPY UNLESS SEALED.

NOTE: BEARINGS ARE REFERENCED TO
CERTIFIED SURVEY NO. 84.

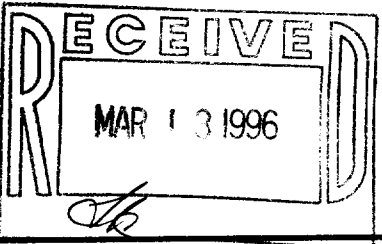

EA-84-1

116-440