


GEORGE T. DUNHAM
SURVEYING & SUBDIVIDING
DELAVER, WISCONSIN

Plat of survey of part of Lots 1, 2, 3, and 4 of
Robert's Subdivision located in Section 11, T 1 N,
R 16 E, Walworth County, Wisconsin
August 15, 1966

George T. Dunham
George T. Dunham, Surveyor

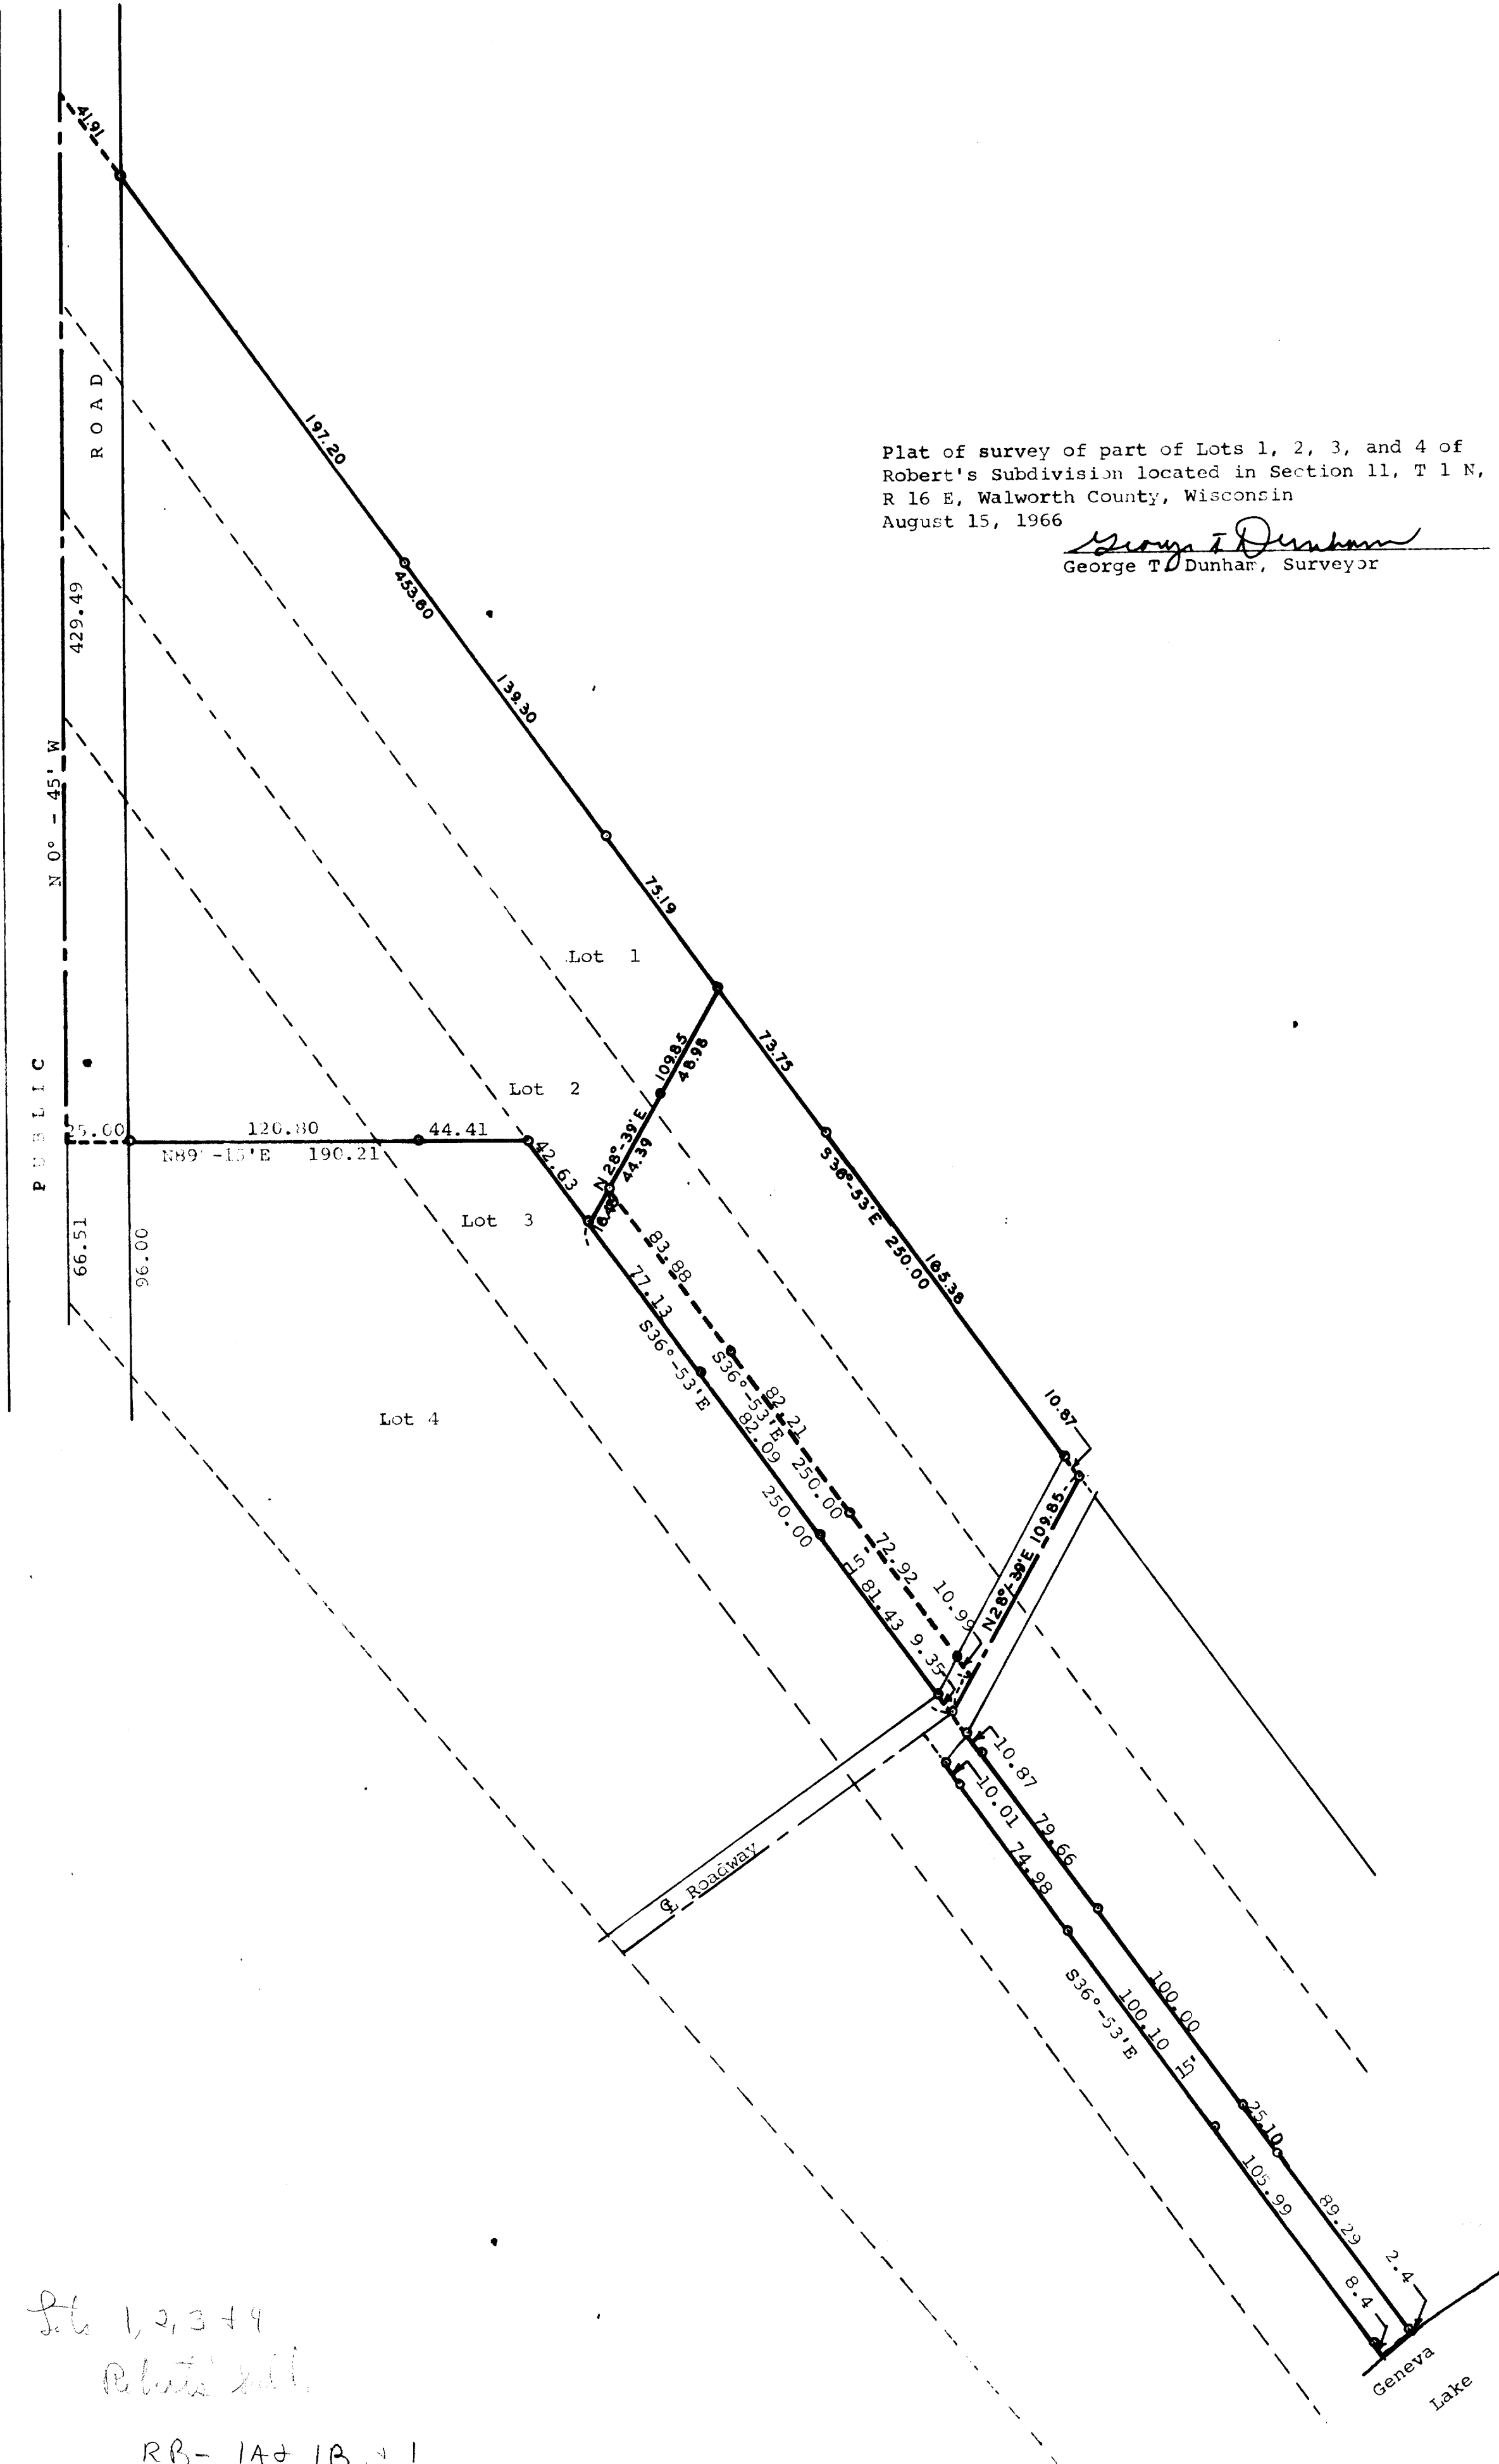

Scale - 1" = 50'
o = Iron Pipe

Pl 1, 2, 3 & 4
Plat 111
RB- 1A+ 1B + 1