

ABERNATHY and ASSOCIATES

Kenneth B. Abernathy Jr.

Wisconsin Registered Land Surveyor S-1594

W4056 Bay Road  
Elkhorn, Wisconsin 53121  
Phone: (414) 723-4280 (office)  
(414) 723-4813 (residence)

PLAT OF SURVEY


Lot 1 of Certified Survey Map Number 1489 as recorded in Volume 7, Page 71 of Certified Survey Maps as Document Number 127525, located in part of the Northeast 1/4 of Section 2, Town 1 North, Range 16 East, Walworth County, Wisconsin.

Ordered by: Lawrence H. Whiting III  
Assistant Vice President  
Senior Loan Officer  
Advantage Bank  
410 Broad Street  
Lake Geneva, Wisconsin 53147

C. S. M. #2096


Owners: Thomas & Patricia Parliment  
3523 Theater Road  
Delavan, Wisconsin 53115

CENTER OF SECTION (760.56')  
SECTION 2-1-16

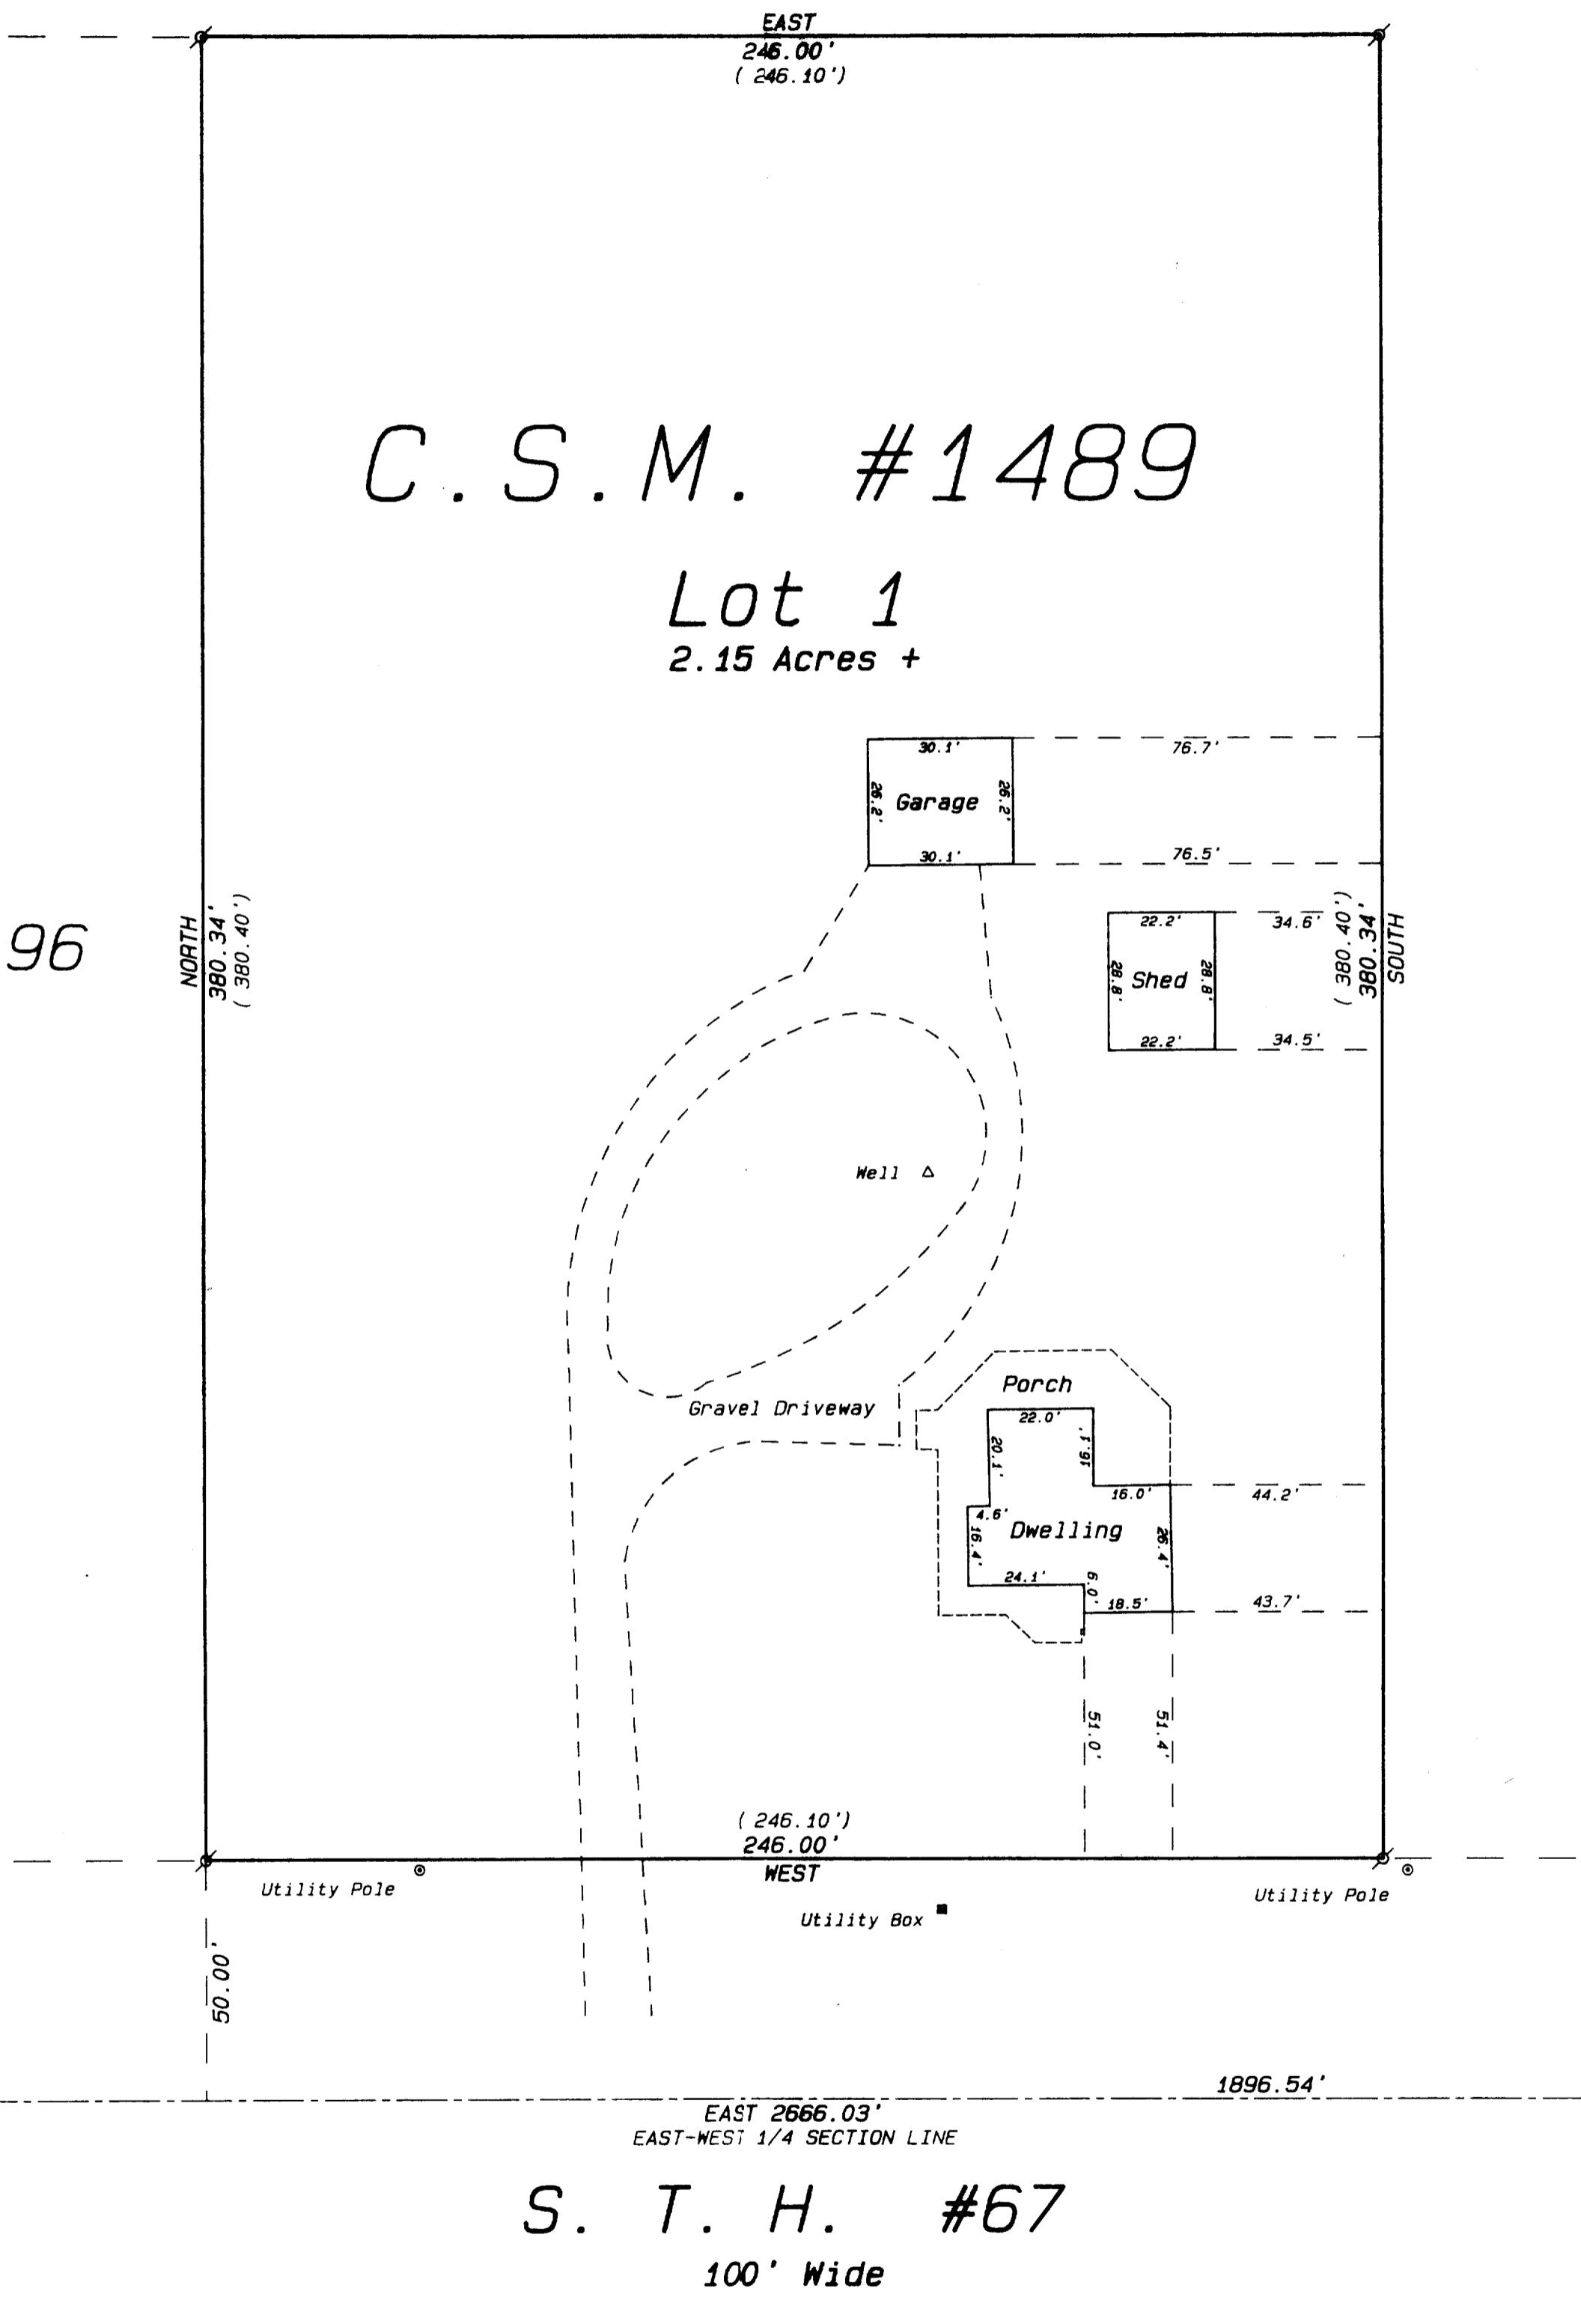

S. T. H. #67  
100' Wide

EAST 1/4 CORNER  
SECTION 2-1-16

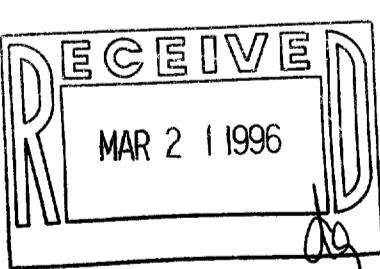

I hereby certify that the above described property has been surveyed by me or under my direction and that the above map is a true representation thereof and shows the size and location of the property, its exterior boundaries, the location of all visible structures and other features and the location of all visible apparent easements, roadways and visible encroachments, if any.

This survey is made for the use of the present owners of the property, and also those who purchase the property, or guarantee the title thereto within one year from date hereof.



KENNETH B. ABERNATHY, JR.  
WISCONSIN REGISTERED LAND SURVEYOR  
S-1594

Date: February 12, 1996 Job No. 1996-208

SCALE: 1" = 30 FEET

I hereby certify that the above described property has been surveyed by me or under my direction and that the above map is a true representation thereof and shows the size and location of the property, its exterior boundaries, the location of all visible structures and other features and the location of all visible apparent easements, roadways and visible encroachments, if any.

This survey is made for the use of the present owners of the property, and also those who purchase the property, or guarantee the title thereto within one year from date hereof.

KENNETH B. ABERNATHY, JR.  
WISCONSIN REGISTERED LAND SURVEYOR  
S-1594

Date: February 12, 1996 Job No. 1996-208