


DUNHAM, GEORGE T. C.
SURVEYOR

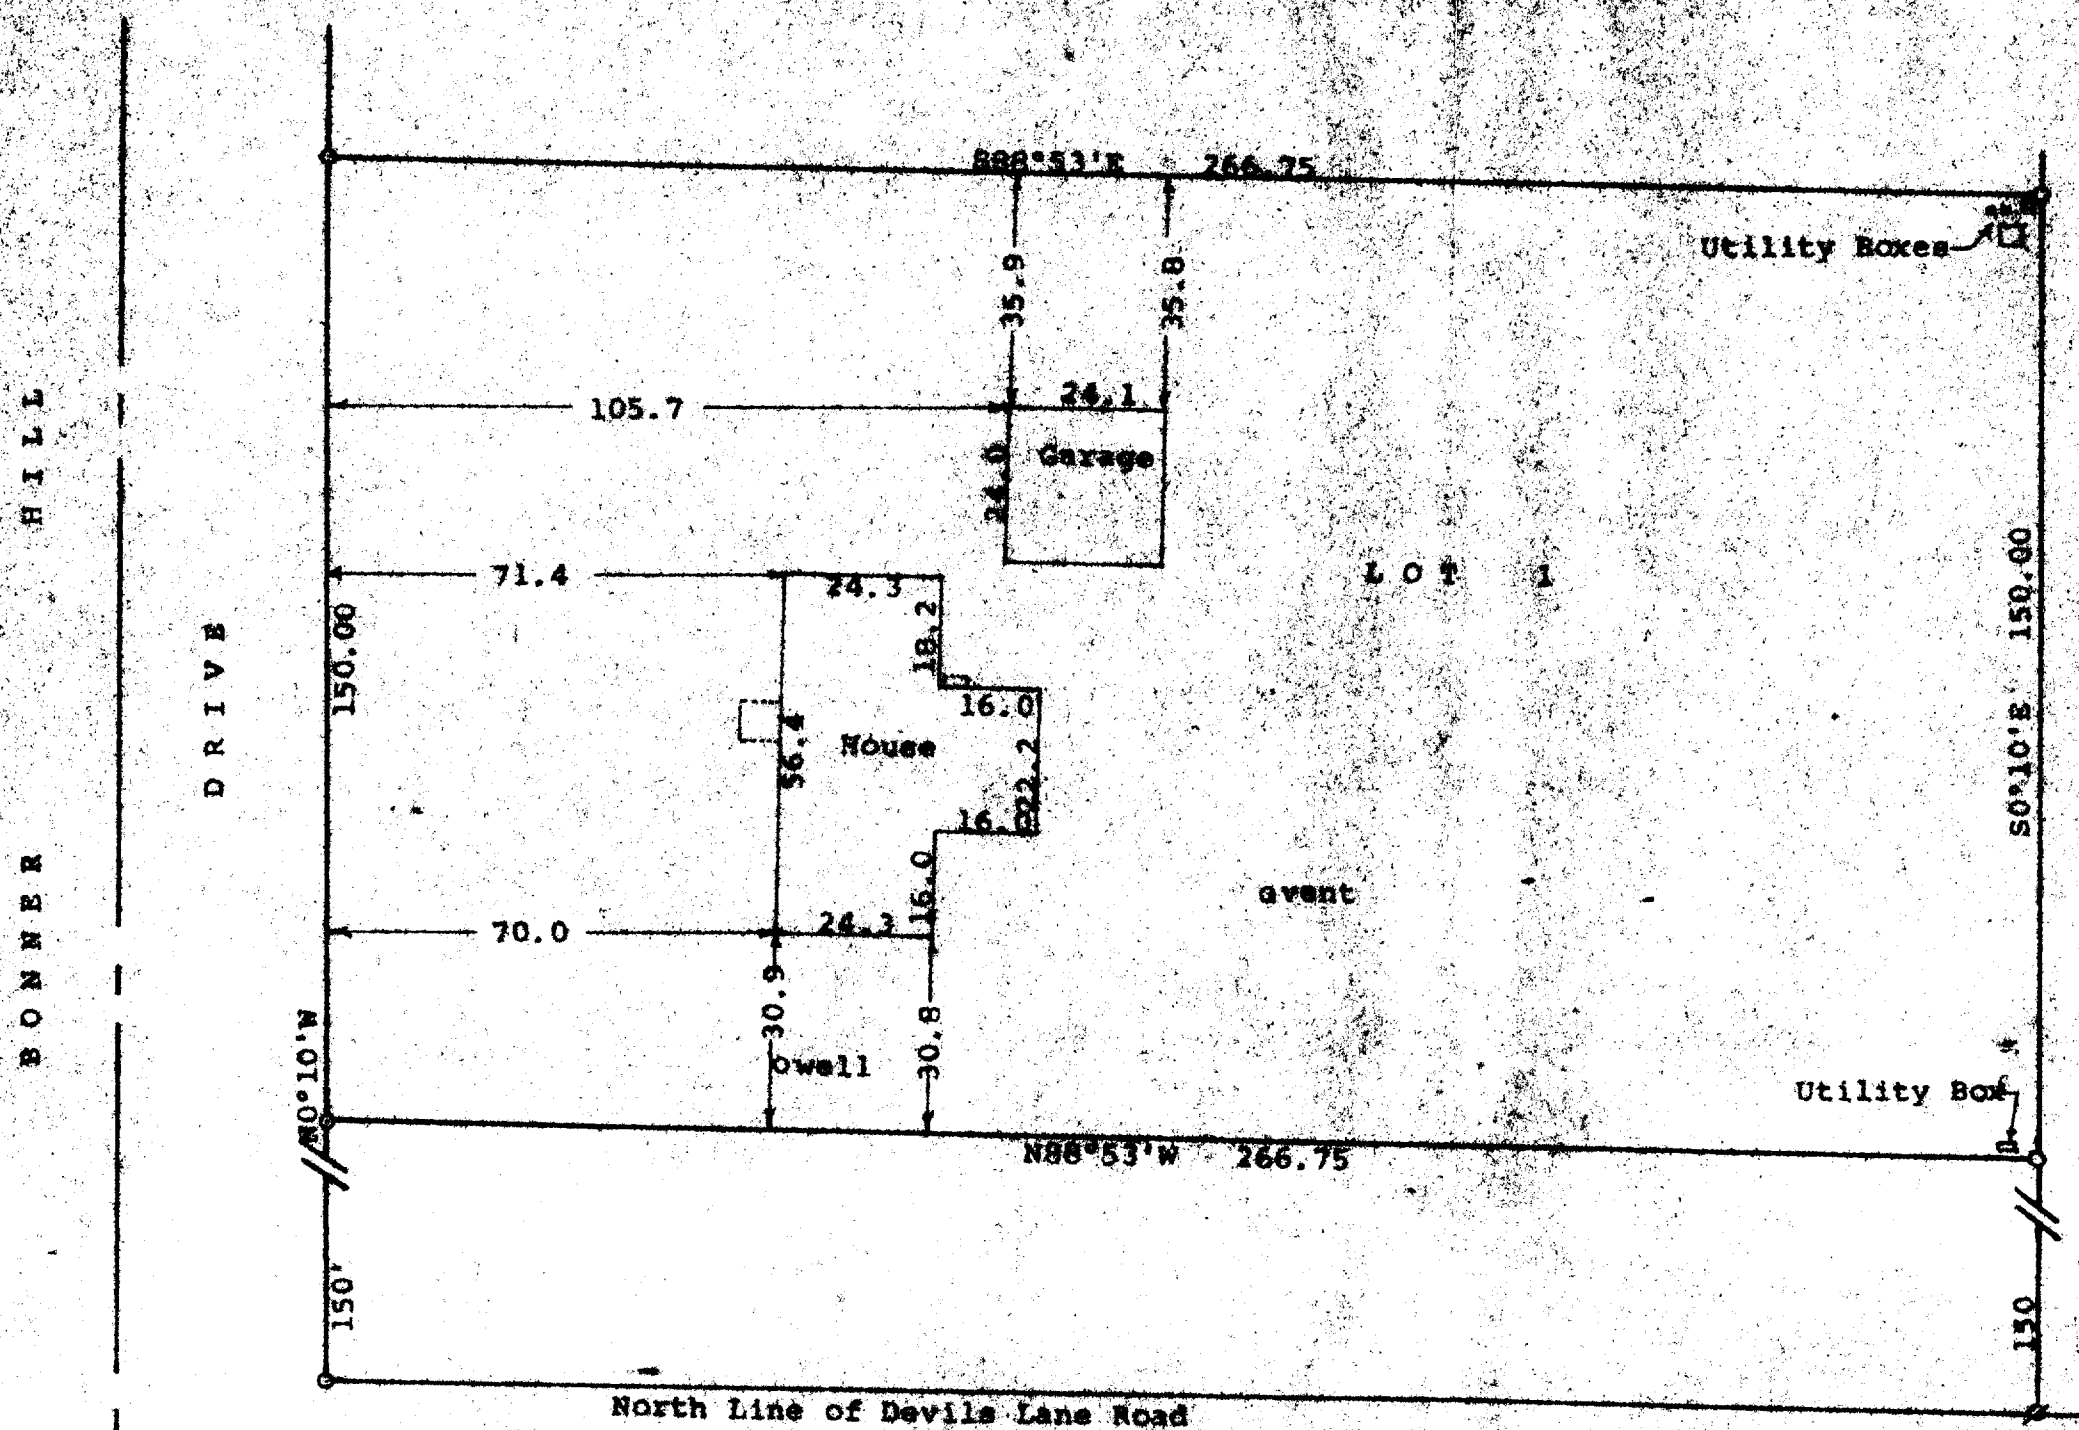



N

Scale - 1" = 30'
 P = 2" Iron Pipe Found
 O = 3/4" Iron Pipe Found
 Bearings are those on the recorded
 plat of Certified Survey No. 264
 Survey ordered by: The Rauland Agency
 118 Kenosha
 Walworth, WI 53184

STATE OF WISCONSIN) SS
 COUNTY OF WALWORTH)

I, George T. Dunham, Surveyor, certify that I have surveyed the property described as follows:
 Lot 1 of Certified Survey No. 264, recorded in Volume 2 of Certified Surveys on Page 15, Document No. 666696, in the Office of the Register of Deeds, Walworth County, Wisconsin, and being a parcel of land located in the Southeast 1/4 of Section 22, T 1 N, R 16 E, Walworth County, Wisconsin.
 and that the plat shown hereon is a correct representation thereof and shows the size and location of the property, its exterior boundaries, the location of all visible structures and dimensions of all principal buildings thereon, boundary fences, apparent easements, roadways and visible encroachments, if any, and that I have surveyed the property hereon described, according to the official records, to the best of my knowledge and belief.
 June 15, 1993

George T. Dunham
 George T. Dunham, Surveyor

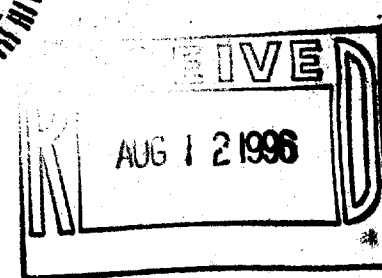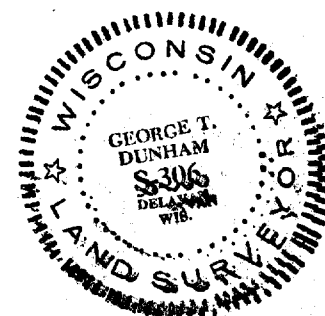

EA-264-1

116-485