



HH

PLAT OF SURVEY

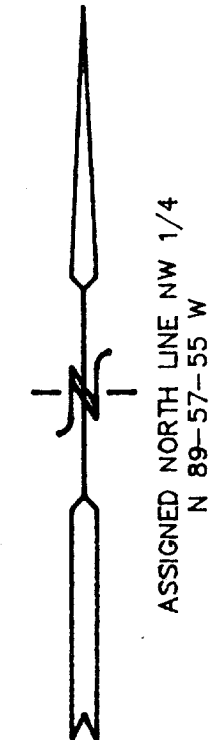


WORK ORDERED BY
JANE BRANDLEY
731 MILWAUKEE STREET
LAKE GENEVA, WI. 53147

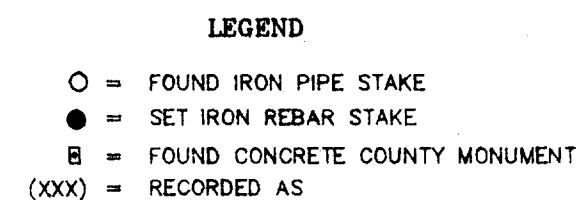


I HEREBY CERTIFY THAT THE ABOVE DESCRIBED PROPERTY HAS BEEN SURVEYED UNDER MY DIRECTION AND THAT THE ABOVE MAP IS A TRUE REPRESENTATION THEREOF AND SHOWS THE SIZE AND LOCATION OF THE PROPERTY AND ITS EXTERIOR BOUNDARIES. THIS SURVEY IS MADE FOR THE USE OF THE PRESENT OWNERS OF THE PROPERTY, AND ALSO THOSE WHO PURCHASE, MORTGAGE, OR GUARANTEE THE TITLE THERETO WITHIN ONE YEAR FROM THE DATE HEREOF.

Peter S. Gordon
PETER S. GORDON R.L.S. 2101

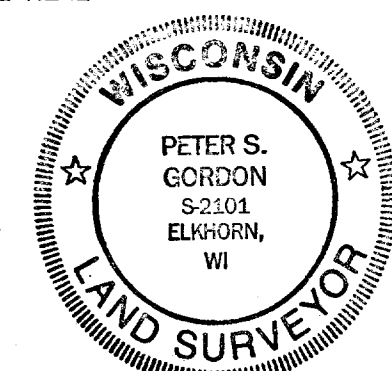

A PARCEL OF LAND BEING LOCATED IN THE NORTHWEST 1/4 OF THE NORTHWEST 1/4 OF SECTION 5, TOWN 1 NORTH, RANGE 16 EAST, WALWORTH COUNTY, WISCONSIN; DESCRIBED AS LOTS 30 THROUGH 35 OF BLOCK 4 OF ROBBINS SUBDIVISION; AND OUTLOT 1 OF CERTIFIED SURVEY MAP NO. 2738, RECORDED IN VOLUME NO. 14 ON PAGE NO. 92 AS DOCUMENT NO. 338752 OF WALWORTH COUNTY CERTIFIED SURVEY MAPS; AND A PARCEL DESCRIBED AS BEGINNING AT AN IRON PIPE STAKE FOUND MARKING THE SOUTHEAST CORNER OF LOT 35 OF BLOCK 4 OF ROBBINS SUBDIVISION; THENCE S 00DEG 20MIN 12SEC E, 20.03 FEET; THENCE N 89DEG 52MIN 12SEC W, 32.68 FEET; THENCE N 00DEG 10MIN 02SEC W, 20.04 FEET TO THE SOUTH LINE OF SAID ROBBINS SUBDIVISION; THENCE S 89DEG 50MIN 37SEC E, 32.62 FEET TO THE POINT OF BEGINNING, CONTAINING A TOTAL AREA OF 21,800 SQUARE FEET OF LAND (0.50 ACRES) MORE OR LESS.

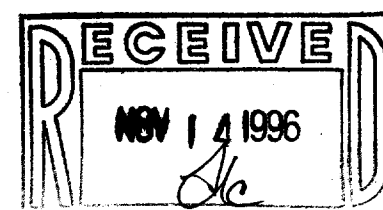

EA-2738-3

PROJECT NO.
4559
DATE:
10/25/96
SHEET NO.
1 OF 1

116-458