
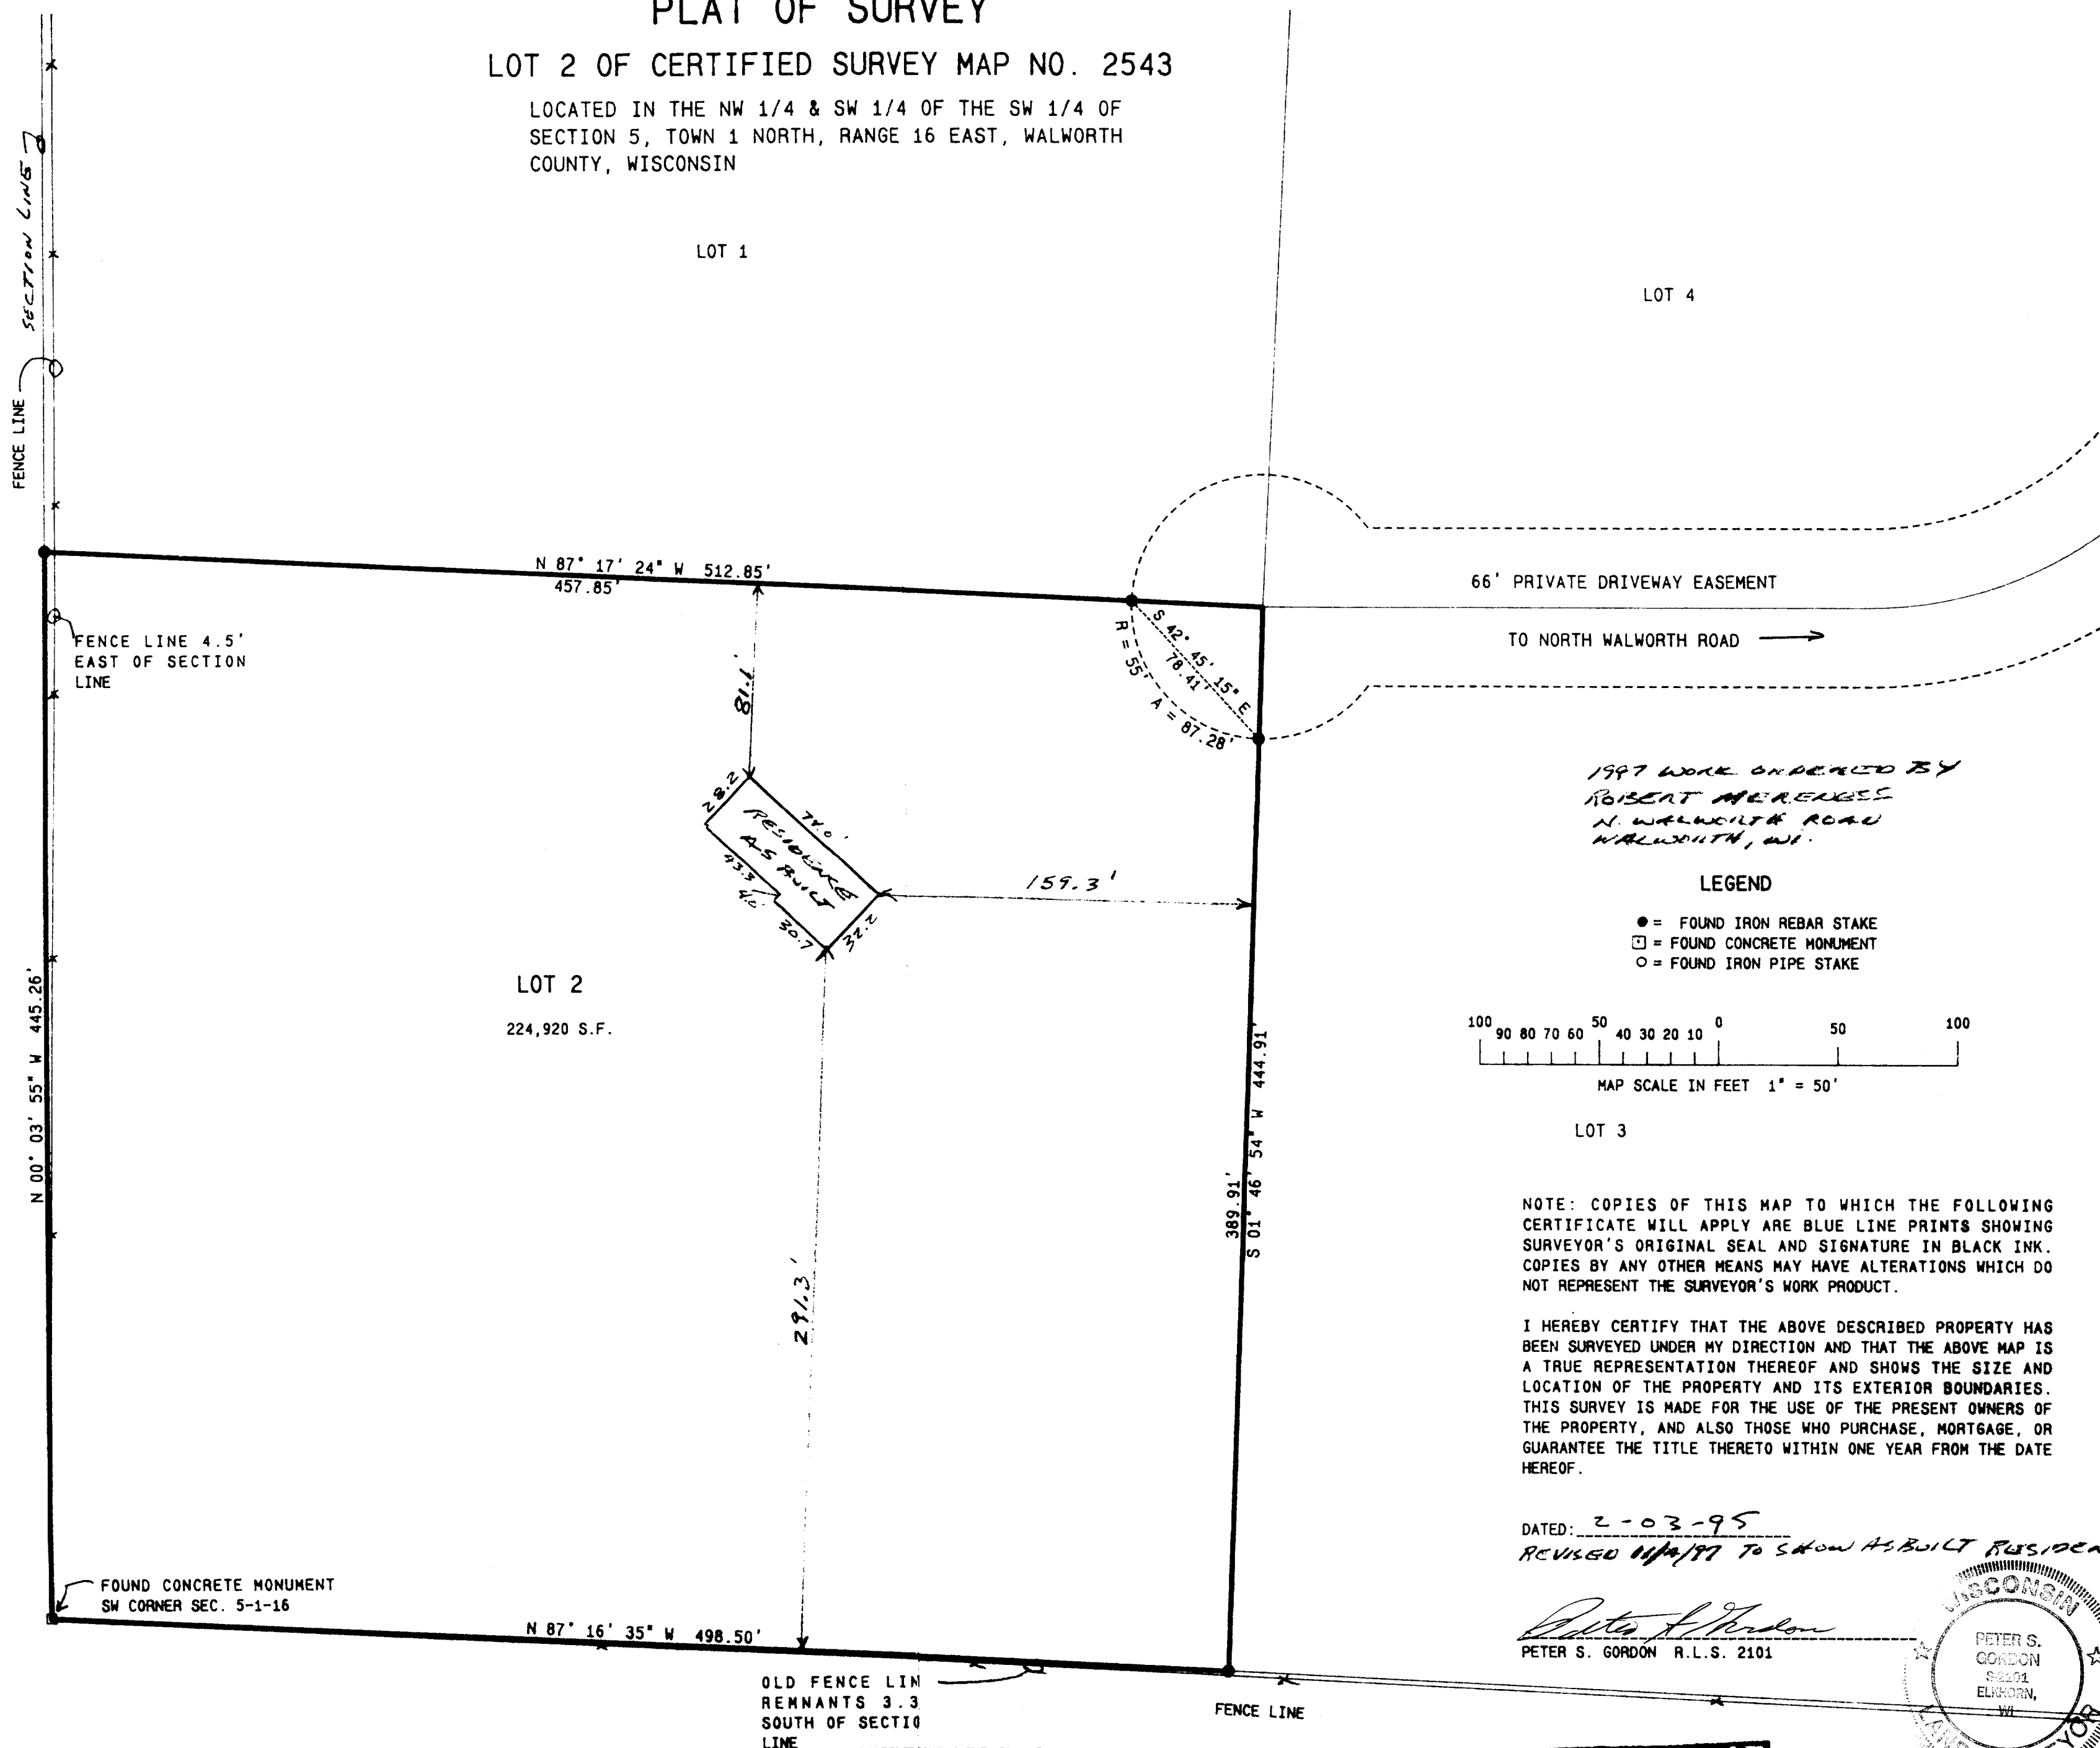


4094

PLAT OF SURVEY

LOT 2 OF CERTIFIED SURVEY MAP NO. 2543

LOCATED IN THE NW 1/4 & SW 1/4 OF THE SW 1/4 OF
SECTION 5, TOWN 1 NORTH, RANGE 16 EAST, WALWORTH
COUNTY, WISCONSIN

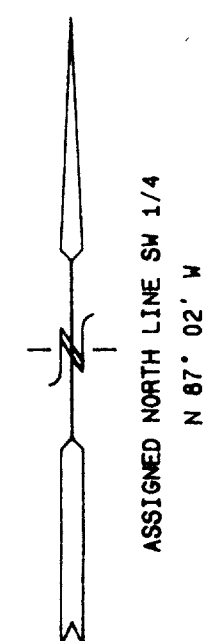

WORK ORDERED BY: DAN OLESTON
CENTURY 21
312 S. 7TH ST.
DELAVER, WISCONSIN

LOT 2 OF CERTIFIED SURVEY MAP
NO. 2543, REC. IN VOL. 12, PG.
315, AS DOC. NO. 298648

FARRIS, HANSEN & ASSOCIATES, INC.
Engineering, Architecture, Surveying
7 Ridgeway Court, P.O. Box 437
ELKHORN, WISCONSIN 53121
Office: (414) 723-2098
Fax: (414) 723-5886

REVISIONS

PROJECT NO.
4094
DATE
02-03-95
SHEET NO.
1 OF 1

EA-2543-2
116-491

RECEIVED
DEC 26 1997