

PLAT OF SURVEY




LOTS 7 -11 INCLUSIVE OF ROLLING OAKS
ESTATES, AND PART OF THE SOUTHWEST 1/4
OF THE NORTHEAST 1/4 OF SECTION 7. TOWN
1 NORTH, RANGE 16 EAST, WALWORTH COUNTY,
WISCONSIN

OWNERS: HAROLD, LORNE AND DEAN DORN
11059 CHERRY DR. S.E.
BONITA SPRINGS, FLA 33923

ORDERED BY: MATT MILLER/ RAULAND AGENCY
P.O. BOX 159
WALWORTH, WI. 53184

LINE	BEARING	DISTANCE
L1	N 15°25'15" E	35.03
L2	N 0°18'15" E	33.00
L3	N 23°10'39" E	33.71

CURVE	ARC	DELTA	RADIUS	CHORD LENGTH	CHORD BEARING
C1	100.18	11°07'24"	516.00	100.02	S 11°31'27" E
C2	124.98	13°52'40"	516.00	124.68	S 24°01'29" E
C3	20.80	47°40'00"	25.00	20.20	S 4°42'36" E
C4	118.11	102°32'06"	66.00	102.97	S 31°04'21" E
C5	109.43	94°59'57"	66.00	97.32	N 50°09'37" E
C6	95.94	83°17'00"	66.00	87.71	N 38°58'51" W
C7	22.00	50°25'44"	25.00	21.30	N 56°29'37" W
C8	196.36	25°00'04"	450.00	194.80	N 18°27'47" W
C9	42.40	97°10'35"	25.00	37.50	N 42°34'26" E

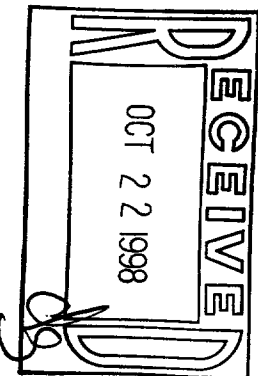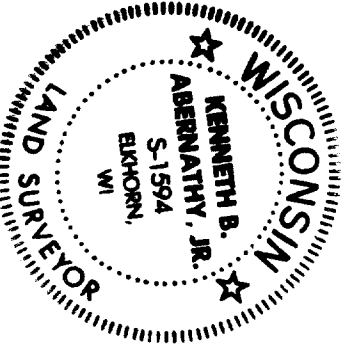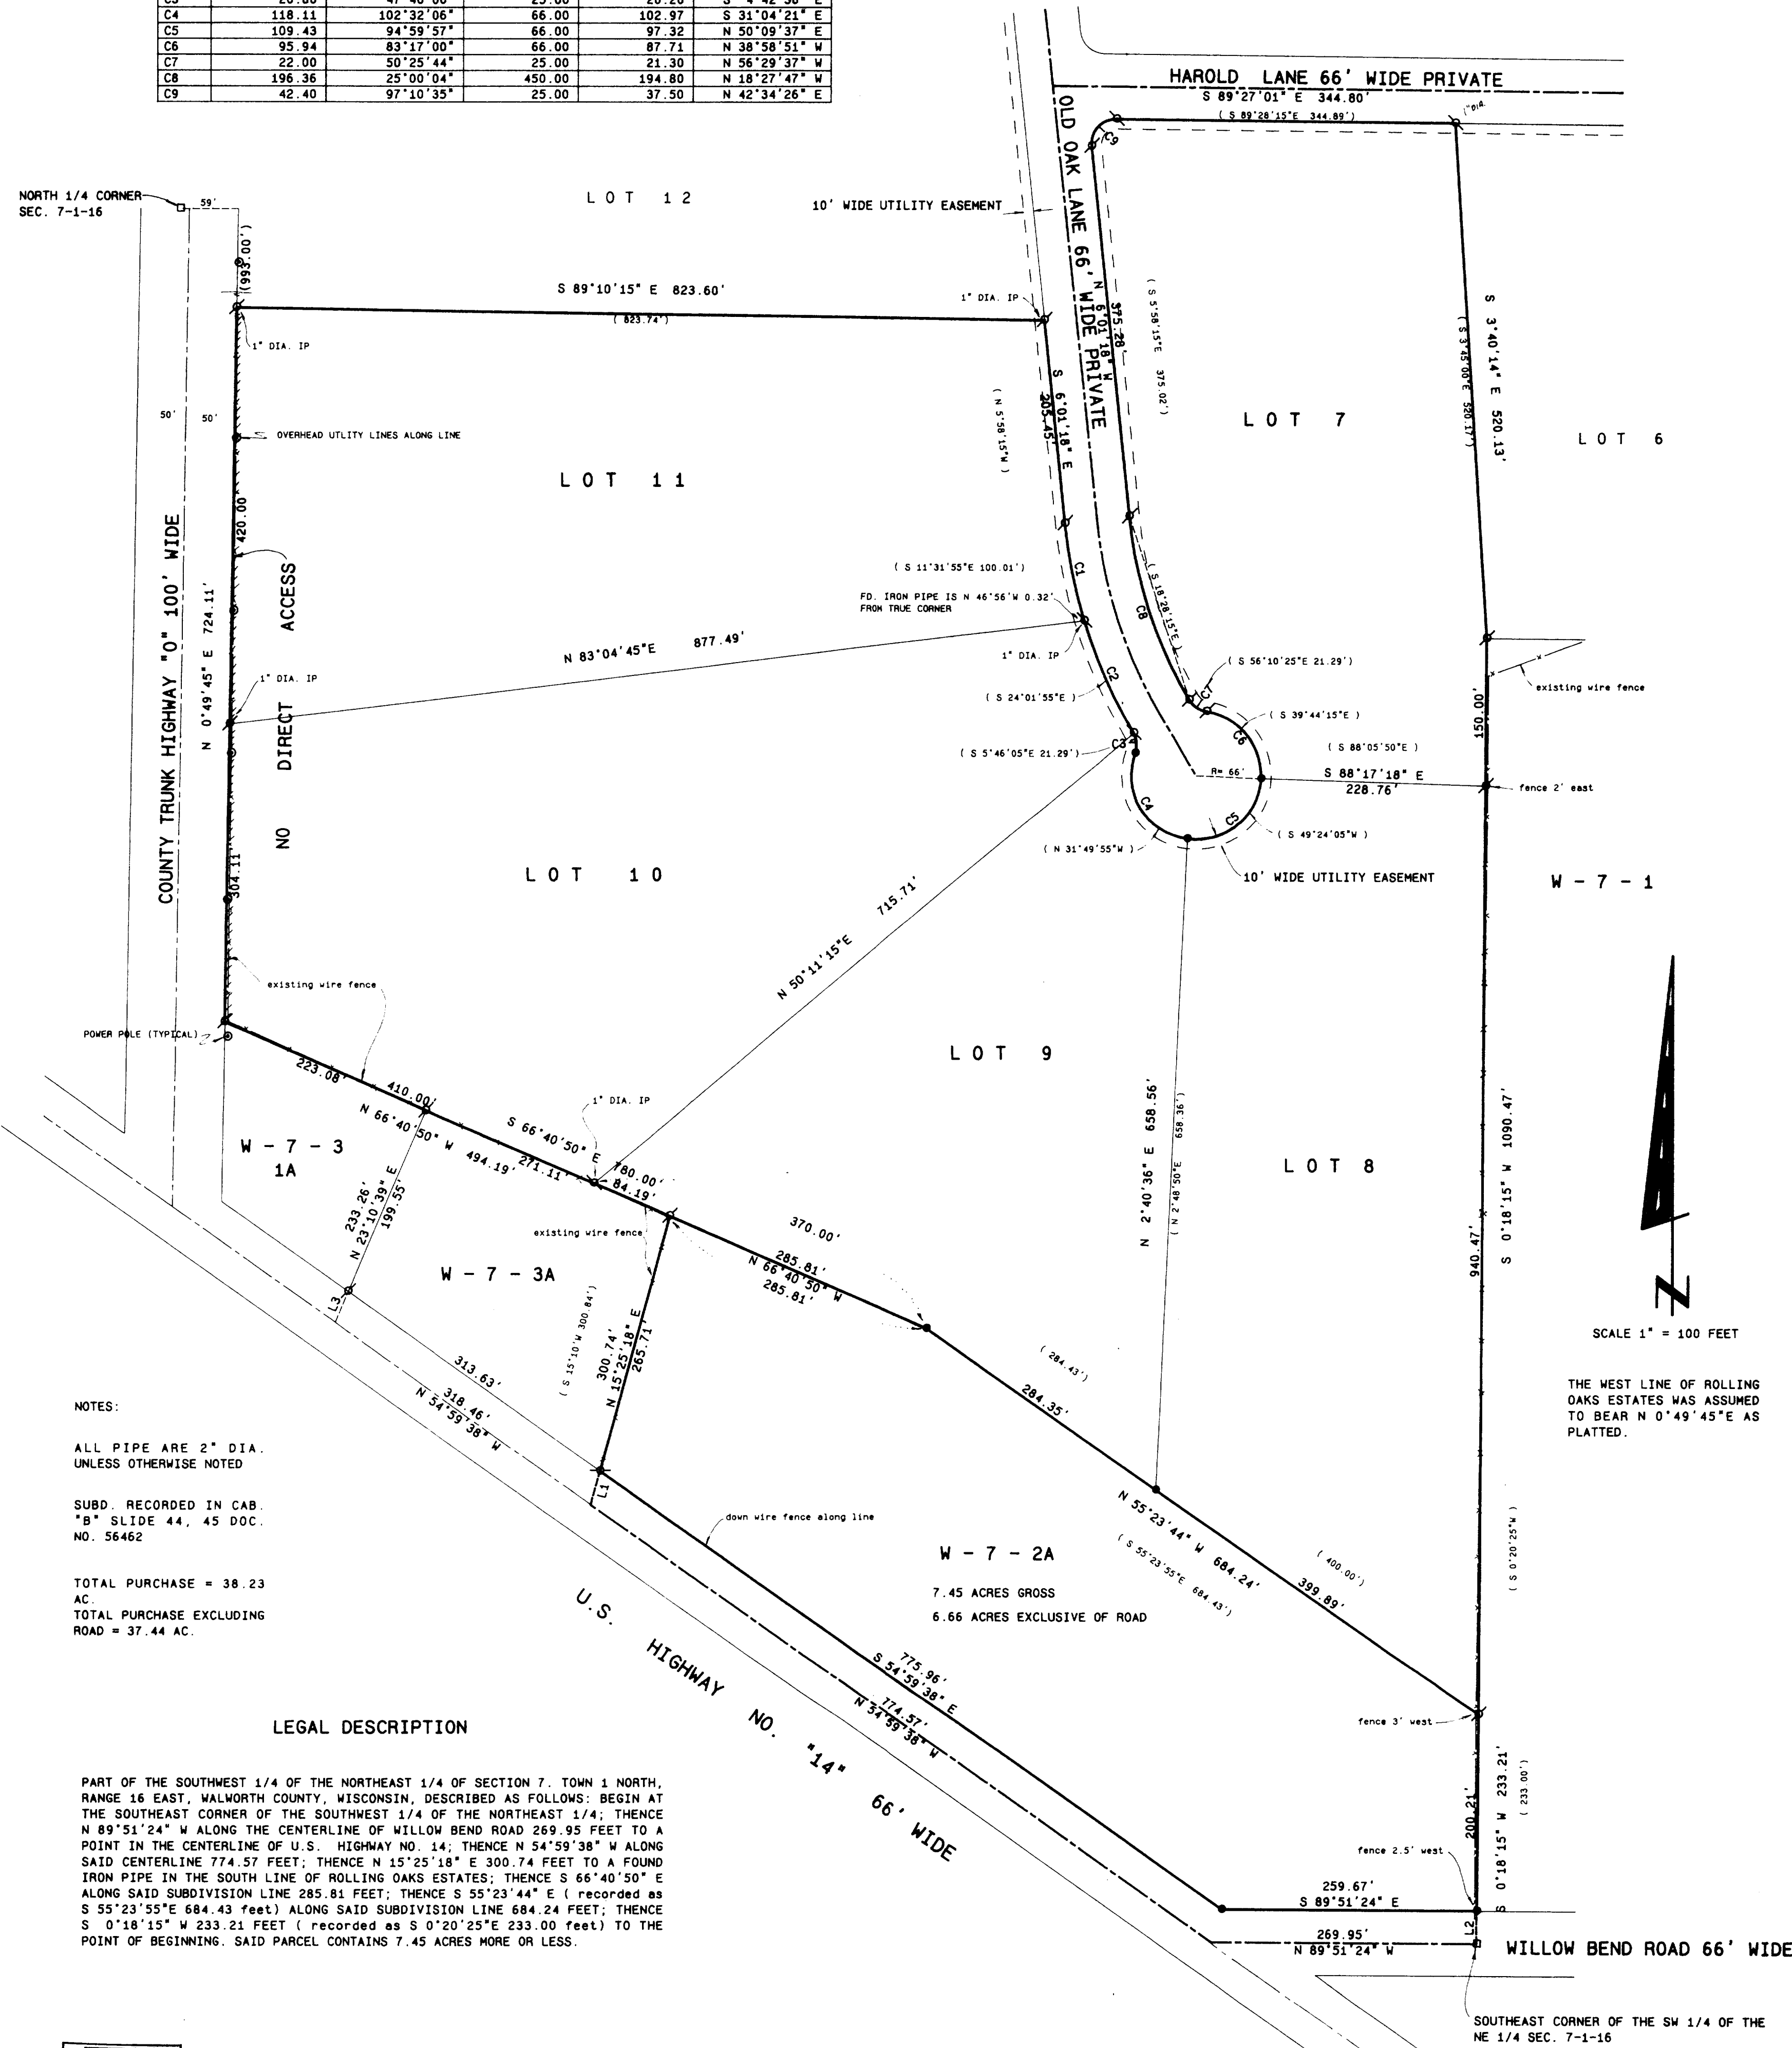

SCALE: 1" = 100 FEET

- Legend
- FOUND IRON PIPE
 - FOUND BRASS CAPED MONUMENT
 - FOUND CONCRETE MONUMENT
 - CHISEL CUT IN CONCRETE
 - SET IRON ROD, 2" LONG, READING 1.5 LBS. UNLESS FT. 1.11" DIA.
 - RECORDED AS DIMENSION
 - EXISTING FENCE

ERO - 7
ERO - 8
ERO - 9
ERO - 10
ERO - 11
116-508

Kenneth B. Abernathy, Jr.
Kenneth B. Abernathy, Jr.
Wisconsin Registered Land Surveyor
S-1894
Date: Sept. 16, 1998 Job No. 18116