
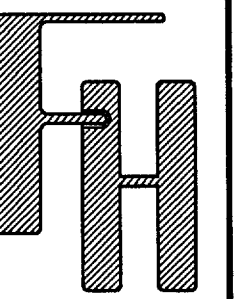


PLAT OF SURVEY
LOT 12 OF DEER PATH ESTATES

LOCATED IN THE SE & SW 1/4'S OF THE SE 1/4
OF SECTION 6, TOWN 1 NORTH, RANGE 16 EAST,
TOWN OF WALWORTH, WALWORTH COUNTY, WISCONSIN

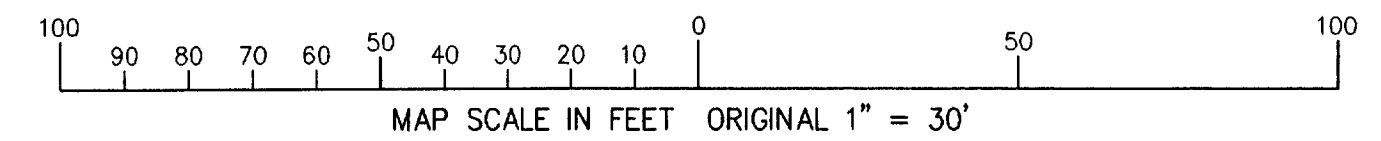

LOT 12 OF DEER PATH ESTATES
TOWN OF WALWORTH
WALWORTH COUNTY, WISCONSIN

WORK ORDERED BY -
BERNARD KAUFMANN
P.O. BOX 409
FONTANA, WI. 53125

FARRIS, HANSEN & ASSOCIATES, INC.
Engineering, Architecture, Surveying
7 Ridgway Court P.O. Box 437
ELKHORN, WISCONSIN 53121
Office: (414) 723-2098
Fax: (414) 723-5856

REVISIONS

PROJECT NO.
4633.12
DATE
11/02/98
SHEET NO.
1 OF 1

FOUND IRON PIPE STAKE
N 85-23 W, 5.7' FROM
RECORD CORNER

16.5' WIDE
UTILITY
EASEMENT

LANDSCAPE
AND VISION
CORNER
EASEMENT

12' WIDE
UTILITY
EASEMENT

LIMITED BUILDING
AREA

STORM
WATER
MANAGEMENT
EASEMENT

10' UTILITY
EASEMENT

EXTG.
GRAVEL
ENTRY

LOT 12
287,292 S.F.

AS BUILT RESIDENCE


SAVANNAH
LANE

NOTE: COPIES OF THIS MAP TO WHICH THE FOLLOWING CERTIFICATE WILL APPLY SHOW SURVEYOR'S
ORIGINAL SEAL AND SIGNATURE IN RED INK. COPIES BY ANY OTHER MEANS MAY HAVE ALTERATIONS
WHICH DO NOT REPRESENT THE SURVEYOR'S WORK PRODUCT.

I HEREBY CERTIFY THAT THE ABOVE DESCRIBED PROPERTY HAS BEEN SURVEYED UNDER MY DIRECTION
AND THAT THE ABOVE MAP IS A TRUE REPRESENTATION THEREOF AND SHOWS THE SIZE AND LOCATION OF
THE PROPERTY AND ITS EXTERIOR BOUNDARIES. THIS SURVEY IS MADE FOR THE USE OF THE PRESENT
OWNERS OF THE PROPERTY, AND ALSO THOSE WHO PURCHASE, MORTGAGE, OR GUARANTEE THE TITLE
THERETO WITHIN ONE YEAR FROM THE DATE HEREOF.

DATED: 3-26-99

PETER S. GORDON R.L.S. 2101

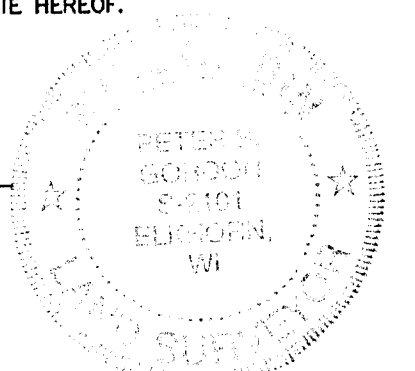


LEGEND

- = FOUND IRON REBAR STAKE, 3/4" DIA.
- = FOUND IRON PIPE STAKE, 1" DIA.
- ▣ = FOUND CONCRETE COUNTY
MONUMENT W/ BRASS CAP
- = FOUND SOLID ROUND IRON BAR STAKE
1 5/16" X 30" X 4.60 LBS./FT.

(XXX) = RECORDED AS

R = 867.00
A = 462.37
C = 456.91
N 62-11-28.0 W

LOT 2

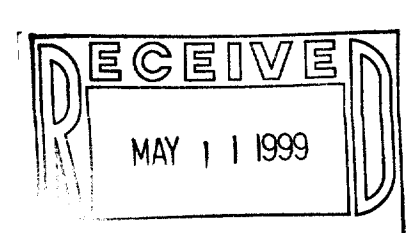

MAR 26 1999

116-528

ENR-12