


ABELL
SURVEYING & MAPPING

1140 SEQUOIA STREET • DELAVAN, WISCONSIN 53115
414-728-6737

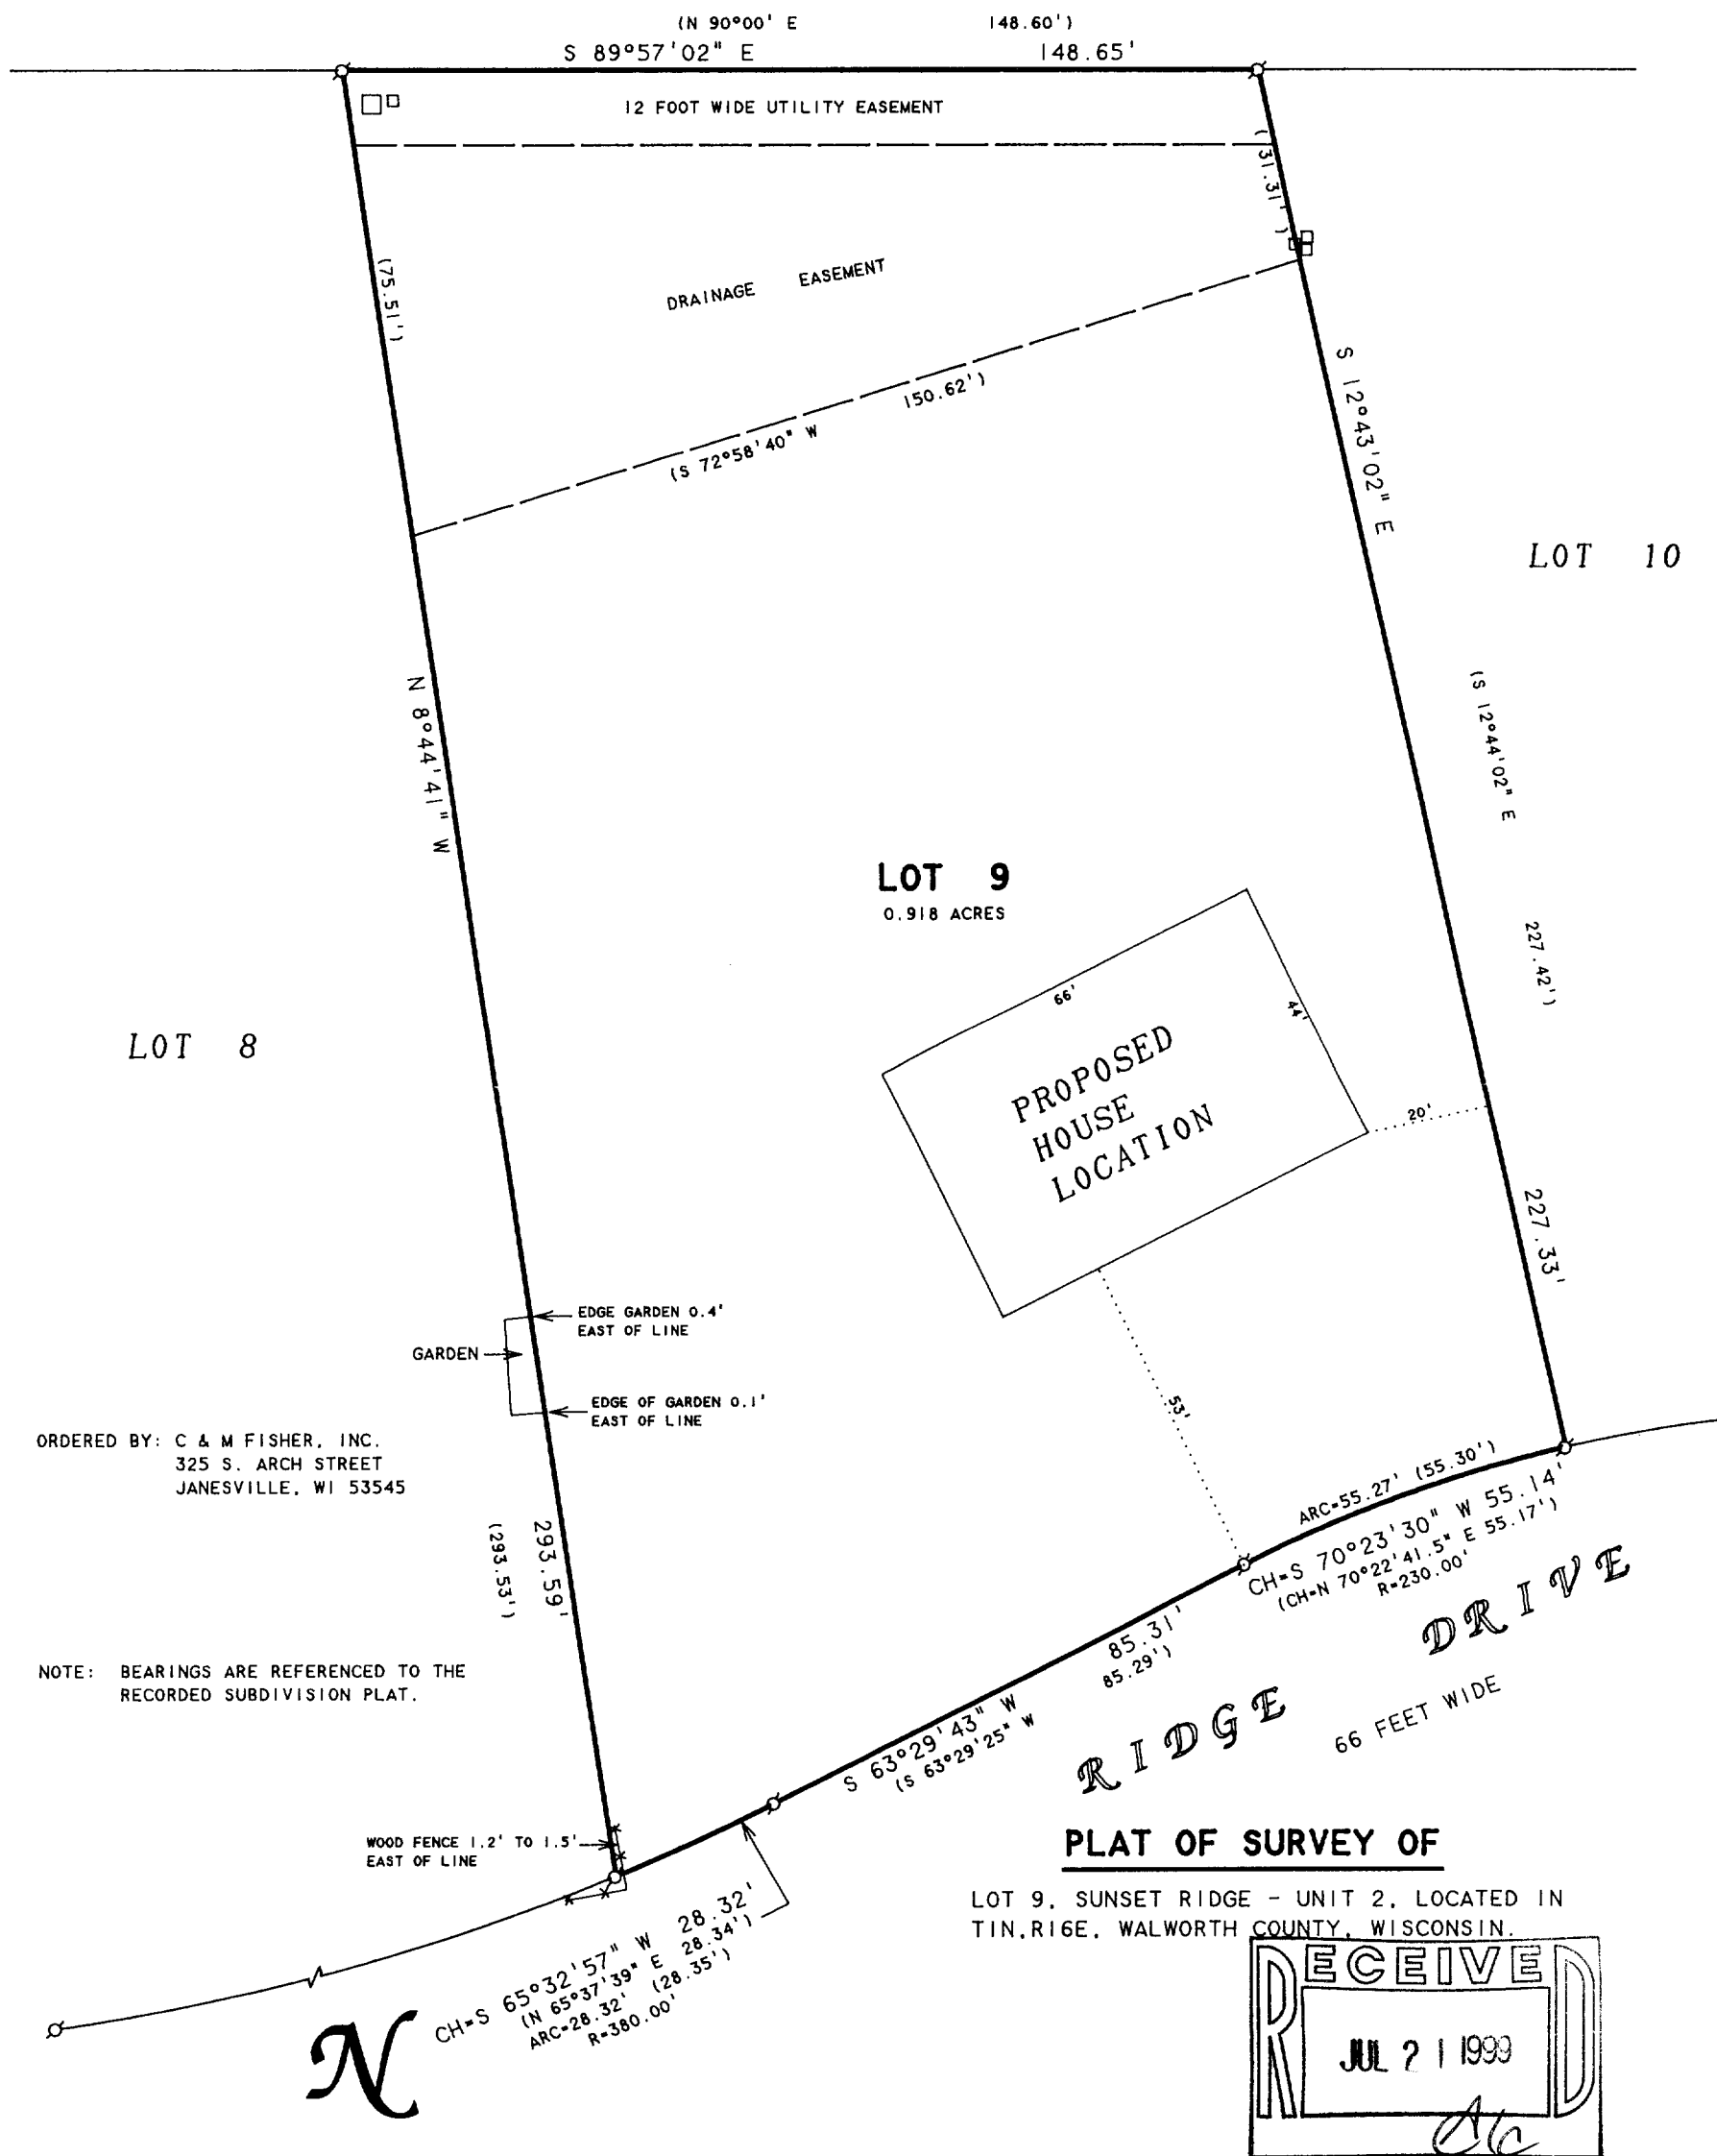

ORDERED BY: C & M FISHER, INC.
325 S. ARCH STREET
JANESVILLE, WI 53545

NOTE: BEARINGS ARE REFERENCED TO THE
RECORDED SUBDIVISION PLAT.

N


SCALE 1"=30'

LEGEND

○ - IRON PIPE FOUND
□ - UTILITY PEDS

PLAT OF SURVEY OF

LOT 9, SUNSET RIDGE - UNIT 2, LOCATED IN
TIN RIDGE, WALWORTH COUNTY, WISCONSIN.

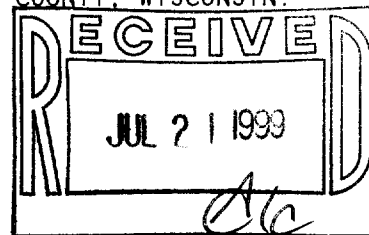

I, DAVID F. ABELL, DO HEREBY CERTIFY THAT I HAVE SURVEYED THE PROPERTY HEREON
DESCRIBED ACCORDING TO THE OFFICIAL RECORDS AND THAT THE PLAT HEREON IS A
CORRECT REPRESENTATION OF THE PROPERTY LINES TO THE BEST OF MY KNOWLEDGE AND
BELIEF.

David F. Abell

DAVID F. ABELL
WISCONSIN REGISTERED LAND SURVEYOR, S-1596

February 20, 1999

DATE JOB NUMBER - 99014
NOTE: THIS IS NOT A CERTIFIED COPY UNLESS SEALED.

ESS-2

116-530