
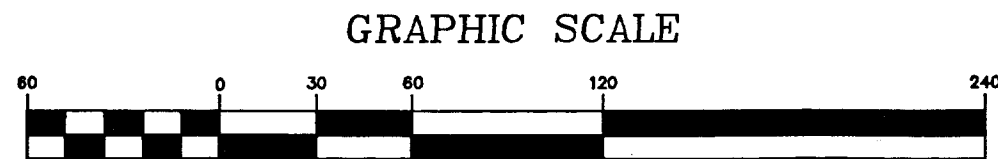
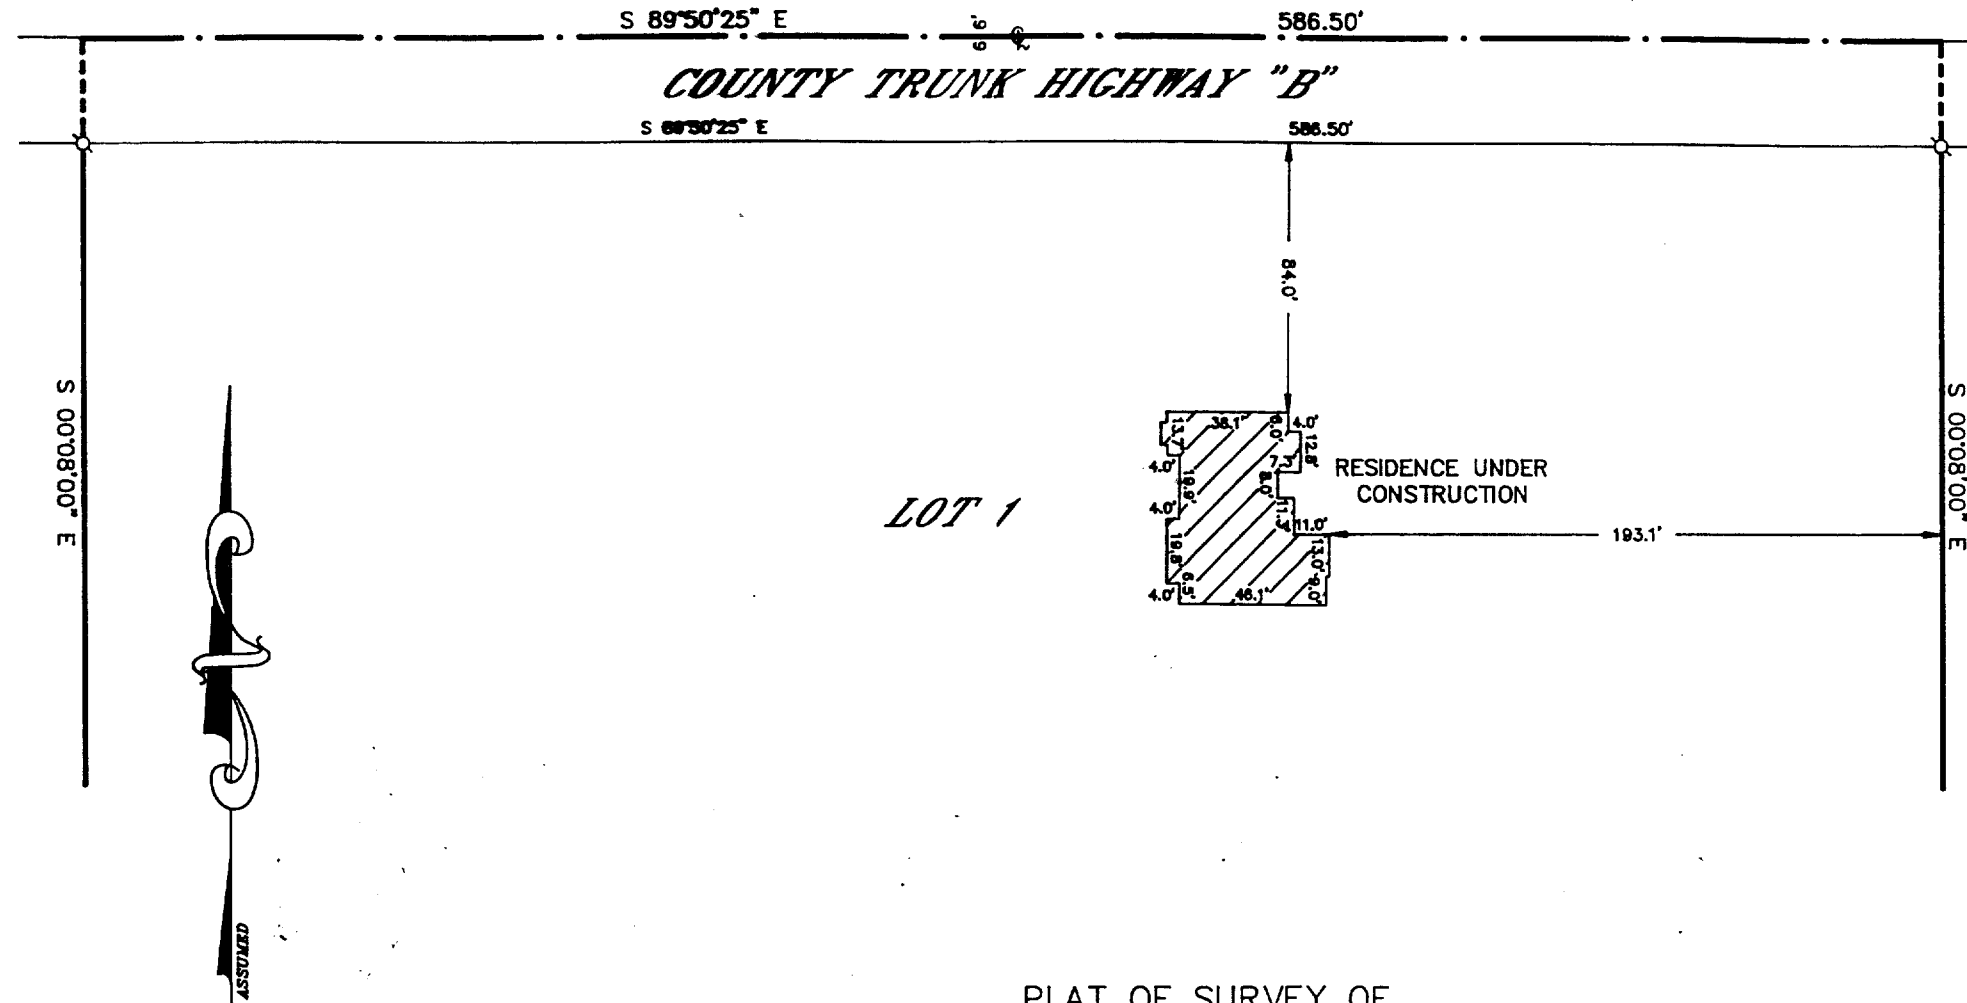


WALWORTH COUNTY
SURVEYING & MAPPING
P. O. BOX 1115
LAKE GENEVA, WISCONSIN
414-248-0505

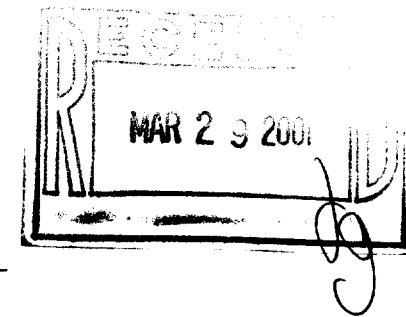

GRAPHIC SCALE

(IN FEET)
1 inch = 60 ft.

Ø-IRON PIPE FOUND
Ø-IRON ROD FOUND
■-CONCRETE MONUMENT FOUND
○-IRON PIPE PLACED
()-RECORDED AS

PLAT OF SURVEY OF

PART OF LOT 1 OF CERTIFIED SURVEY MAP NO. 1263, LOCATED IN THE NORTHWEST 1/4 OF THE SOUTHEAST 1/4 OF SECTION 24, T 1 N, R 16 E, WALWORTH COUNTY, WISCONSIN.

ORDERED BY: FISCHER FINE HOME BUILDING, INC.
813 SOUTH LAKE SHORE DRIVE
LAKE GENEVA, WISCONSIN
53147

I HEREBY CERTIFY THAT I HAVE SURVEYED THE PROPERTY HEREON DESCRIBED AND THAT THE RESIDENCE LOCATION SHOWN HEREON IS CORRECT TO THE BEST OF MY KNOWLEDGE AND BELIEF.

Robert M. Baerrenwald
ROBERT M. BAERRENNWALD
WISCONSIN REGISTERED LAND SURVEYOR, S-1508

Oct. 12, 1997
DATE JOB NO. 5638

NOTE: THIS IS NOT A CERTIFIED COPY UNLESS SEALED.

116-577

EA-1263-1