

ABELL
SURVEYING & MAPPING
1140 SEQUOIA STREET • DELAVAN, WISCONSIN 53115
262-728-6737

REVISED DATE: JANUARY 17, 2002
REVISED TO SHOW HOUSE UNDER CONSTRUCTION

ORDERED BY: ZELL WOODWORKING, INC.
1299 CENTER STREET
DELAVAN, WI 53115

LINE TABLE			
LINE	BEARING	DISTANCE	RECORDED AS
L1	CH-N 29°31'42" W	94.68'	S 29°30'13.5" E 94.71'
L2	N 89°24'42" E	75.00'	N 89°14'22" E


NOTE: BEARINGS ARE REFERENCED TO THE
RECORDED SUBDIVISION PLAT.



SCALE 1"=80'

LEGEND

- - IRON PIPE FOUND
- - IRON ROD FOUND
- - IRON BAR FOUND
- - UTILITY PEDS.
- () - RECORDED AS

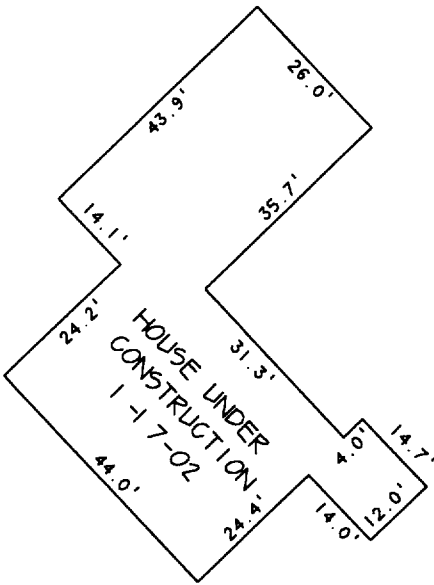

DETAIL SCALE 1"=30'

PLAT OF SURVEY OF

LOT 7, DEER PATH ESTATES, LOCATED IN THE SOUTHEAST 1/4
OF SECTION 6, T1N, R16E, WALWORTH COUNTY, WISCONSIN.

I HEREBY CERTIFY THAT I HAVE SURVEYED THE ABOVE DESCRIBED PROPERTY AND THAT THE
ABOVE MAP IS A TRUE REPRESENTATION THEREOF AND SHOWS THE SIZE AND LOCATION OF
THE PROPERTY, ITS EXTERIOR BOUNDARIES, THE LOCATION OF ALL VISIBLE STRUCTURES
AND DIMENSIONS OF ALL PRINCIPAL BUILDINGS THEREON, BOUNDARY FENCES, APPARENT
EASEMENTS, ROADWAYS AND VISIBLE ENCROACHMENTS, IF ANY, TO THE BEST OF MY
KNOWLEDGE AND BELIEF.

THIS SURVEY IS MADE FOR THE USE OF THE PRESENT OWNERS OF THE PROPERTY, AND ALSO
THOSE WHO PURCHASE, MORTGAGE, OR GUARANTEE THE TITLE THERETO WITHIN ONE (1) YEAR
FROM DATE HEREON.

David F. Abell

DAVID F. ABELL
WISCONSIN REGISTERED LAND SURVEYOR, S-1596

November 27, 2001


DATE: November 27, 2001 JOB NUMBER - 01163A
NOTE: THIS IS NOT A CERTIFIED COPY UNLESS SEALED.

SAVANA
LANE

LOT 8

LOT 7
AREA 6.20 ACRES

LOT 6

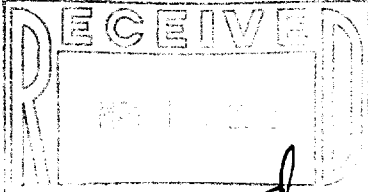

EDPE-7 116-615