


PLAT OF SURVEY

LOT 7

ANGELS FLIGHT SUBDIVISION

A REDIVISION OF LOT 4 OF MOGG'S SUBDIVISION &
LOTS 2 & 3 OF EDWARD UHLEIN'S SUBDIVISION
LOCATED IN PART OF GOVERNMENT LOT 1
SECTION 11, TOWN 1 NORTH, RANGE 16 EAST
WALWORTH COUNTY, WISCONSIN

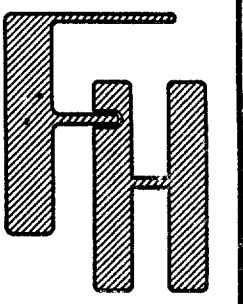


PLAT OF SURVEY

WORK ORDERED BY -
BRIAN JORNDT
JORNUT BUILDERS
1809 SOUTH SHORE DRIVE
DELAWARE, WI 53115

FARRIS, HANSEN & ASSOCIATES, INC.
ENGINEERING - ARCHITECTURE - SURVEYING
7 RIDGWAY COURT P.O. BOX 437
ELKHORN, WISCONSIN 53121
OFFICE: (262) 723-2098 FAX: (262) 723-5886

REVISIONS

PROJECT NO.
4666.07
DATE
10/05/01
SHEET NO.
1 OF 1

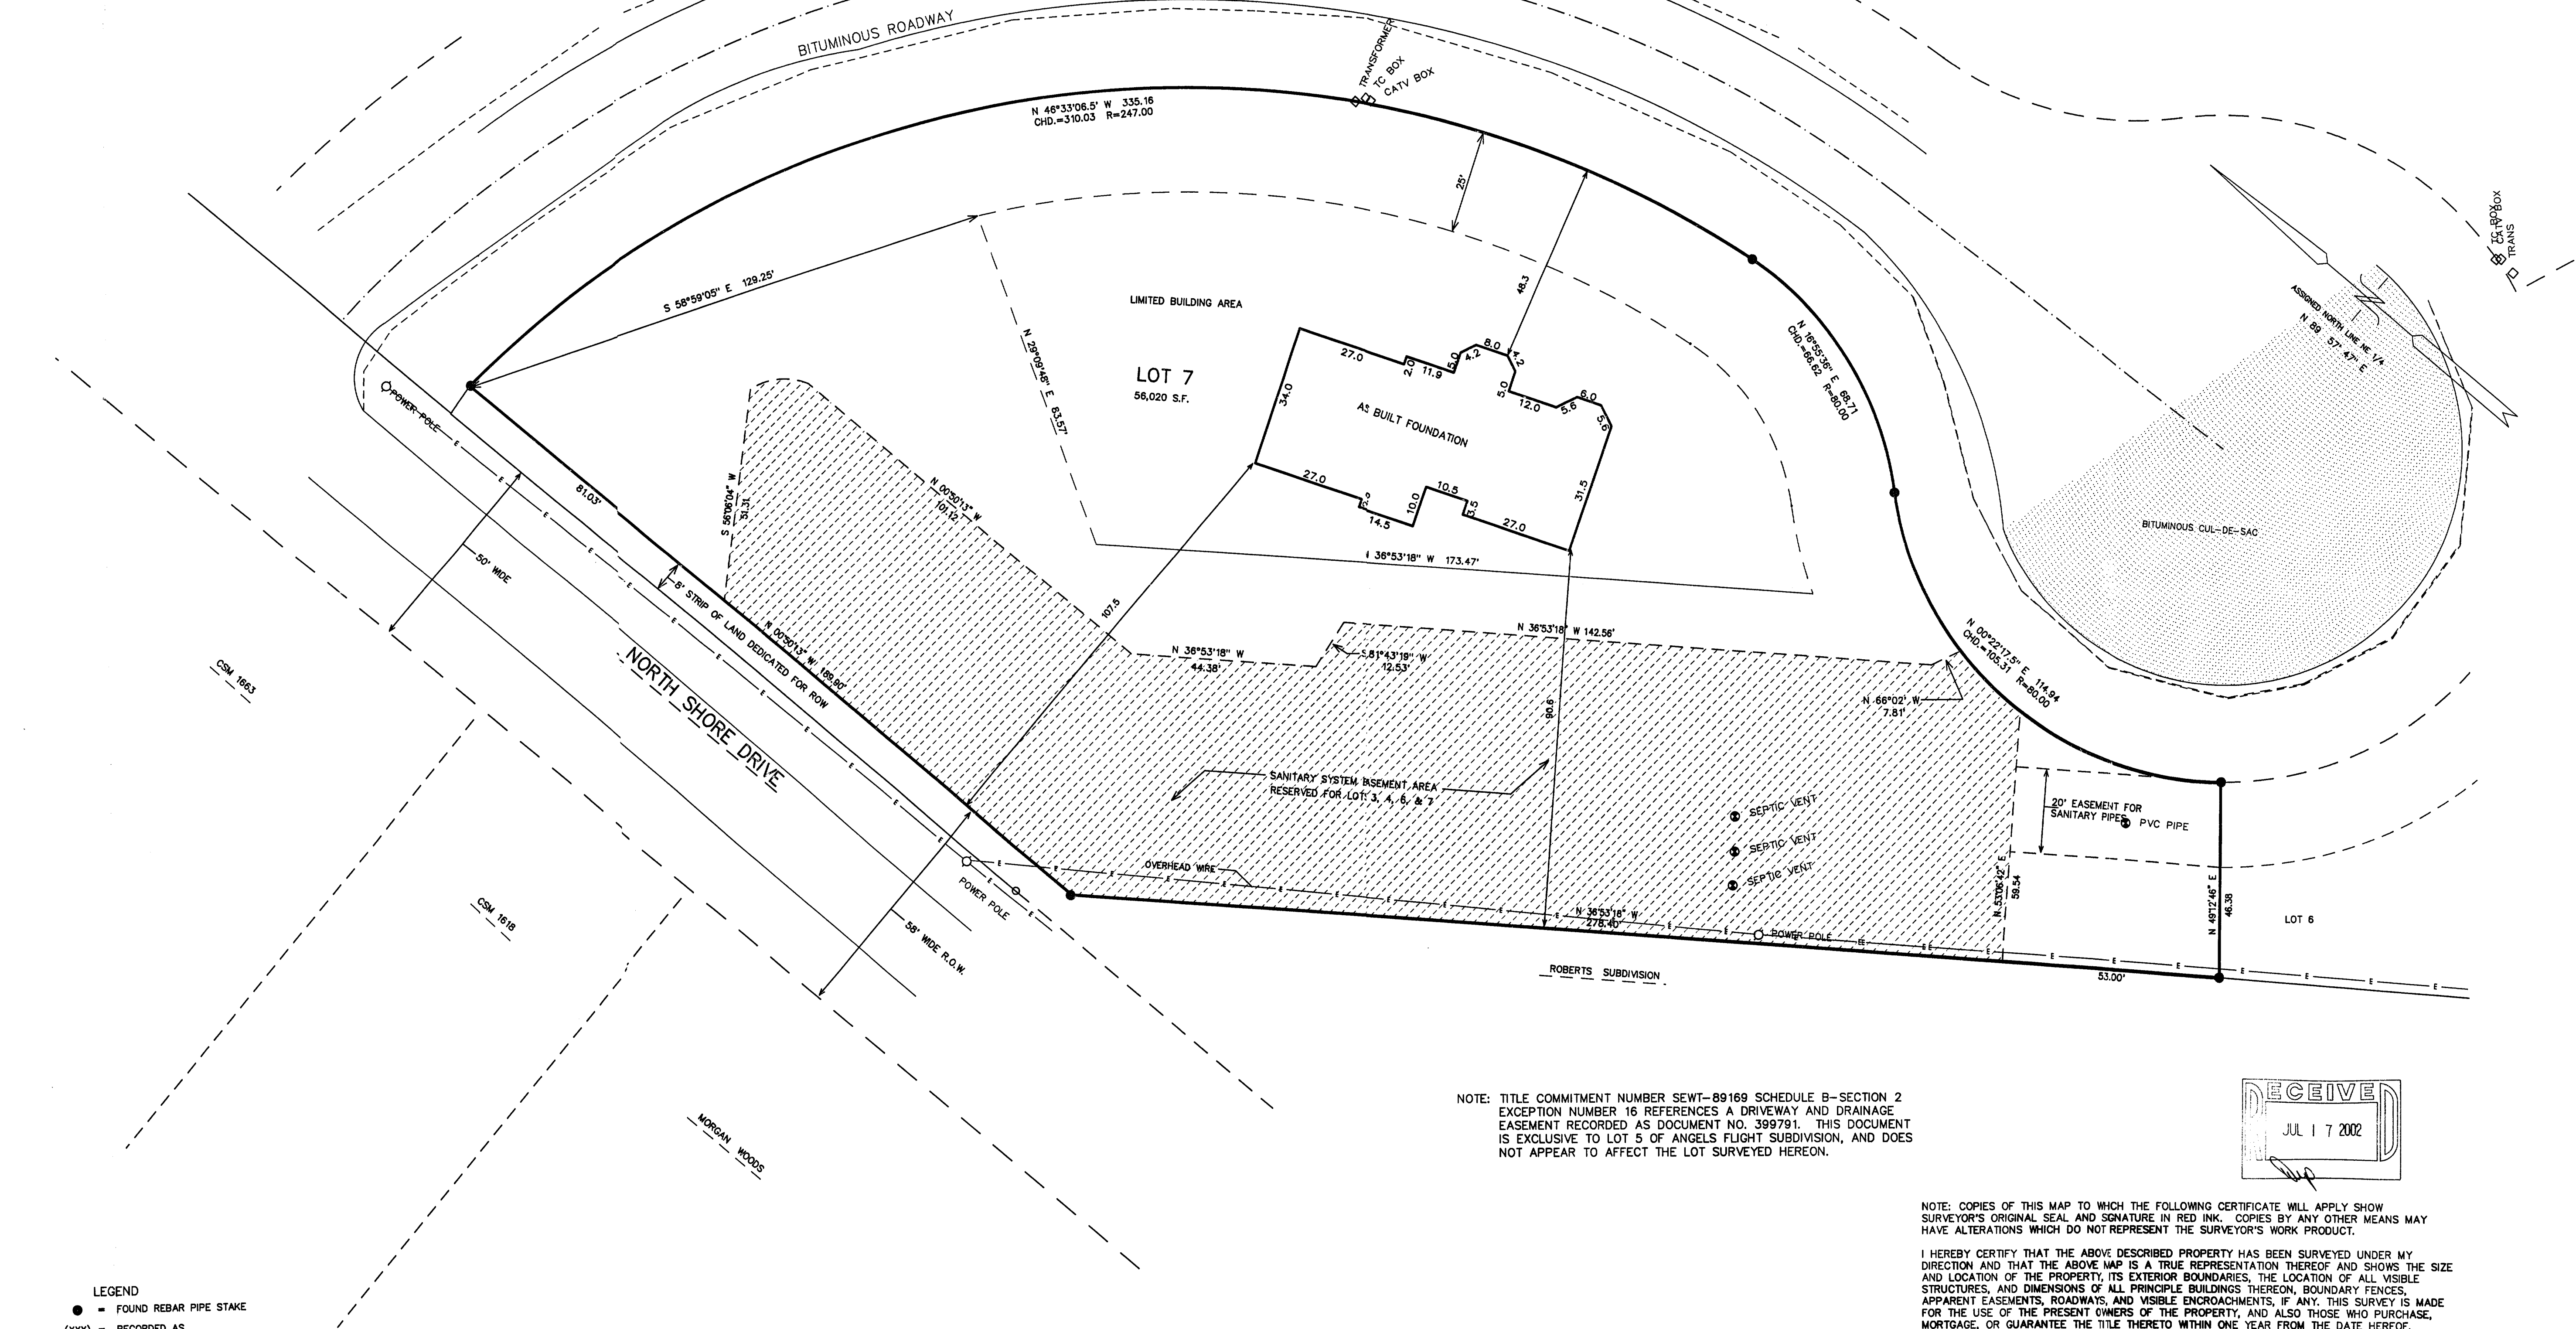

NOTE: TITLE COMMITMENT NUMBER SEWT-89169 SCHEDULE B-SECTION 2
EXCEPTION NUMBER 16 REFERENCES A DRIVEWAY AND DRAINAGE
EASEMENT RECORDED AS DOCUMENT NO. 398791. THIS DOCUMENT
IS EXCLUSIVE TO LOT 5 OF ANGELS FLIGHT SUBDIVISION, AND DOES
NOT APPEAR TO AFFECT THE LOT SURVEYED HEREON.

DATED: OCTOBER 19, 2001

PETER S. GORDON R.L.S. 2101

REVISED 07-01-2002
TO SHOW SIZE & LOCATION OF
FOUNDATION AS BUILT

116-621