


EA3349-1

Plat of Survey


of
Lot 1 of Certified Survey Map No. 3349
recorded in Vol. 19 on Page 95 and located
in the Southeast 1/4 of Section 6, Town 1
North, Range 16 East, Town of Walworth,
Walworth County, Wisconsin.

Surveyed for:
Brian & Nancy Jongetjes
N4685 County Road P
Delavan, Wisconsin. 53115

Savanah Lane
(66' Wide)

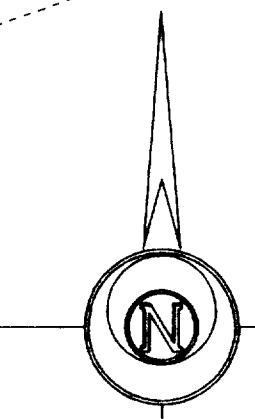

Bearing reference to the Wisconsin State
Plane Coordinate System, South Zone.

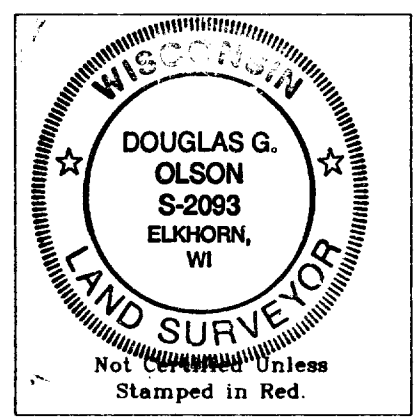

Notes: 1) This survey plat is not
certified unless signed
and sealed in red ink.



2) This survey is subject to Wisconsin lien laws.
This Plat of Survey is the notice of intent
to file lien. Lien waiver required.

Copyright © 2001 by Jensen & Olson Land Surveying, LLC.

All rights reserved. No part of this survey plat may be reproduced
or transmitted in any form by any means - graphic, electronic, or
mechanical, including photocopying, tracing, or information storage
and retrieval systems - without permission in writing from Douglas
G. Olson, Jensen & Olson Land Surveying, LLC.

I, Douglas G. Olson, Wisconsin Registered Land Surveyor,
do hereby certify that this survey was performed by me or under my
direction in full compliance with the owner's/agent's instructions
and Chapter A-E 7 of the Wisconsin Administrative Code "Minimum
Standards for Property Surveys", and that this map is an accurate
representation thereof to the best of my knowledge and belief.


Douglas G. Olson
Wisconsin Registered Land Surveyor - 2093

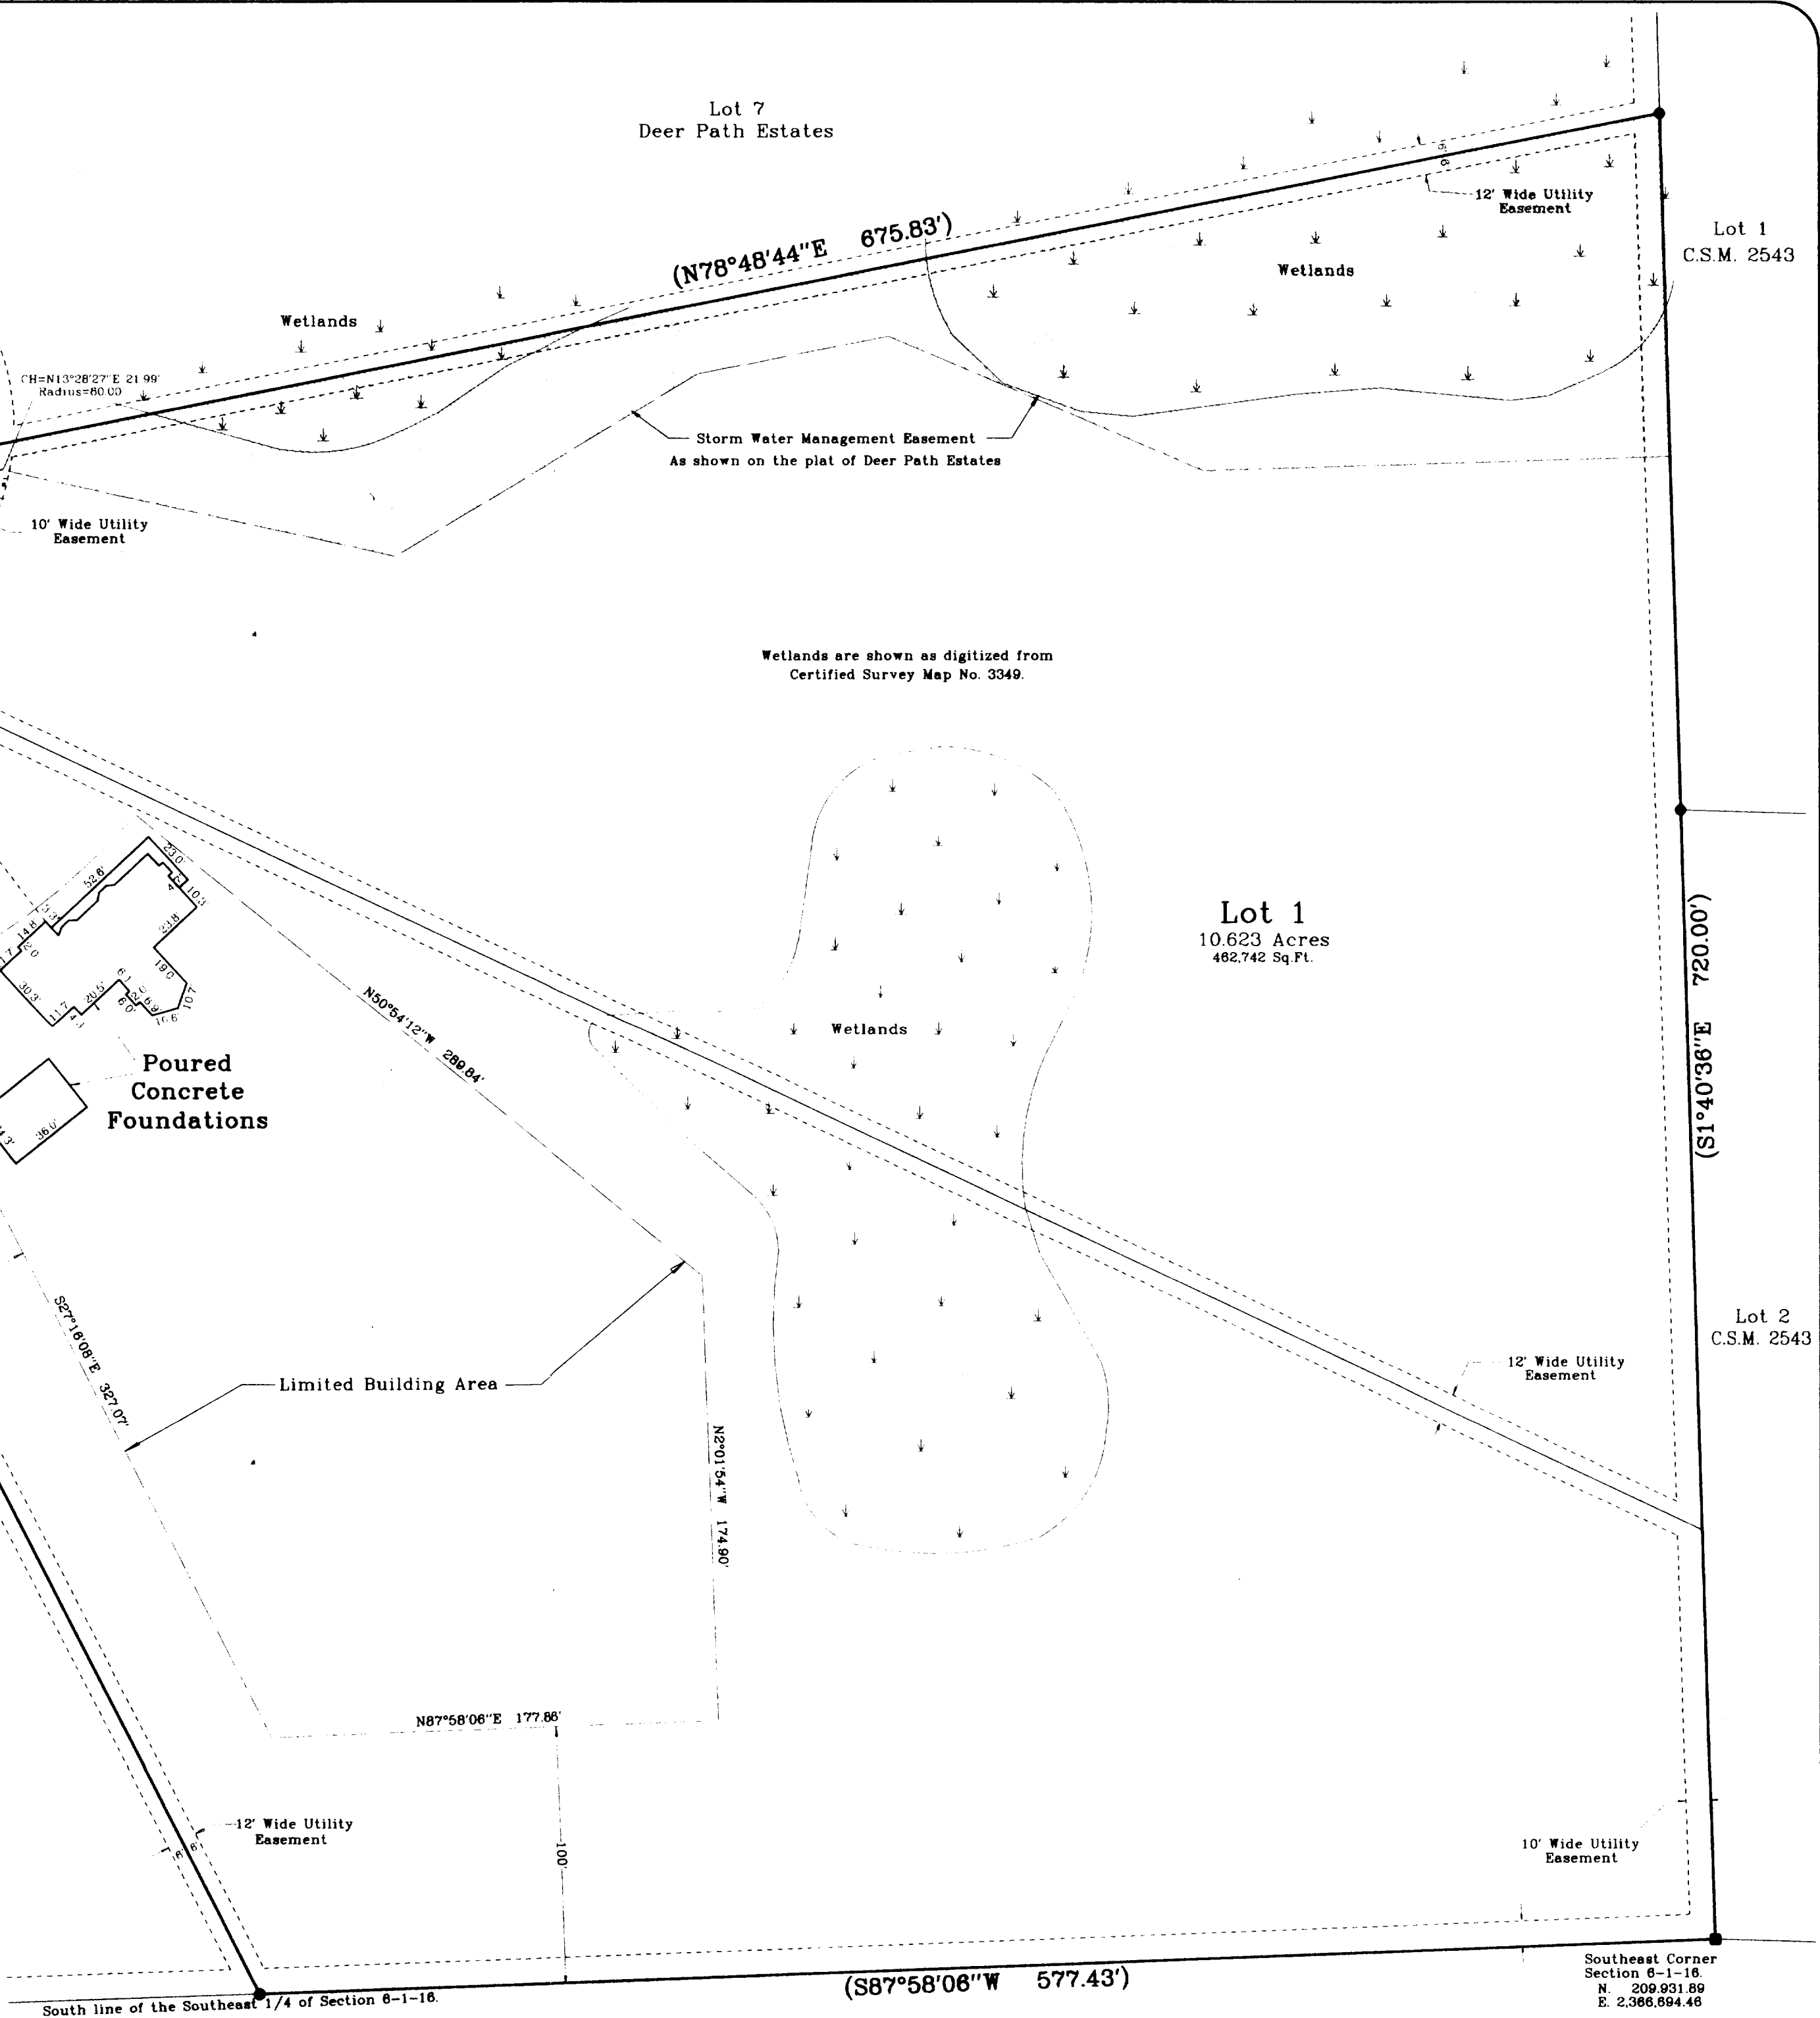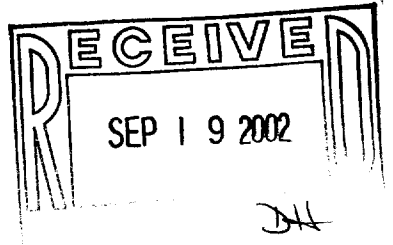

Tax Parcel
EW 700001

Southeast Corner
Section 6-1-16.
N. 209.931.89
E. 2366.694.46

Survey Date: December 5, 2001.
Revisions:

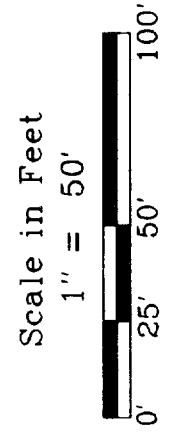

Jensen & Olson Land Surveying, LLC
45 South Wisconsin Street
P.O. Box 322
Elkhorn, Wisconsin. 53121
Telephone (262) 723-3434
Facsimile (262) 723-8044

Legend
Found County Section Corner
Recorded Information
Utility Box
Utility Pedestal
Asphalt Surface
Gravel Surface

Sheet 1 of 1 Sheets
Job Reference Number
2001.122
2001.122

116-640