


DUNHAM SURVEYING, S.C.
SURVEYING & SUBDIVIDING
DELAVER, WISCONSIN 53115

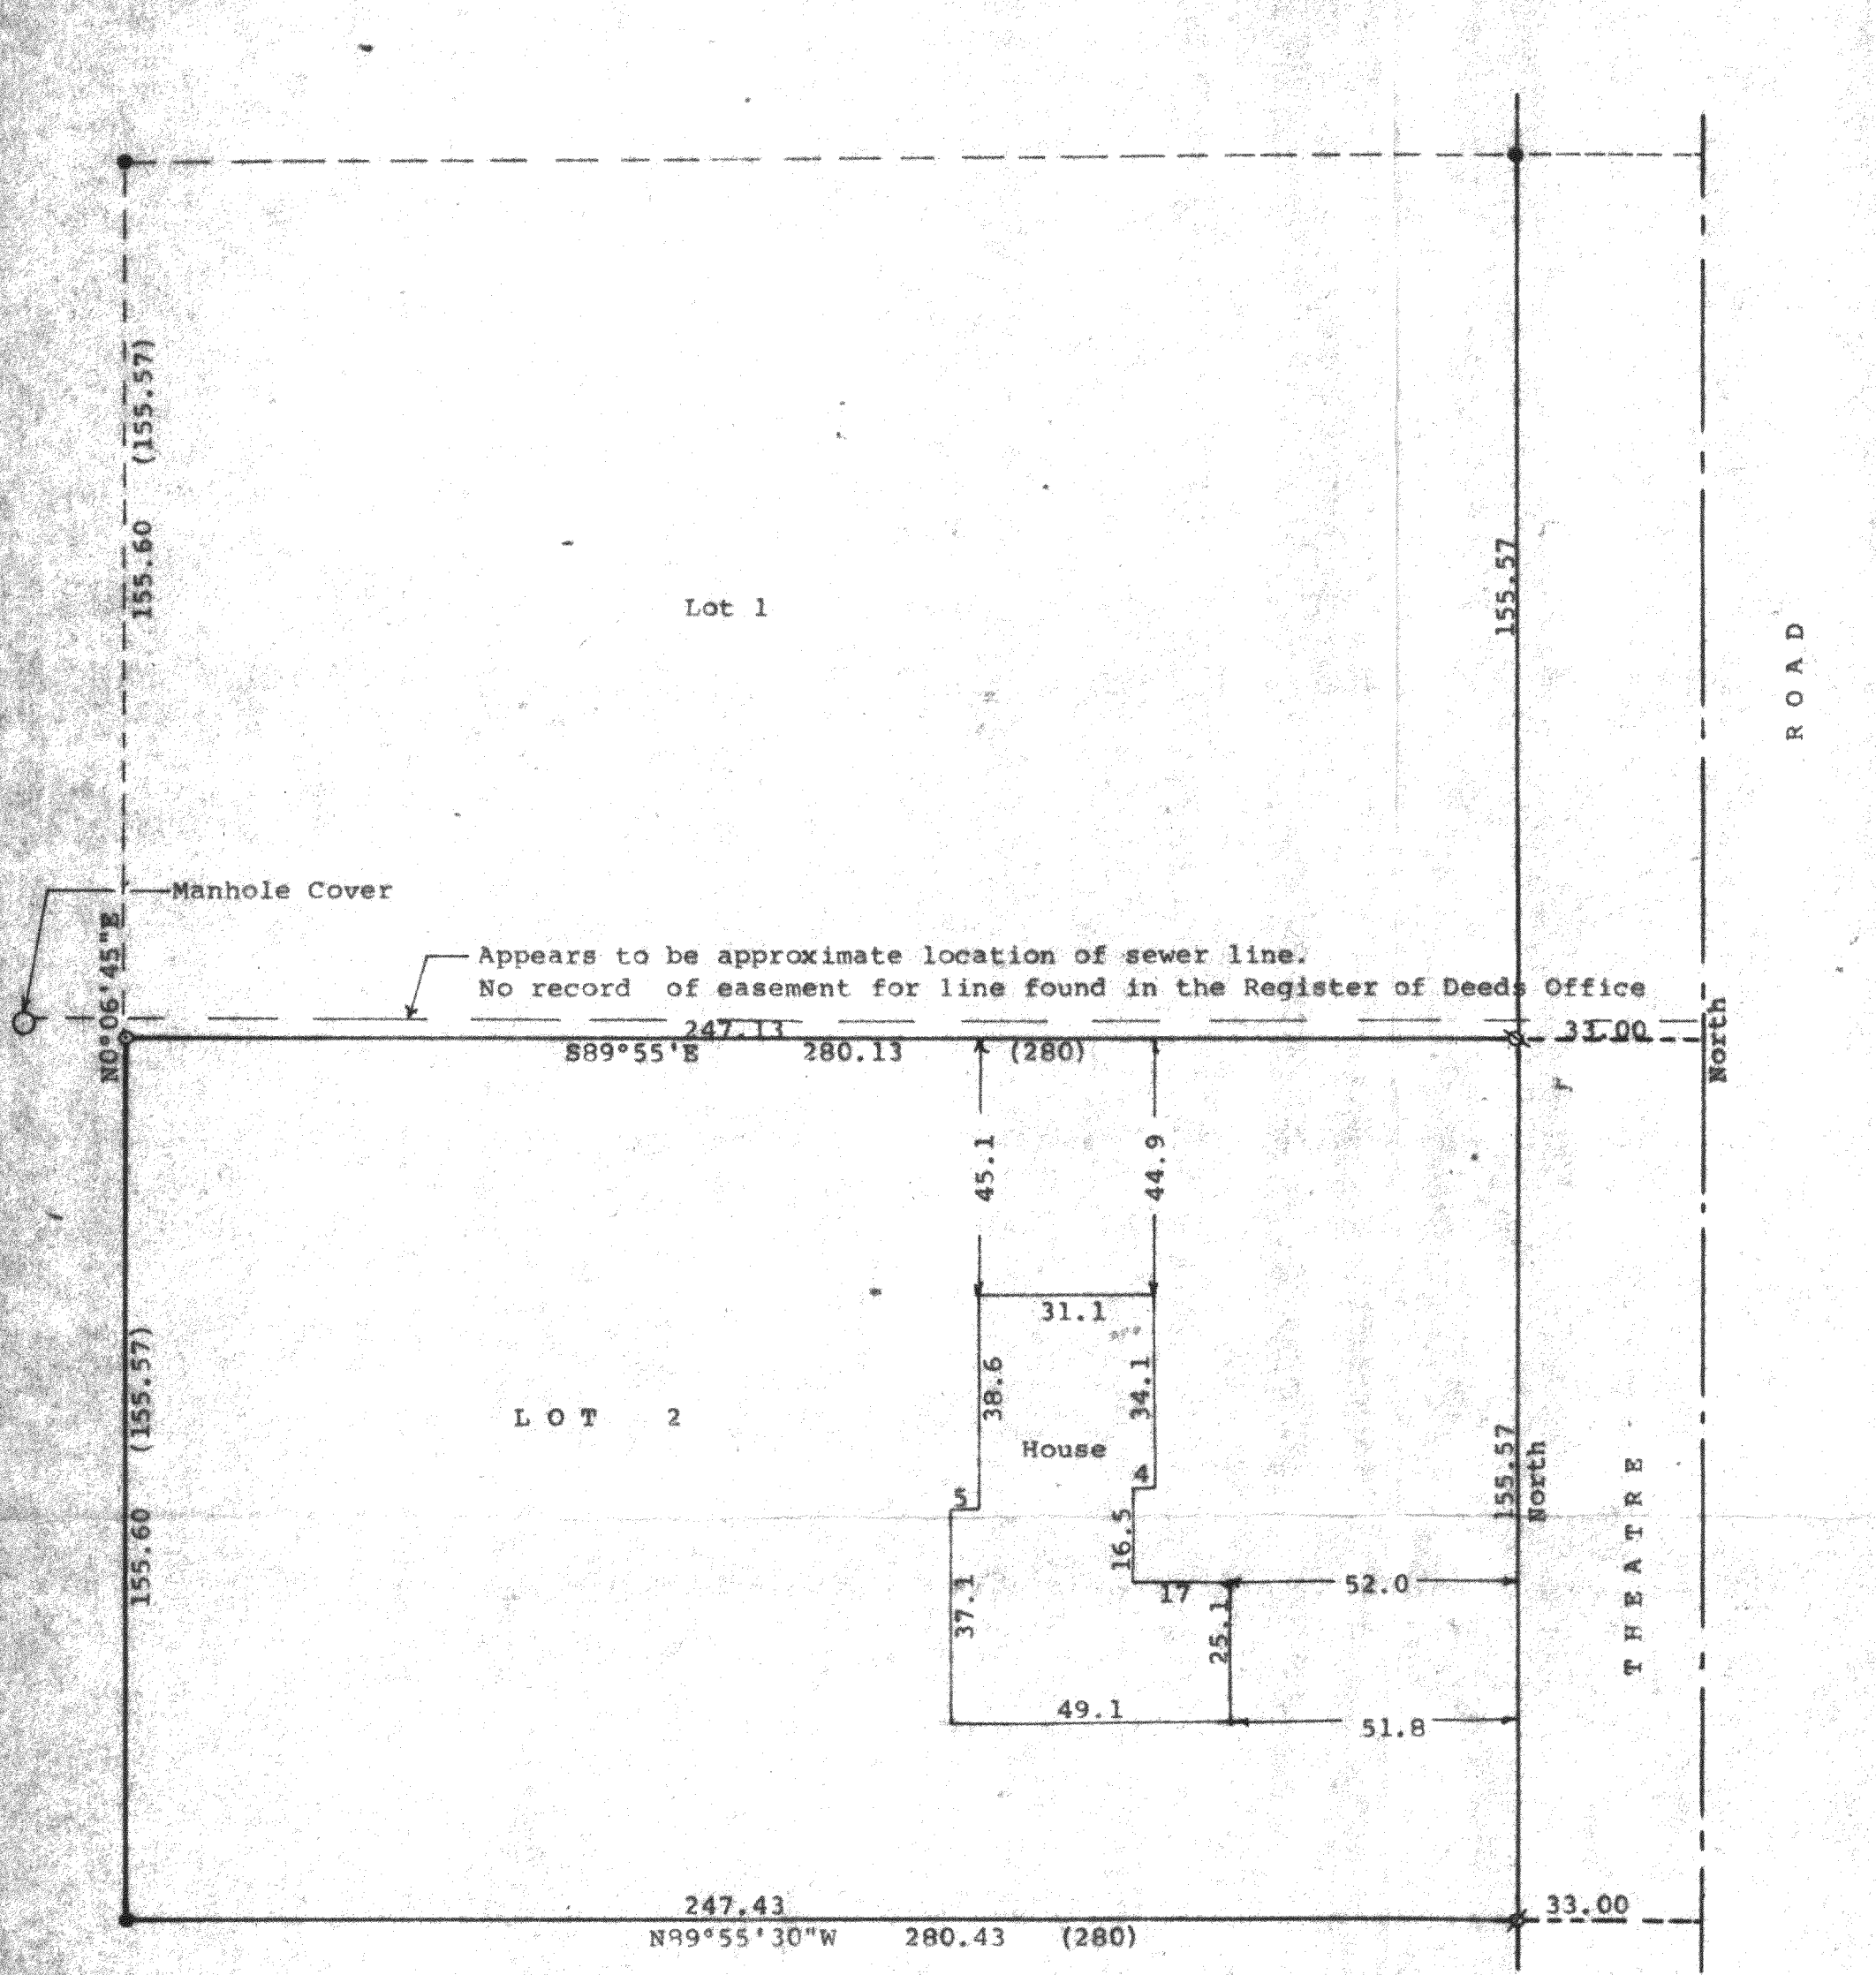

Scale - 1" = 30'
 ● = 3/4" Iron Rod Found
 ⌀ = 3/4" Iron Pipe Found
 ⊕ = 1" Iron Rod Set
 ○ = Iron Pipe Set
 Survey ordered by: Donald Lemke
 W5112 Wandawega Drive
 Elkhorn, WI 53121
 (0.00) = Recorded distance

STATE OF WISCONSIN) ss
 COUNTY OF WALWORTH)
 I, George T. Dunham, Surveyor, certify that I have surveyed the property described as follows:
 Lot 2 of Certified Survey No. 2014, recorded February 20, 1991, in Volume 9 of Certified Surveys, Pages 309 & 310, Document No. 207196, in the Office of Register of Deeds, Elkhorn, WI., being a parcel of land located in the SE¼ of the NE¼ of Section 2, T 1 N., R 16 E., Walworth County, Wisconsin,
 and that the plat shown hereon is a correct representation thereof and shows the size and location of the property, its exterior boundaries, the location of all visible structures and dimensions of all principal buildings thereon, boundary fences, apparent easement, roadways and visible encroachments, if any, and that I have surveyed the property hereon described, according to the official records, to the best of my knowledge and belief.
 May 6, 1997

George T. Dunham
 George T. Dunham, Surveyor

