


DUNHAM SURVEYING, S.C.
SURVEYING & SUBDIVIDING
DELAVER, WISCONSIN 53115

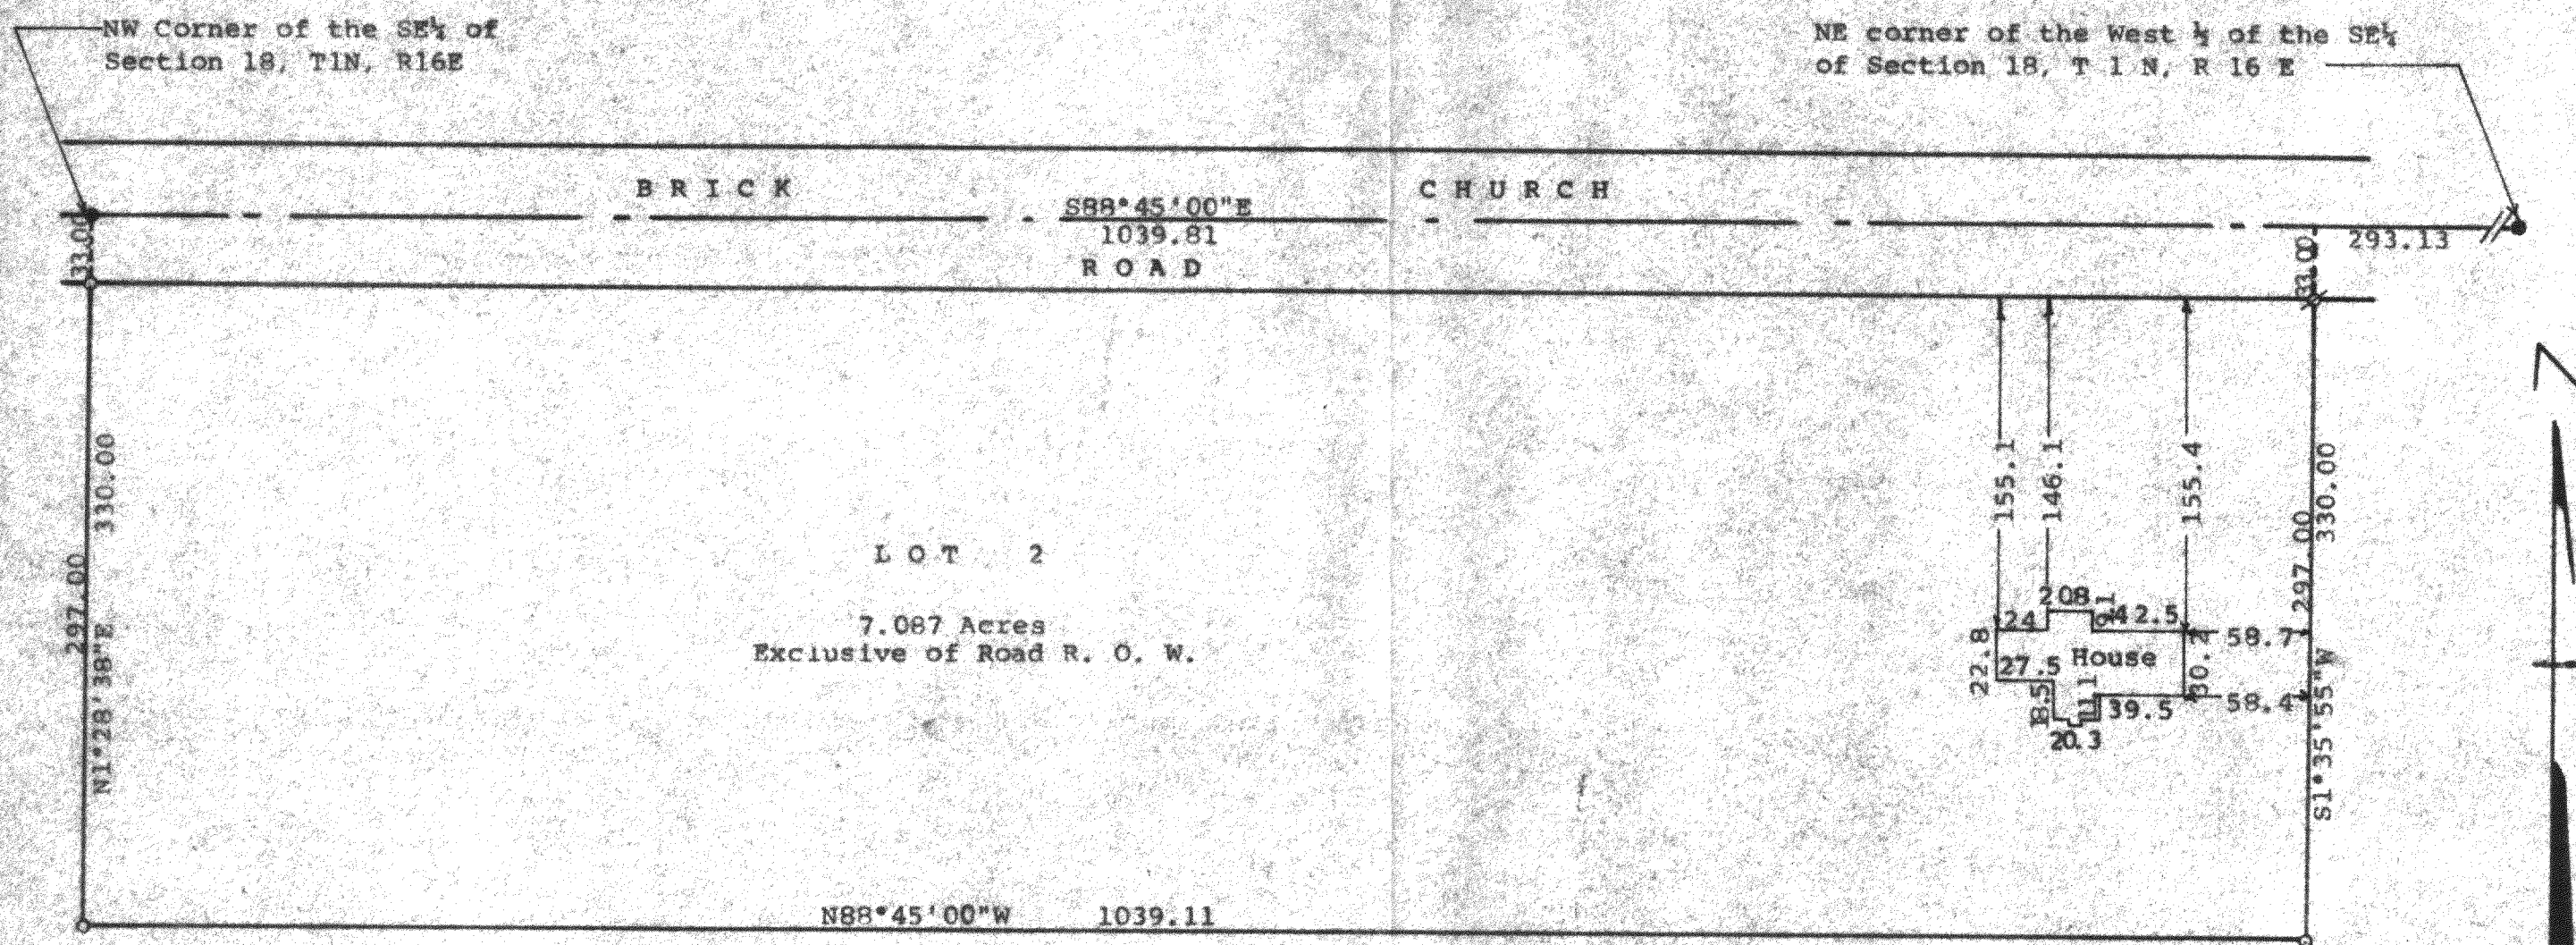

Scale - 1" = 80'
O = 1" Iron Pipe Found
● = Concrete Monument Found
X = Crooked Iron Pipe Found. Pulled and reset at correct corner.

Bearings are those shown on the recorded plat of CSM NO. 2393

Survey ordered by:
Andy Pearce
W5074 Hwy "B"
Fontana, WI 53125

STATE OF WISCONSIN)
COUNTY OF WALWORTH)

I, George T. Dunham, Surveyor, certify that I have surveyed the property described as follows:

Lot 2 of Certified Survey No. 2393, recorded in the Office of the Register of Deeds, December 16, 1993, Document No. 274174, in Volume 12, Pages 7 & 8 of Certified Surveys, Elkhorn, Wisconsin, being a parcel of land located in the West 1/4 of the Southeast 1/4 of Section 18, T 1 N, R 16 E, Walworth County, Wisconsin and that the plat shown hereon is a correct representation thereof and shows the size and location of the property, its exterior boundaries, the location of all visible structures and dimensions of all principal buildings thereon, boundary fences, apparent easements, roadways and visible encroachments, if any, and that I have surveyed the property hereon described, according to the official records, to the best of my knowledge and belief.

October 17, 1996

George T. Dunham
George T. Dunham, Surveyor

