


GEORGE T. DUNHAM
SURVEYING & SUBDIVIDING
DELAVER, WISCONSIN

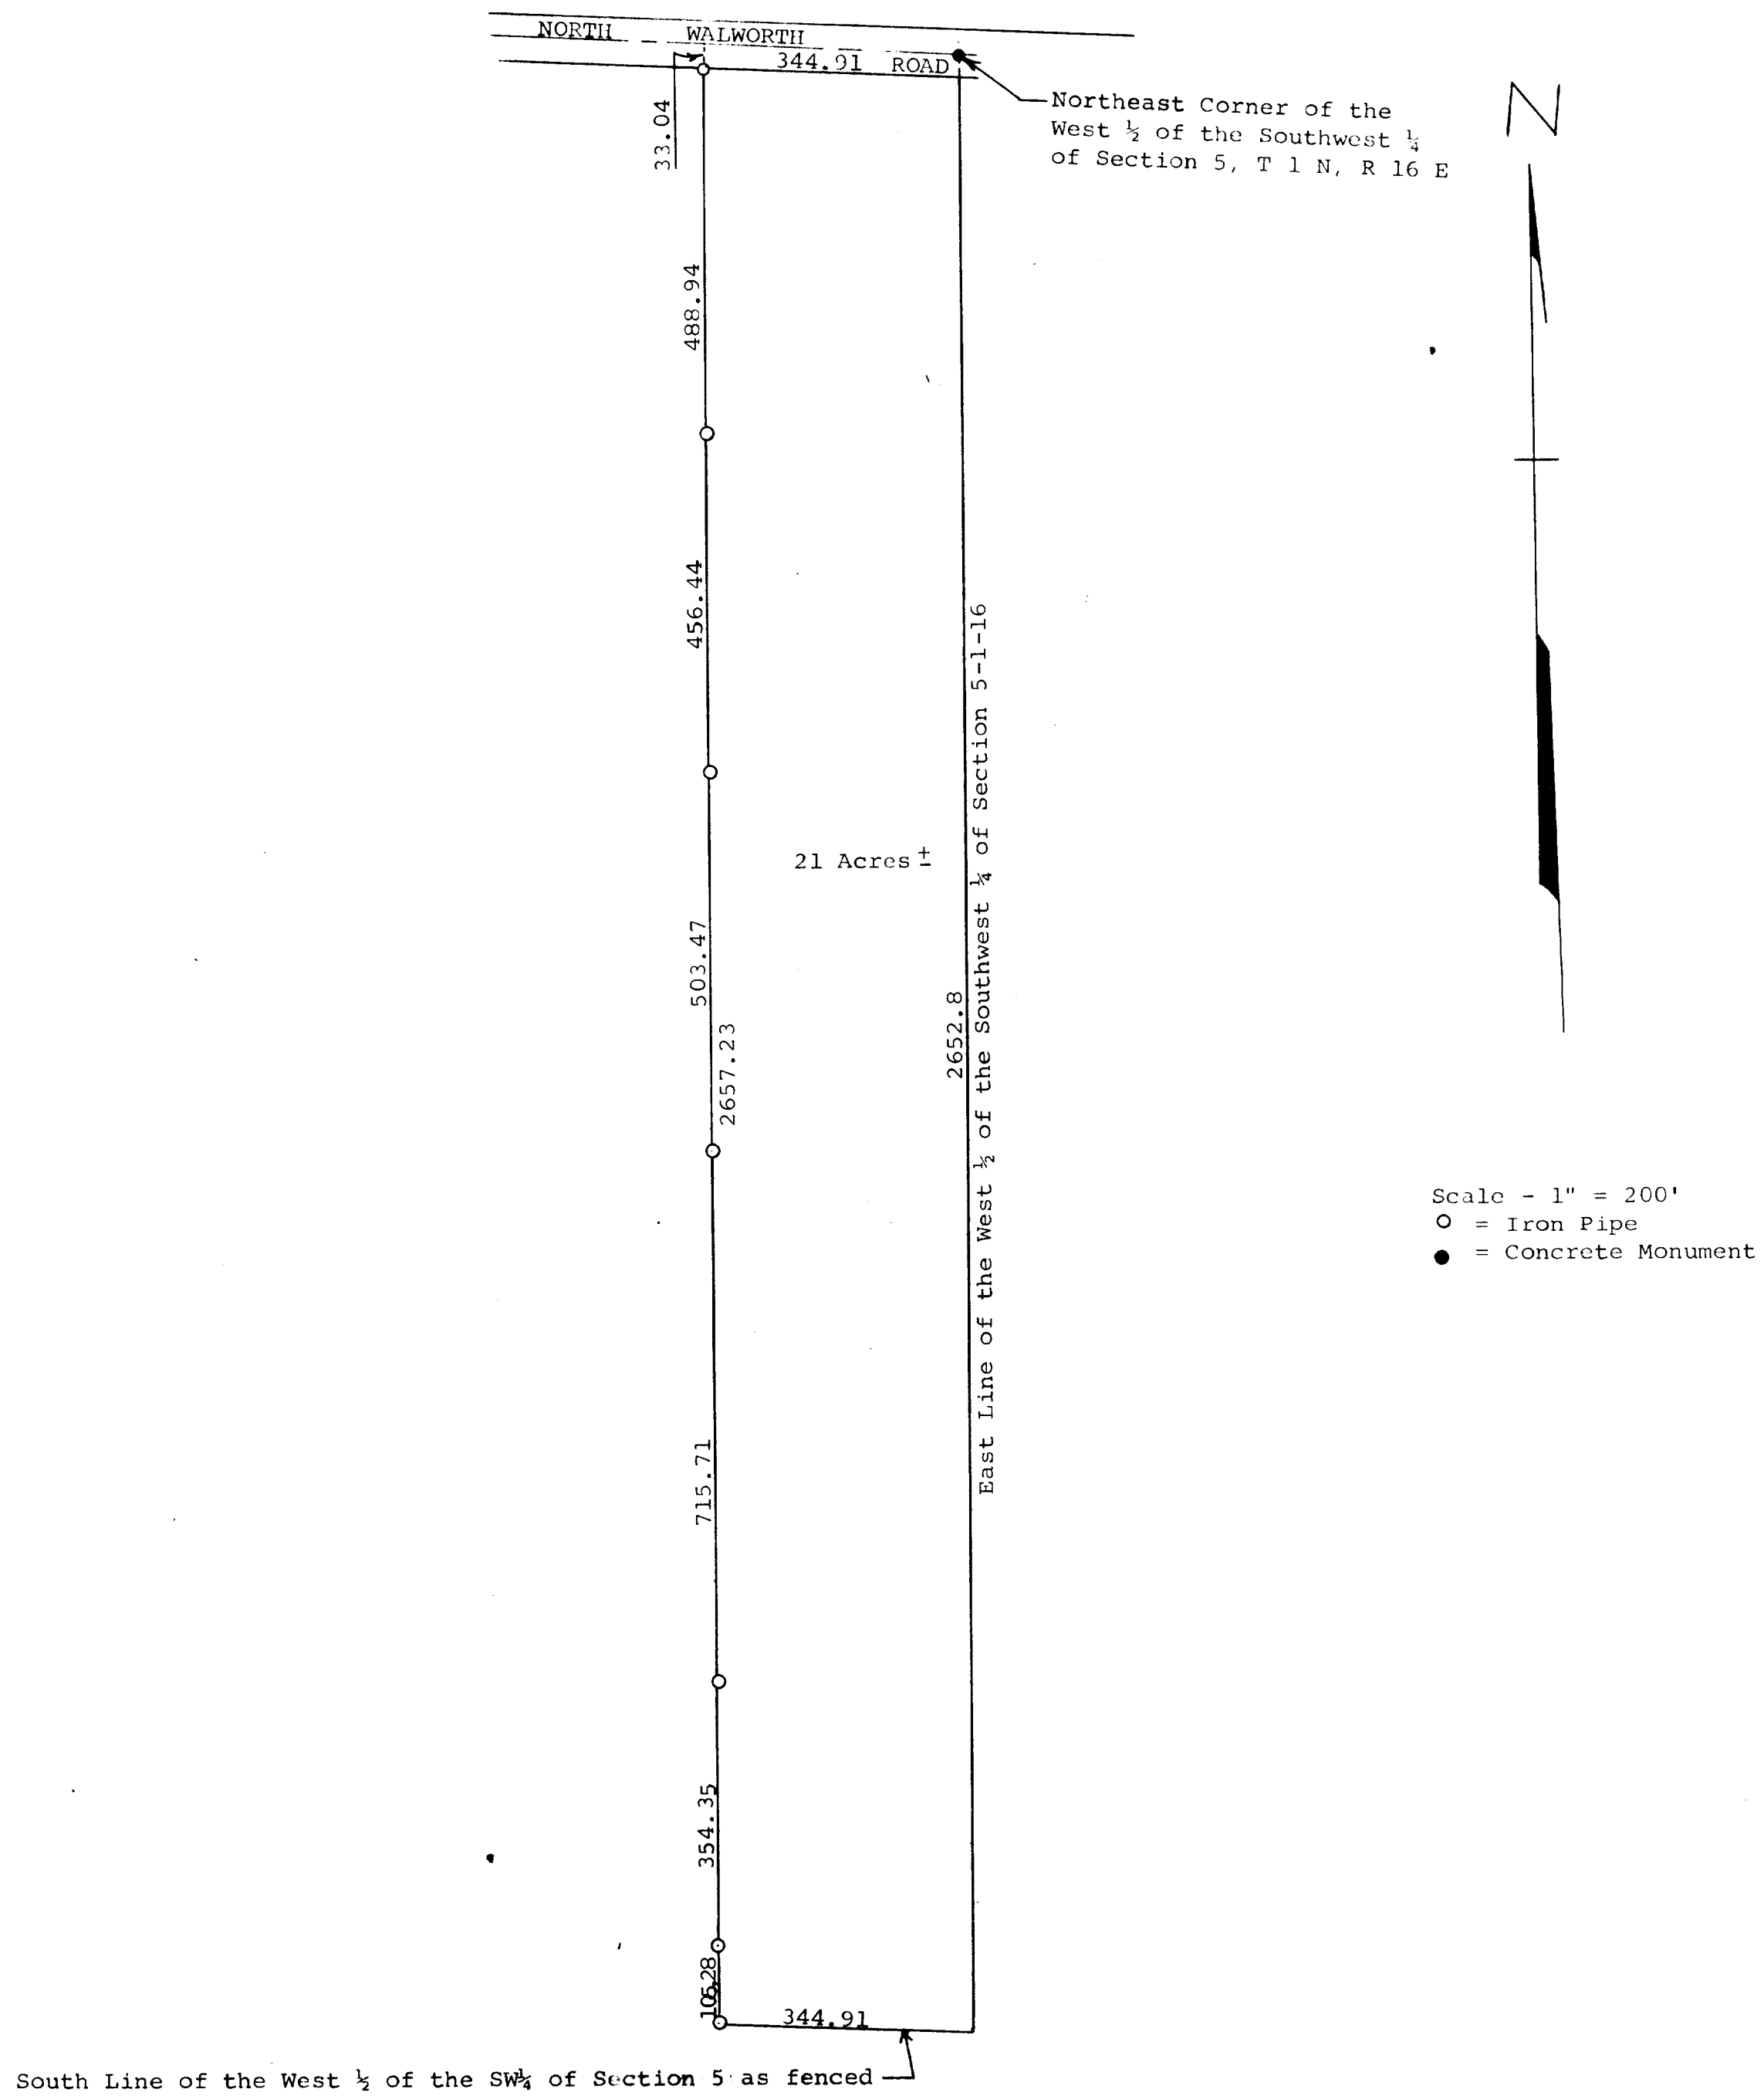

Plat of survey of a parcel of land located in the West $\frac{1}{2}$ of the Southwest $\frac{1}{4}$ of Section 5, T 1 N, R 16 E, Walworth County, Wisconsin.
June 23, 1970

George T. Dunham
George T. Dunham, Surveyor

W-5-8 B, 802
+
W-5-8 B1 -
+ cel 288

116-68

116-68