


DUNHAM SURVEYING, S.C.
SURVEYING & SUBDIVIDING
DELAVAN, WISCONSIN 53115

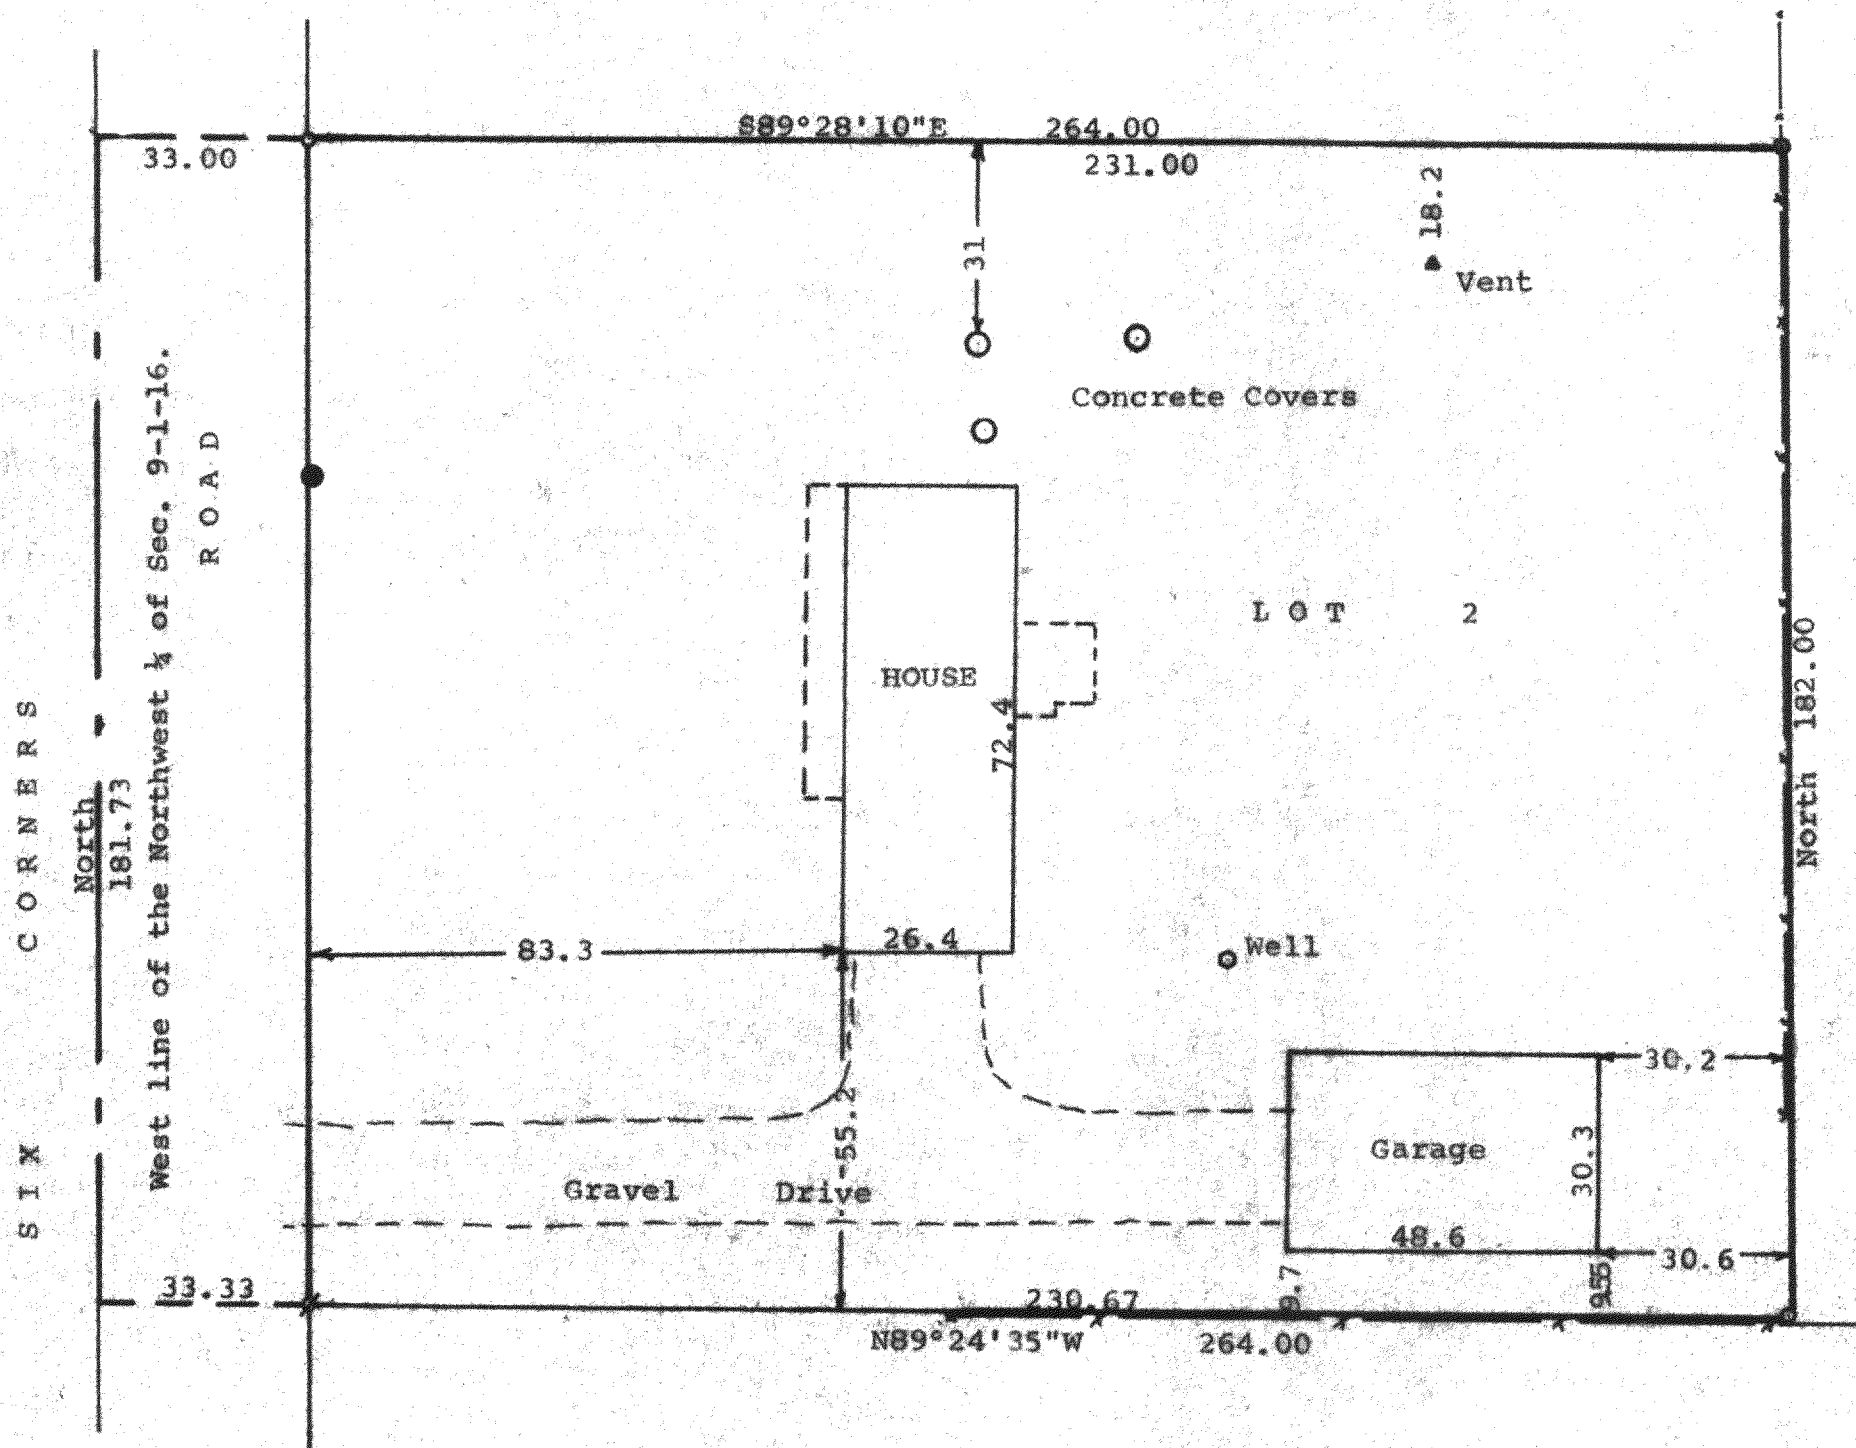

Scale - 1" = 30'
 Ø = Iron Pipe Found - 1"
 — = Fence Line
 ● = Utility Pole
 ○ = 1 1/2" Iron Pipe Found

NOTE: Bearings used are those of record.

Ordered by: Don Nichols, Realtor
 308 Kenosha St.
 Walworth, Wisconsin

STATE OF WISCONSIN)
 COUNTY OF WALWORTH) SS

I, George T. Dunham, Surveyor, certify that I have surveyed the property described as follows,
 Lot 2 of Certified Survey Map No. 732, recorded in Volume 3 on page 245 of certified surveys in and for Walworth County, Wisconsin, said lot located in the Southwest 1/4 of the Northwest 1/4 of Section 9, T1N, R16E, Walworth County, Wisconsin. and that the above map is a true representation thereof and shows the size and location of the property, its exterior boundaries, the location of all visible structures and dimensions of all principal buildings thereon, boundary fences, apparent easements, roadways and visible encroachments, if any, and that I have surveyed the property hereon described according to the official records, to the best of my knowledge and belief.

May 11, 1982
 Revised July 25, 1983

George T. Dunham
 George T. Dunham, Surveyor

