

— WORK ORDERED BY —
RICHARD RASMUSSEN
C/O ESTATE OF JANE SELLGREN
P.O. BOX 250
WALWORTH, WI 53164



FARRIS, HANSEN & ASSOCIATES, INC.
ENGINEERING — ARCHITECTURE — SURVEYING
7 RIDGWAY COURT P.O. BOX 437
ELKHORN, WISCONSIN 53121

REVISIONS

PROJECT NO.
7154

DATE
10/11/2006

SHEET NO.
1 OF 1

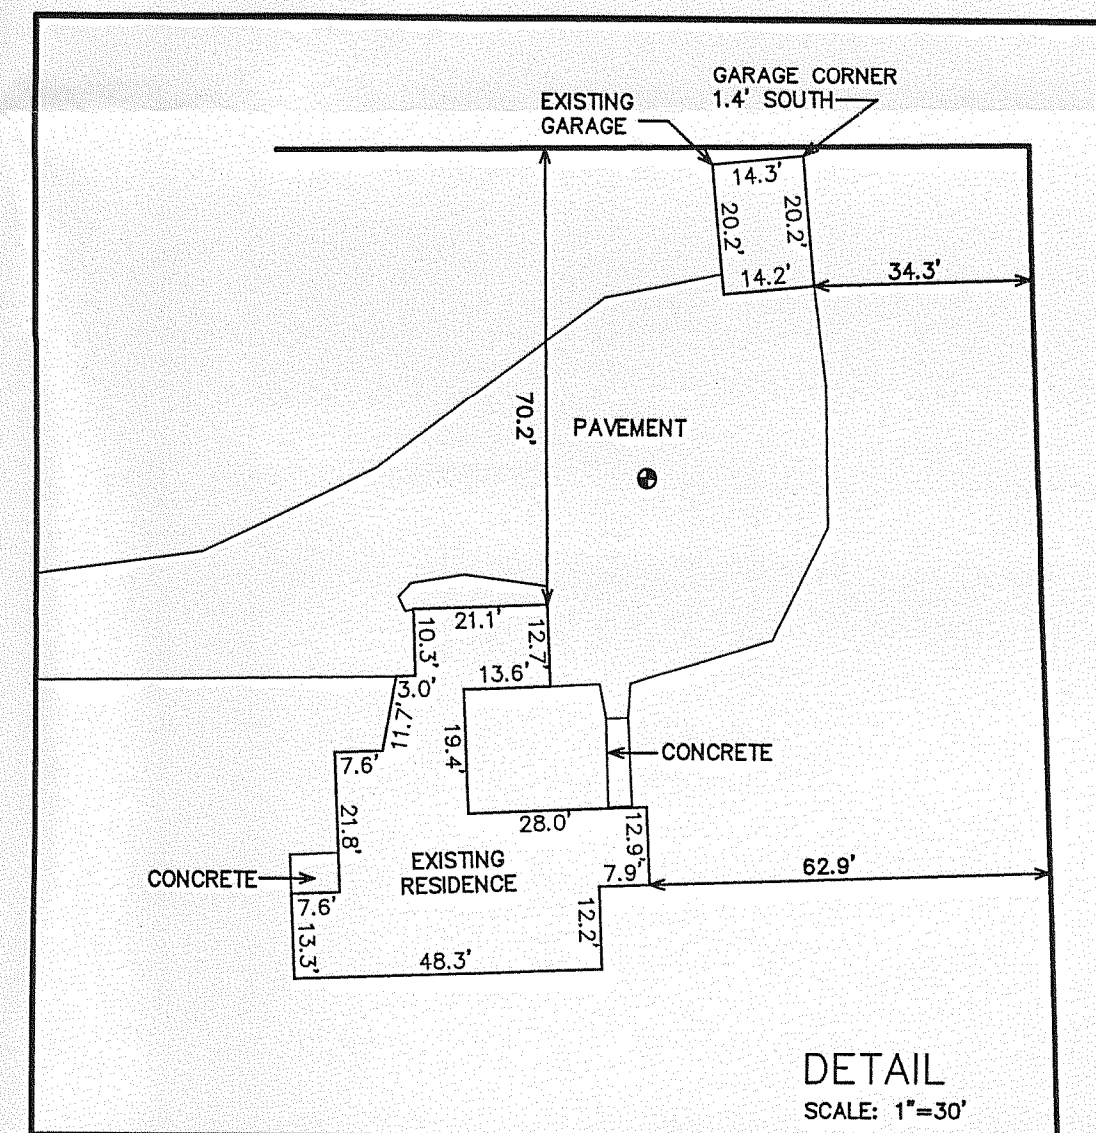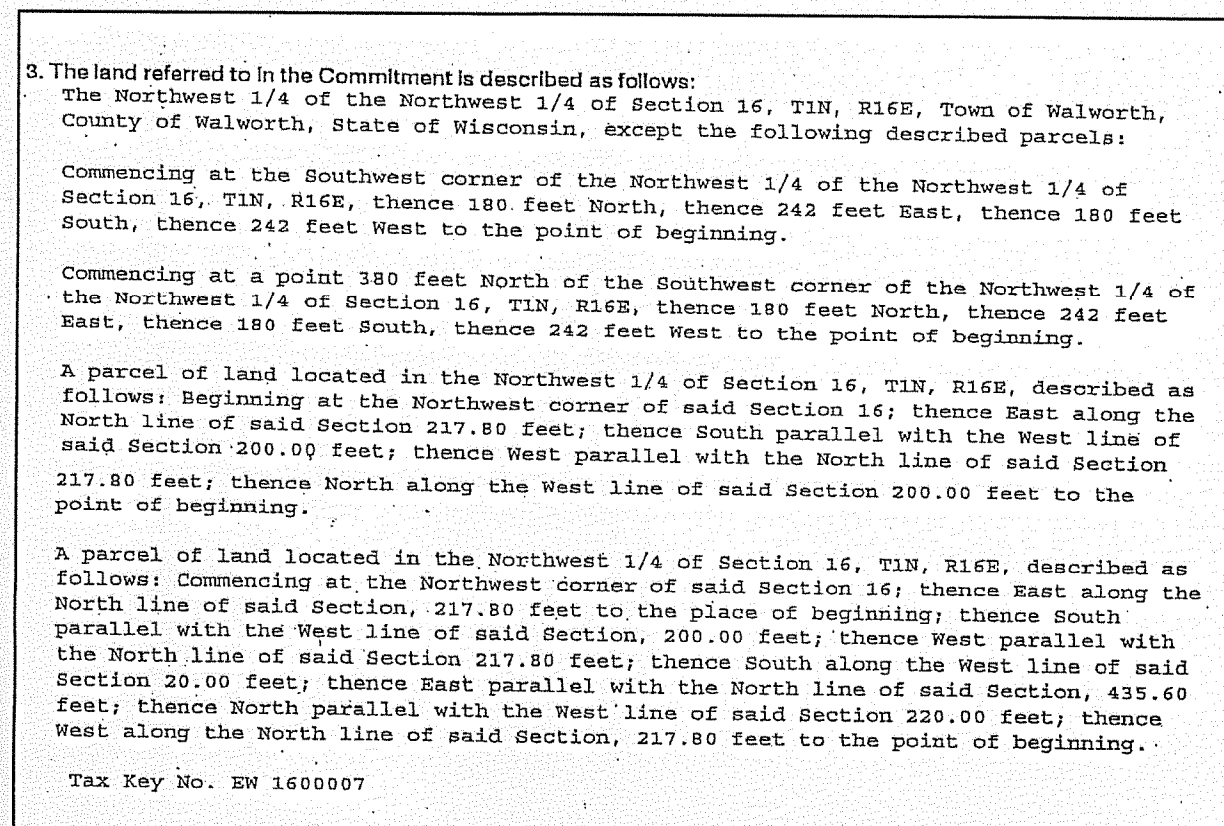

NOTE:
TAX LISTER'S DESCRIPTION FOR PARCEL EW 1600007B
CONTAINS AN ERROR IN THE DISTANCE FROM COMMENCEMENT
TO POINT OF BEGINNING. SHOWN AS 330' SHOULD BE 380'
(SEE DEED VOL. 410, PG 63).

NOTE: COPIES OF THIS MAP TO WHICH THE FOLLOWING CERTIFICATE WILL APPLY SHOW THE SURVEYOR'S ORIGINAL SEAL AND SIGNATURE IN RED INK. COPIES BY ANY OTHER MEANS MAY HAVE ALTERATIONS WHICH DO NOT REPRESENT THE SURVEYOR'S WORK PRODUCT.

I HEREBY CERTIFY THAT THE ABOVE DESCRIBED PROPERTY HAS BEEN SURVEYED UNDER MY DIRECTION AND THAT THE ABOVE MAP IS A TRUE REPRESENTATION THEREOF AND THAT THE SIZE AND LOCATION OF THE PROPERTIES, THE DISTANCES, THE LINES, THE LOCATION OF ALL VISIBLE STRUCTURES, AND DIMENSIONS OF ALL PRINCIPLE BUILDINGS THEREON, BOUNDARY FENCES, APPARENT EASEMENTS, ROADWAYS, AND VISIBLE ENCROACHMENTS, IF ANY, THIS SURVEY IS MADE FOR THE USE OF THE SURVEYOR, HIS SUCCESSORS, AND THE OWNERS OF THE PROPERTY, AND I GUARANTEE THE TITLE THEREO WITHIN ONE YEAR FROM THE DATE HEREOF.

DATED: NOVEMBER 1, 2006


PETER S. GORDON

WISCONSIN
 PETER S. GORDON
 S-2101
 ELKHORN,
 WI
 LAND SURVEYOR

LEGEND


○ = FOUND IRON PIPE STAKE

● = FOUND IRON REBAR STAKE

⦿ = SET IRON REBAR STAKE

(XXX) = RECORDED AS

RECEIVED
NOV 14 2006
SMF

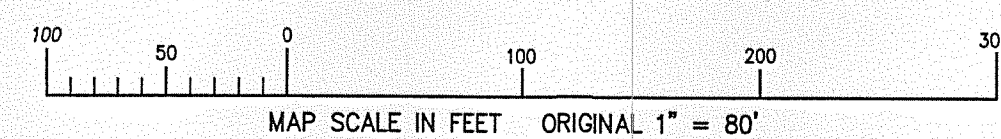

EW 16-7 EW 16-7B

110-785