

PREPARED FOR:
VANESSA TIPPS
W6798 BRICK CHURCH RD.
WALWORTH WI 53184

FENCE CORNER IS
0.37' WEST & 0.52'
SOUTH OF CORNER

KROTT SURVEYING INC.

N3705 WILLOW BEND LANE
LAKE GENEVA WI. 53147
PHONE # (262)248-3697
FAX # (262)249-0639

LOT 3


LOT 2

PLAT OF SURVEY

OF
LOT 2 CERTIFIED SURVEY MAP NO. 1350
LOCATED IN THE SOUTH 1/2 OF THE
NORTHWEST 1/4 OF SECTION 17, TOWN
1 NORTH, RANGE 16 EAST.


LOT 1

FENCE IS 0.40' WEST
OF LOT LINE

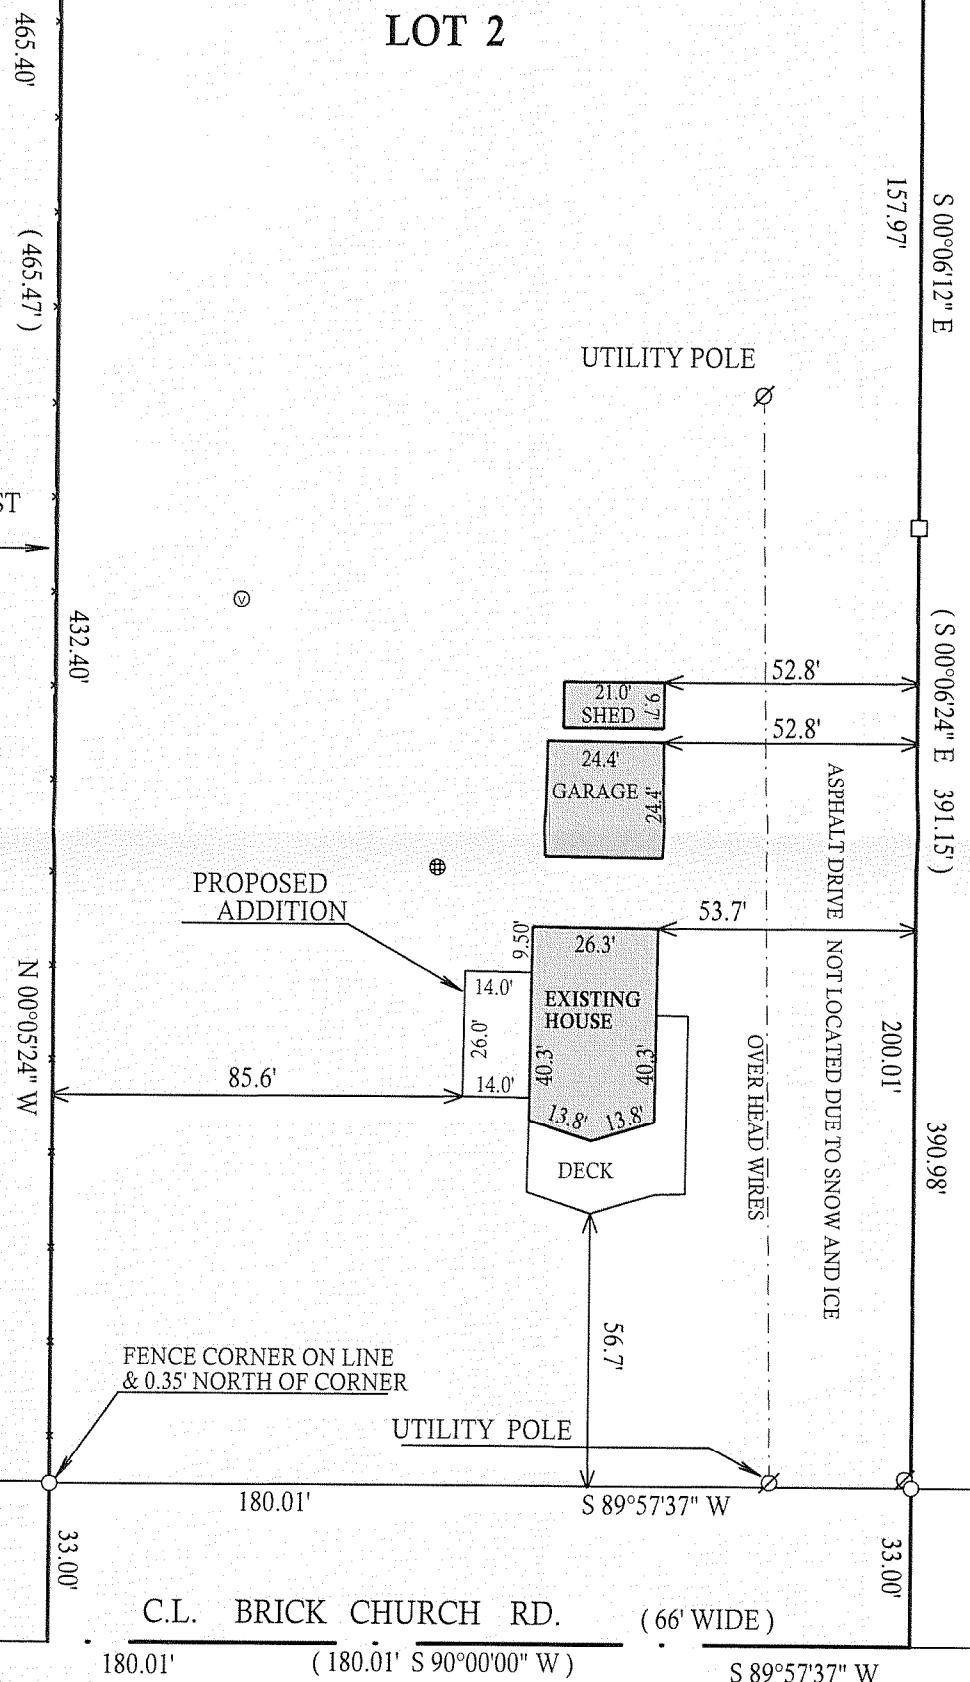

LEGEND

- FOUND IRON PIPE
- FOUND IRON BAR
- ◎ UTILITY PEDIESTALS
- WELL
- ◎ FOUND 2" DIA. IRON PIPE
- ⊕ SEPTIC TANK
- ◎ VENT
- (XX) RECORDED AS

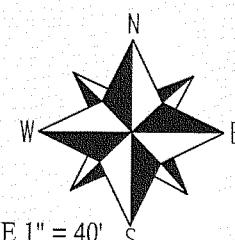

COMPARE LEGAL DESCRIPTION ABOVE AND DRAWING WITH DEED.
FOR BUILDING RESTRICTIONS AND EASEMENTS NOT SHOWN REFER
TO DEED, ABSTRACT SOURCES AND LOCAL MUNICIPAL CODES. NOTIFY
THE SURVEYOR IMMEDIATELY OF ANY DISCREPANCY.


"I hereby certify that I have surveyed the above described property and that
the above map is a true representation thereof and shows the size and
location of all visible structures, apparent easements and encroachments
if any."

This survey is made for the present owners of the property, and those who
purchase, mortgage, or guarantee the title thereto, within one year from
the date hereof.

JOB # 08-019 TAX ID # EA135000002



DATED THIS 18th, DAY OF FEBRUARY, 2008

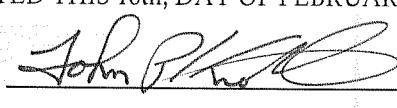
JOHN KROTT S-2258
Wisconsin Registered Land Surveyor
(original if signed in red)