



PLAT OF SURVEY

-OF-

LOT 1 CERTIFIED SURVEY MAP NO. 4260, LOCATED IN THE
SOUTHEAST 1/4 OF THE SOUTHEAST 1/4 OF SECTION 35,
TOWN 1 NORTH, RANGE 16 EAST, WALWORTH COUNTY, WISCONSIN.

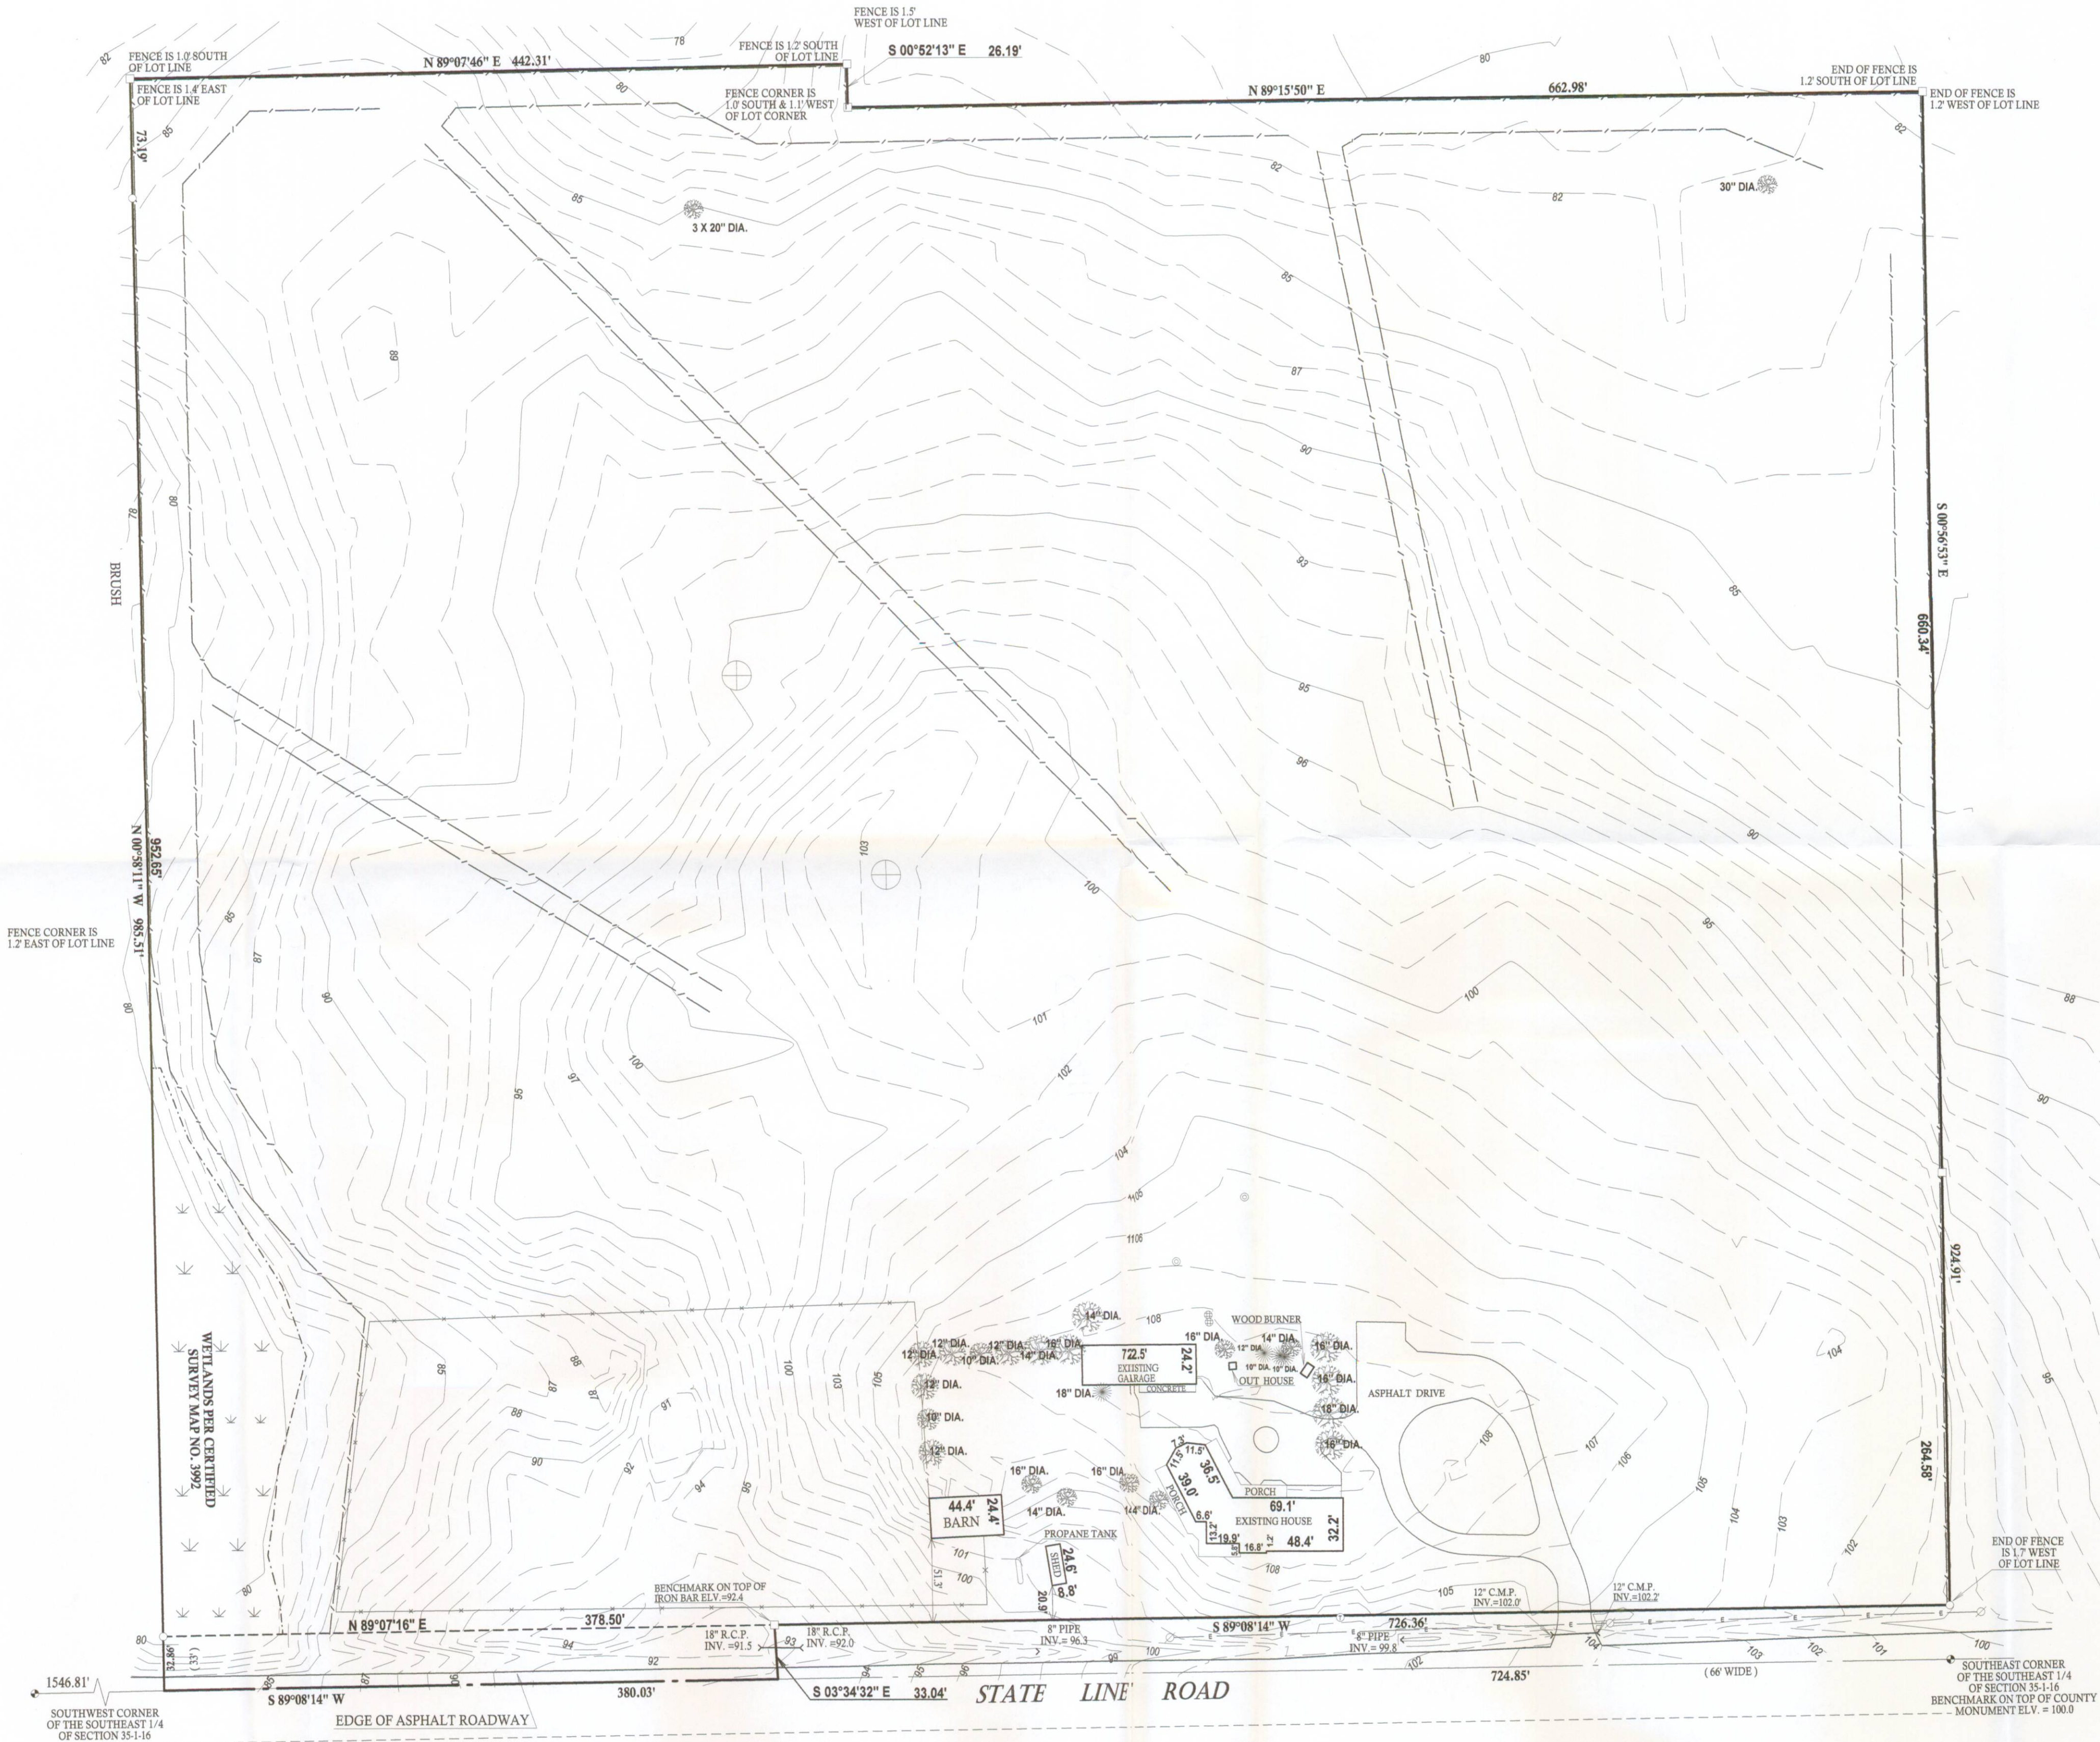


- LEGEND
- FOUND 1" DIA. IRON PIPE
 - FOUND 3/4" DIA. IRON BAR
 - ⊗ FOUND 6"X9" CONCRETE MONUMENT WITH BRASS CAP
 - ⊕ CONCRETE SEPTIC LID
 - ⊙ WIND TURBINE
 - ⊗ DECIDUOUS TREE
 - ⊙ CONIFER TREE
 - ⊙ 4" PVC PIPE
 - FENCE
 - WIRE FENCE
 - ⊙ TELEPHONE PEDESTAL
 - ⊙ UTILITY POLE
 - OVERHEAD WIRES
 - (XX) RECORDED AS
TAX ID # EA42600001
JOB # 08-082TP

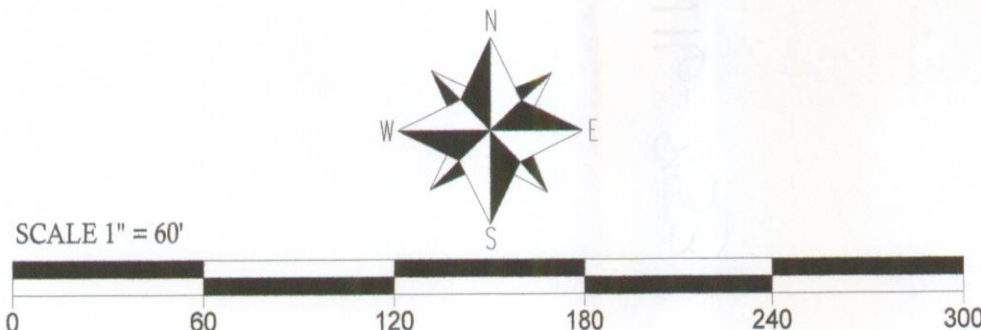

I have surveyed the above-described property and the above map is a true representation thereof and shows the size and location of the property, its exterior boundaries, the location and dimensions of all structures thereon, fences apparent easements and roadways and visible encroachments, if any.

This survey is made for the exclusive use of the present owners of the property, and also those who purchase, mortgage, or insure the title thereto within one (1) year from date hereof, and as to them I warrant the accuracy of said survey map.

NOTE: BEARINGS REFERENCED TO THE RECORD C.S.M.

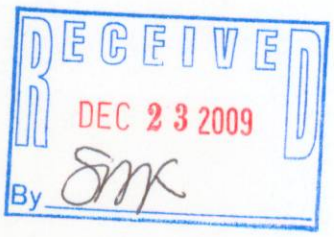

JOHN KROTT S-2258
Wisconsin Registered Land Surveyor
(original if signed in red)
DATED THIS 2nd DAY OF DECEMBER 2009.