

FARRIS, HANSEN & ASSOCIATES, INC.

ENGINEERING – ARCHITECTURE – SURVEYING
 7 RIDGWAY COURT – P.O. BOX 437 – ELKHORN, WISCONSIN 53121
 PHONE: (262) 723-2098 FAX: (262) 723-5886

PLAT OF SURVEY
 LOT 1 CERTIFIED SURVEY MAP NO. 4311
 RECORDED IN VOL. 27, PG. 343 WCR
 LOCATED IN THE S 1/2 SECTION 17
 TOWN 1 NORTH, RANGE 17 EAST
 WALWORTH COUNTY, WI.

EA396300001
 DALE J CZARNECKI
 JUNE A CZARNECKI
 W6774 BRICK CHURCH RD
 WALWORTH, WI 53184
 ZONING: A-1


EA396300002
 ROMAN M KAMIN TRUST
 MARY JEAN KAMIN TRUST
 53 N COWLEY ROAD
 RIVERSIDE, IL 60546
 ZONING: B-1

EA155300001
 LARRY W LAFOREST
 DORA ALCOZER-LAFOREST
 1120 REDWOOD COURT
 DELAVAN, WI 53115
 ZONING: A-1



E W 1700004
 CAROLYN ANNE RAMBOW
 W6441 BELOIT ROAD
 WALWORTH, WI 53184
 ZONING: A-1

E W 1700012
 MARILYN H HEDBERG TRUST
 1920 S. OCEAN BLVD
 MANALAPAN, FL 33462
 ZONING: A-1

E W 1700017
 STATE OF WISCONSIN
 DEPARTMENT OF TRANS.
 MADISON, WI 53700

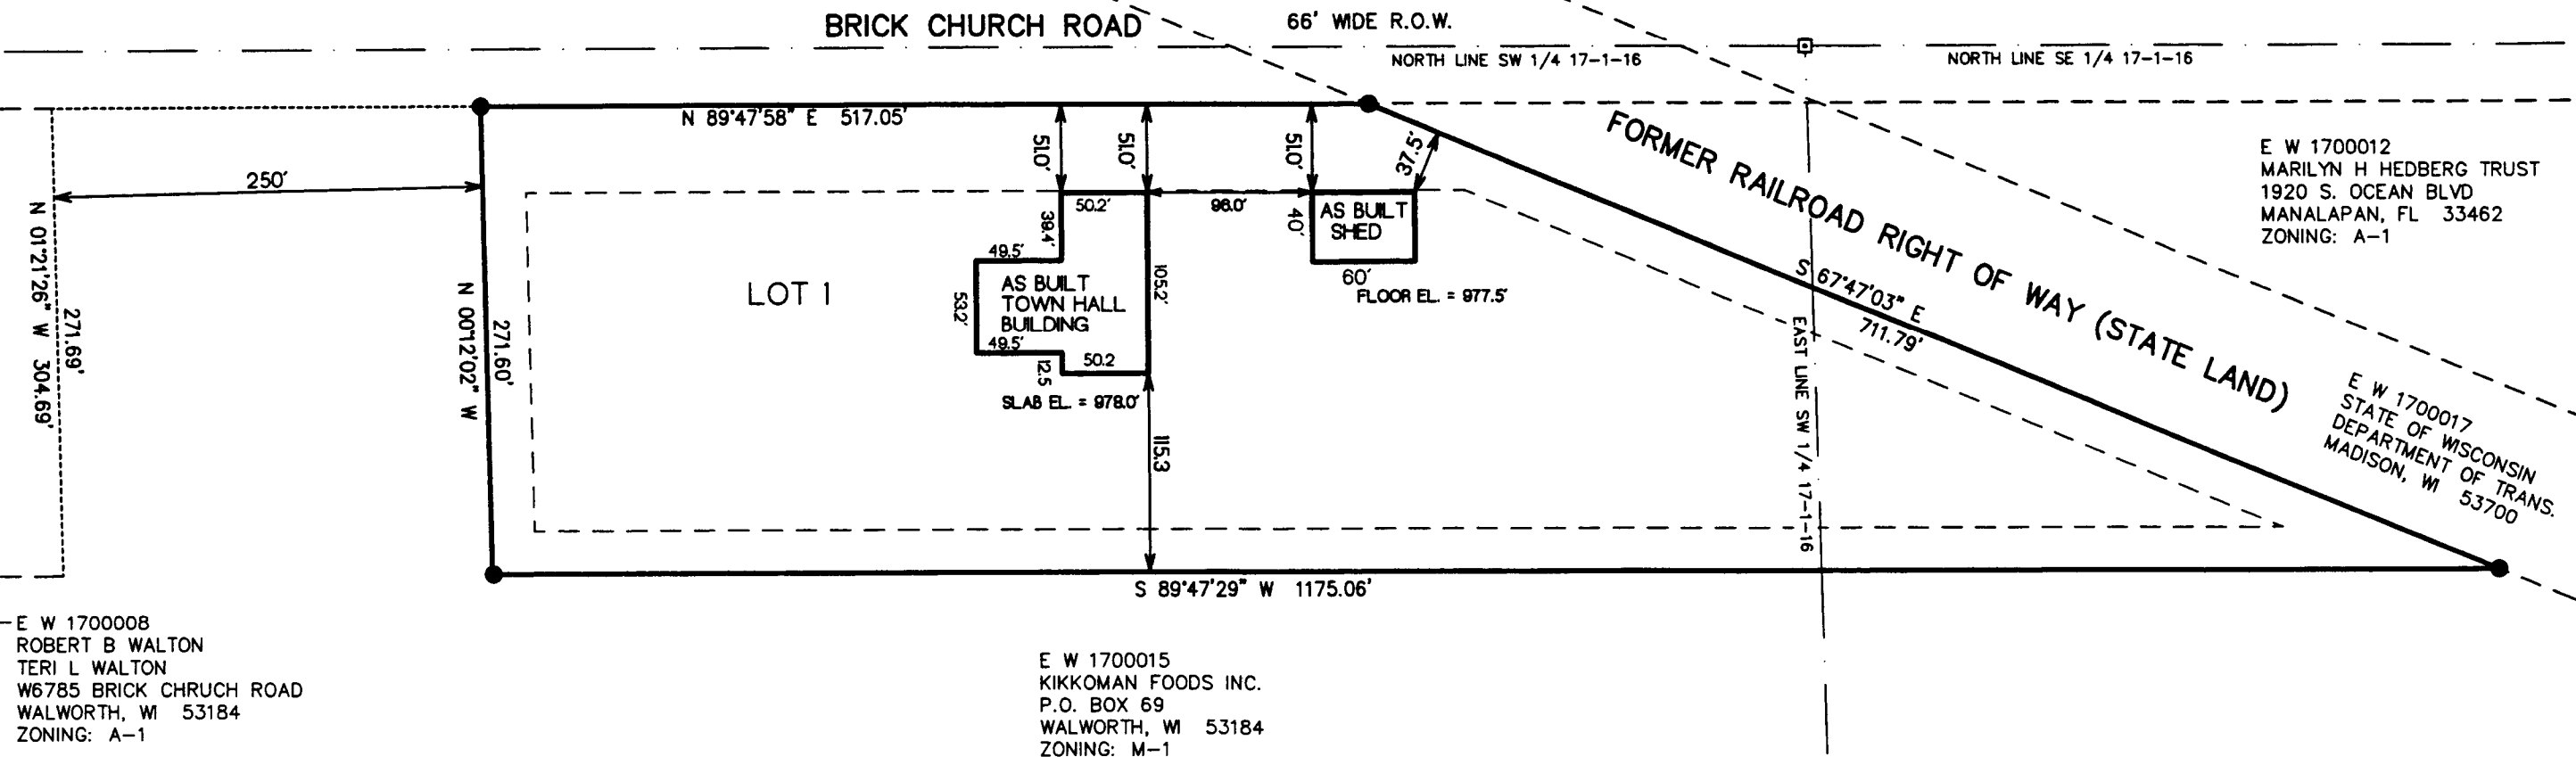**LEGEND**

- = FOUND IRON REBAR STAKE
- = FOUND CONCRETE COUNTY MONUMENT
- (XXX) = RECORDED AS

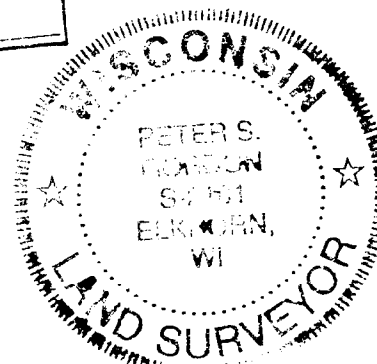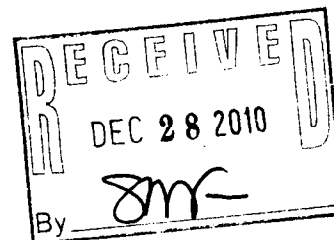

NOTE: COPIES OF THIS MAP TO WHICH THE FOLLOWING CERTIFICATE WILL APPLY SHOW SURVEYOR'S ORIGINAL SEAL AND SIGNATURE IN RED INK. COPIES BY ANY OTHER MEANS MAY HAVE ALTERATIONS WHICH DO NOT REPRESENT THE SURVEYOR'S WORK PRODUCT.

I HEREBY CERTIFY THAT THE ABOVE DESCRIBED PROPERTY HAS BEEN SURVEYED UNDER MY DIRECTION AND THAT THE ABOVE MAP IS A TRUE REPRESENTATION THEREOF AND SHOWS THE SIZE AND LOCATION OF THE PROPERTY AND ITS EXTERIOR BOUNDARIES. THIS SURVEY IS MADE FOR THE USE OF THE PRESENT OWNERS OF THE PROPERTY, AND ALSO THOSE WHO PURCHASE, MORTGAGE, OR GUARANTEE THE TITLE THERETO WITHIN ONE YEAR FROM THE DATE HEREOF.

DATED: APRIL 27, 2010
 TO SHOW PROPOSED BUILDINGS

[Signature]
 PETER S. GORDON R.L.S. 2101

REVISED 12-27-2010 TO SHOW
 SIZE & LOCATION OF AS BUILT
 BUILDINGS

PROJECT: 7904
 DATE: 04-16-2010
 SHEET 1 OF 1

