


BUILDING PERMIT PLAT

LOT 1 OF CSM 3732
REC. AS DOC. 616938
LOCATED IN THE NW 1/4 OF THE SE 1/4
SECTION 9, T1N, R16E
WALWORTH COUNTY, WI.

LINE	BEARING	DISTANCE
L1	N 44°58'58" E	126.87'
L2	N 19°46'03" E	137.80'
L3	S 80°01'45" E	123.70'
L4	N 04°42'12" E	153.84'
L5	N 65°20'22" E	85.21'
L6	N 36°07'51" E	126.63'
L7	N 58°20'41" E	122.39'

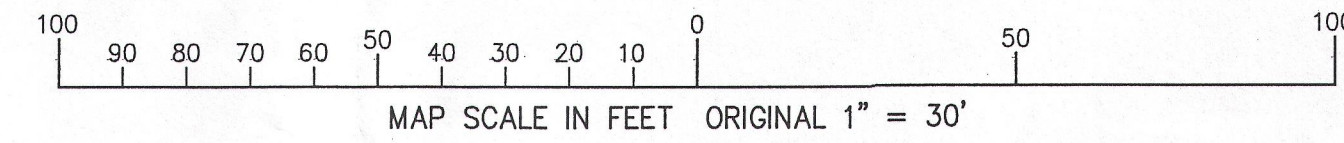

NOTE: COPIES OF THIS MAP TO WHICH THE FOLLOWING CERTIFICATE WILL APPLY SHOW SURVEYOR'S ORIGINAL SEAL AND SIGNATURE IN RED INK. COPIES BY ANY OTHER MEANS MAY HAVE ALTERATIONS WHICH DO NOT REPRESENT THE SURVEYOR'S WORK PRODUCT.



I HEREBY CERTIFY THAT THE ABOVE DESCRIBED PROPERTY HAS BEEN SURVEYED UNDER MY DIRECTION AND THAT THE ABOVE MAP IS A TRUE REPRESENTATION THEREOF AND SHOWS THE SIZE AND LOCATION OF THE PROPERTY AND ITS EXTERIOR BOUNDARIES. THIS SURVEY IS MADE FOR THE USE OF THE PRESENT OWNERS OF THE PROPERTY, AND ALSO THOSE WHO PURCHASE, MORTGAGE, OR GUARANTEE THE TITLE THERETO WITHIN ONE YEAR FROM THE DATE HEREOF.

DATED: AUGUST 31, 2008

REVISED 10-09-2008
TO SHOW AS BUILT IMPROVEMENTS

REVISED 07-19-2013
TO SHOW SIZE & LOCATION OF
PROPOSED GARAGE ADDITION

PETER S. GORDON R.L.S. 2101

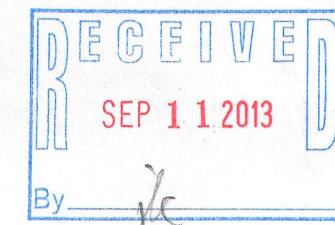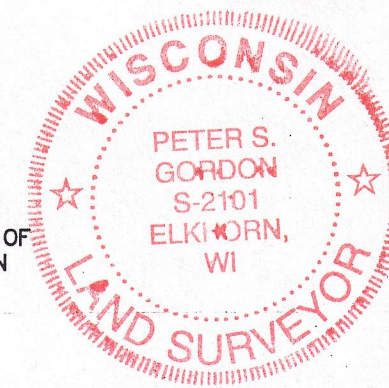

UNPLATTED LANDS
OWNED BY DIVIDER

EXISTING
BUILDING


LOT 1
219,360 S.F.
5.04 AC.

PRIVATE ROAD
50' CROSS INGRESS,
EGRESS, & UTILITIES
EASEMENT REC. AS
DOC. NO. 616939

EAST LINE OF THE
NW 1/4 OF THE SE 1/4
SEC. 9-1-16

SOUTH LINE OF THE
NW 1/4 OF THE SE 1/4
SEC. 9-1-16

BENCH MARK
NAIL IN 30" OAK
ELEV.=1016.85'

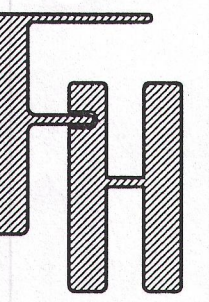

ORDERED BY: ROY HANSON
PO BOX 594
FONTANA, WI. 53125

FARRIS, HANSEN & ASSOCIATES, INC.
ENGINEERING - ARCHITECTURE - SURVEYING
7 RIDGWAY COURT P.O. BOX 437
ELKHORN, WISCONSIN 53121
OFFICE: (262) 723-2098 FAX: (262) 723-5886

REVISIONS
02/11/2005
ADD TREES

PROJECT NO.
5507

DATE
10-08-2004

SHEET NO.
1 OF 1

EA3732-1

116-928