

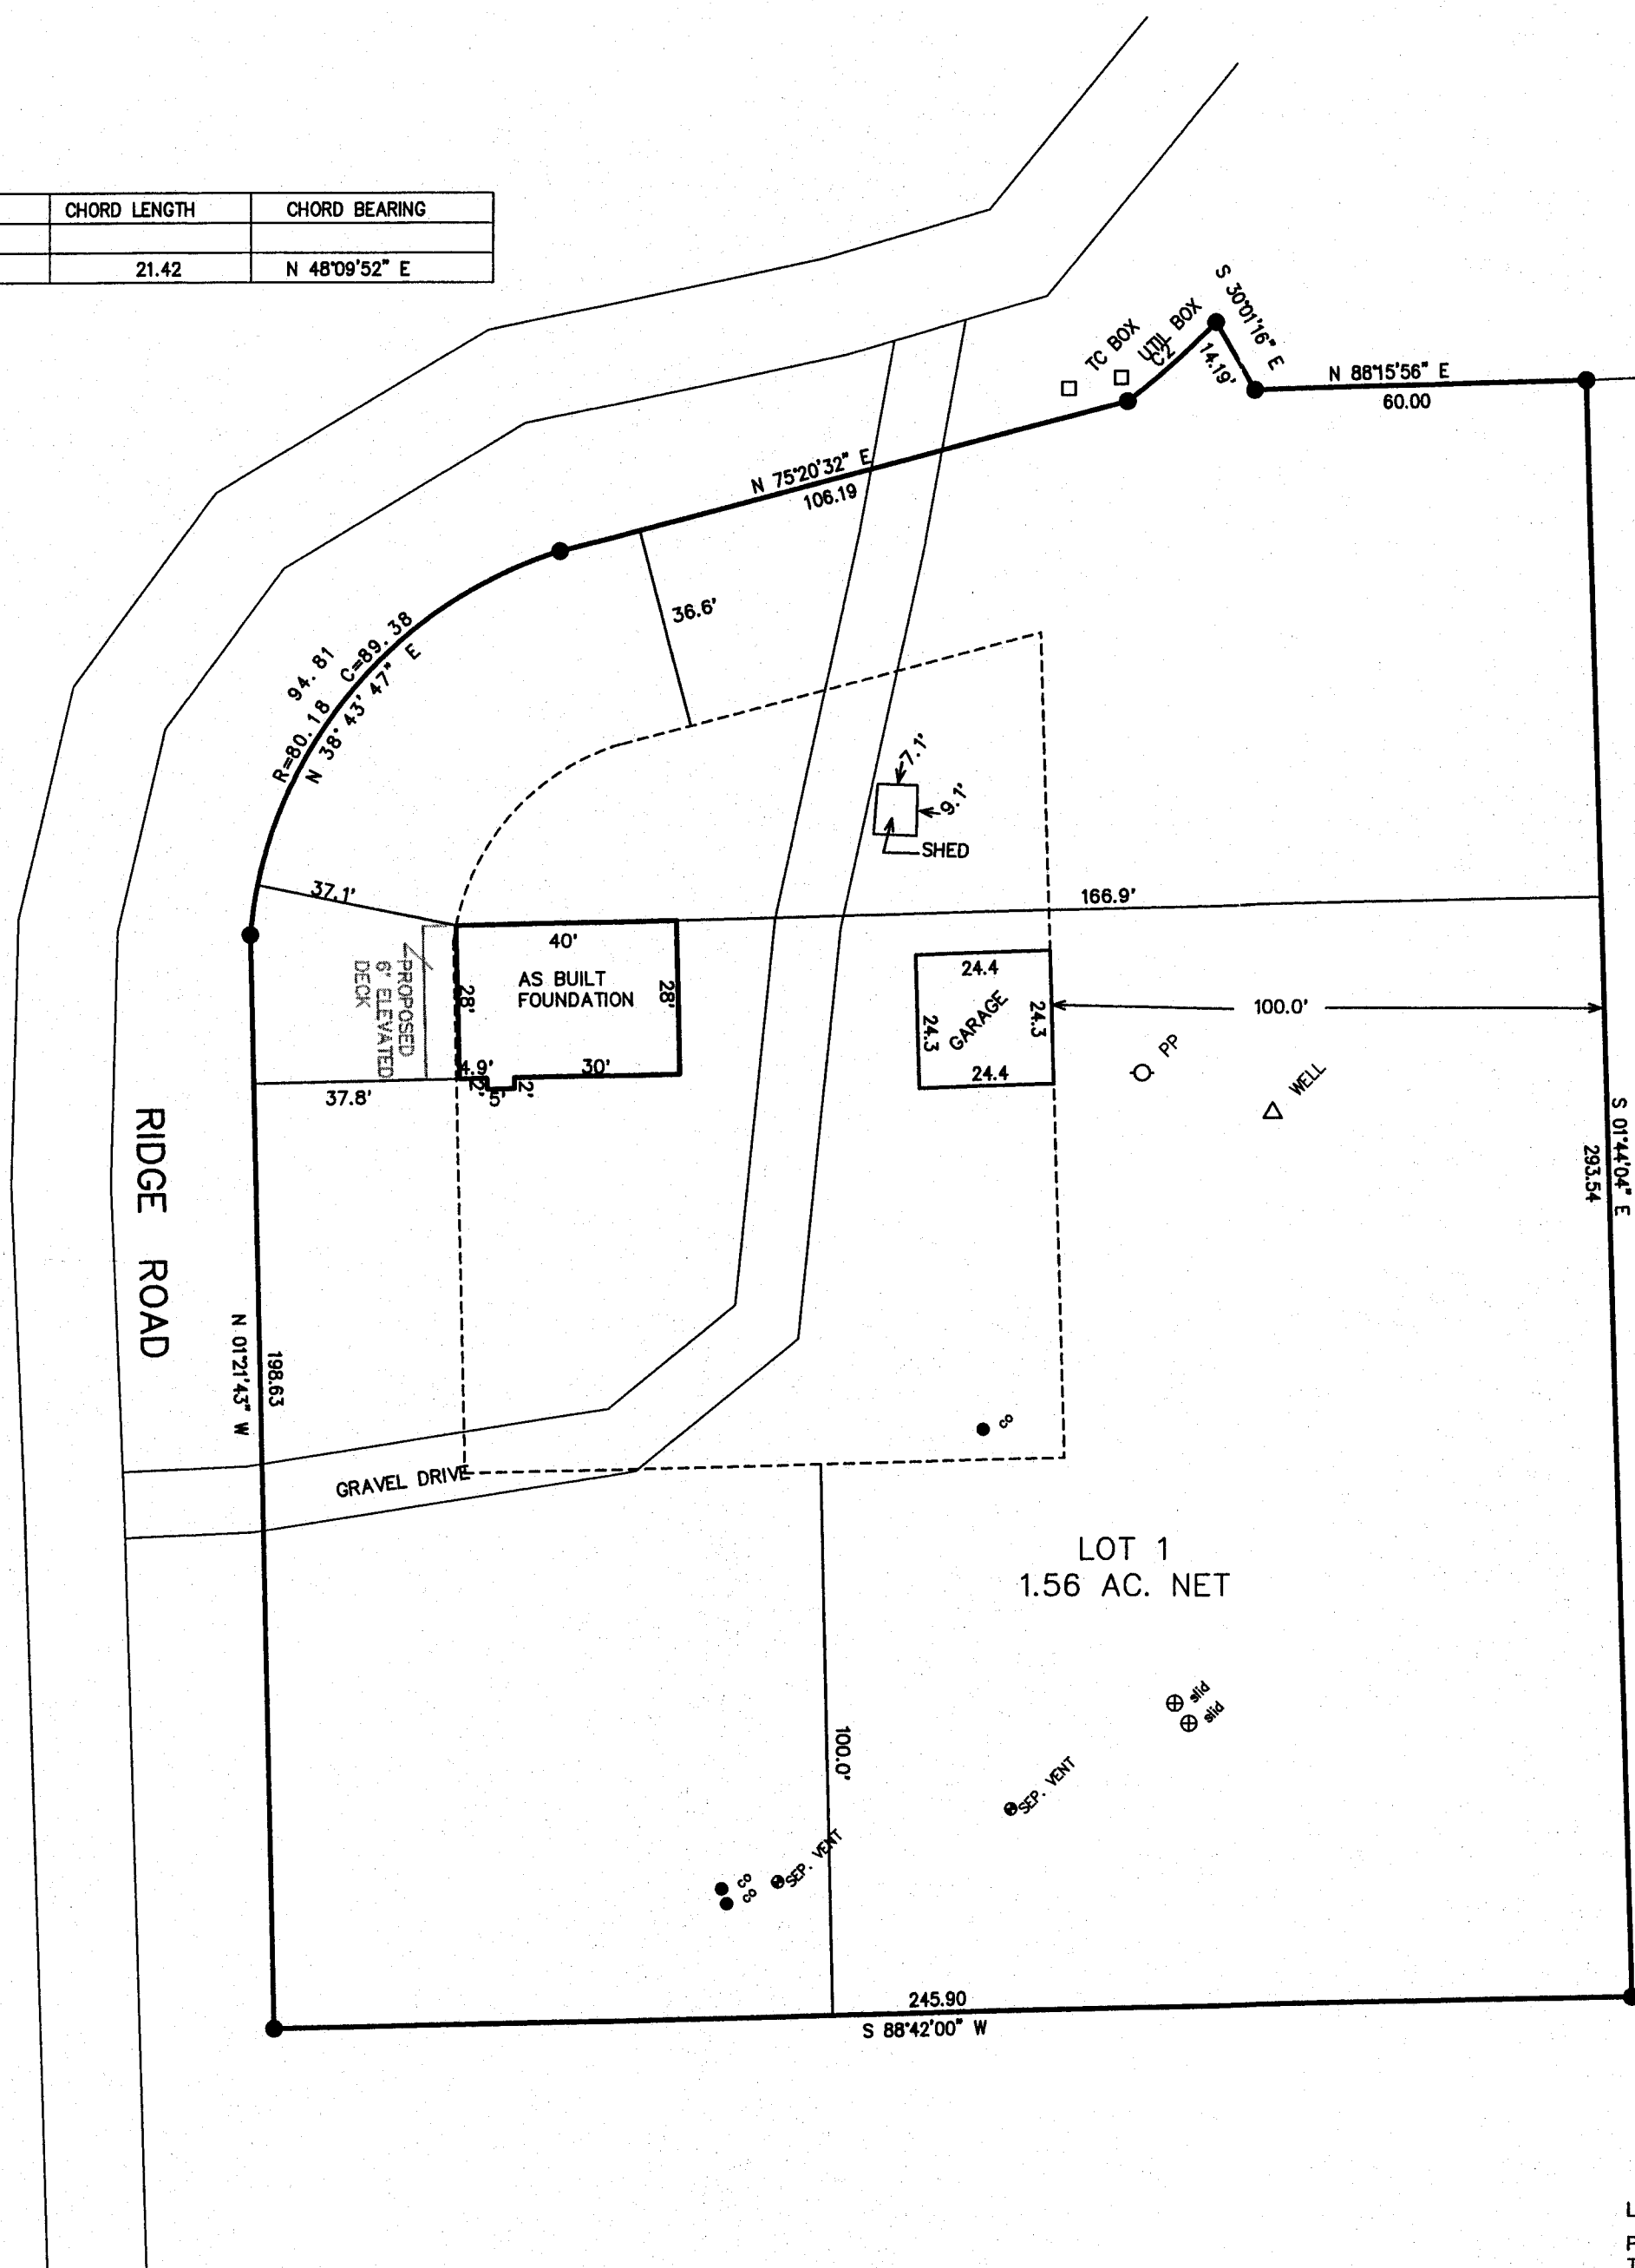


NOV 11 2013

| CURVE | ARC   | RADIUS | CHORD LENGTH | CHORD BEARING |
|-------|-------|--------|--------------|---------------|
| C2    | 21.44 | 144.10 | 21.42        | N 48°09'52" E |

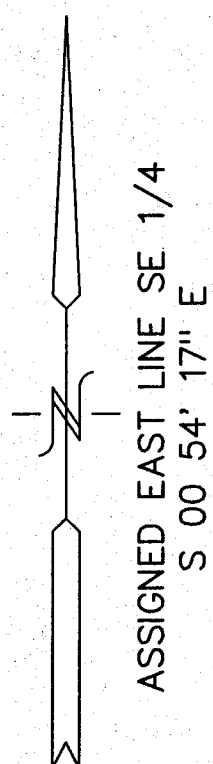

PLAT OF SURVEY  
LOT 1 CSM 4245  
PART OF THE NE 1/4 OF THE SE 1/4  
SECTION 34, TOWN 1 NORTH, RANGE 16 EAST  
WALWORTH COUNTY, WISCONSIN

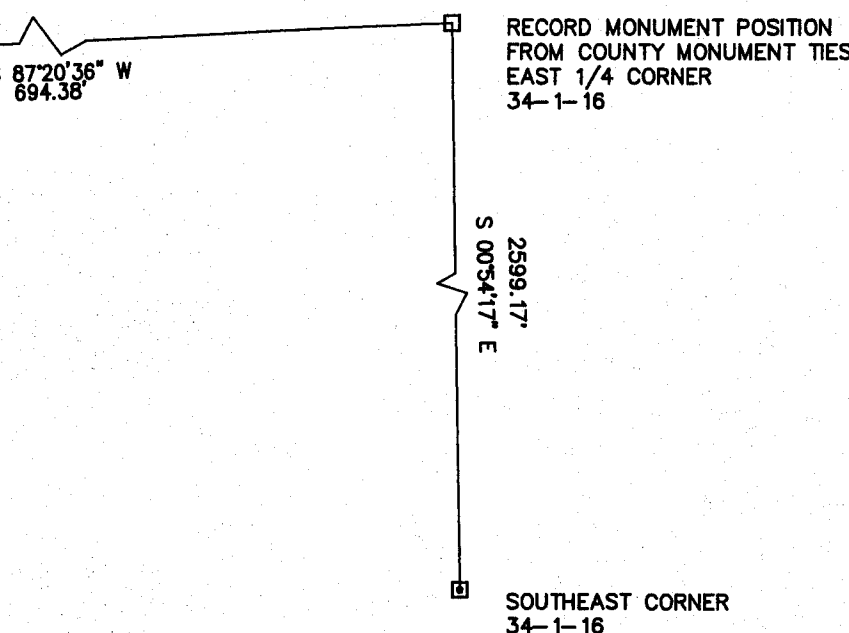

- = FOUND CONCRETE COUNTY MONUMENT
- = SET IRON REBAR STAKE
- = RECORD MONUMENT POSITION

NOTE: COPIES OF THIS MAP TO WHICH THE FOLLOWING CERTIFICATE WILL APPLY ARE BLUE LINE PRINTS SHOWING SURVEYOR'S ORIGINAL SEAL AND SIGNATURE IN BLACK INK. COPIES BY ANY OTHER MEANS MAY HAVE ALTERATIONS WHICH DO NOT REPRESENT THE SURVEYOR'S WORK PRODUCT.

I HEREBY CERTIFY THAT THE ABOVE DESCRIBED PROPERTY HAS BEEN SURVEYED UNDER MY DIRECTION AND THAT THE ABOVE MAP IS A TRUE REPRESENTATION THEREOF AND SHOWS THE SIZE AND LOCATION OF THE PROPERTY AND ITS EXTERIOR BOUNDARIES. THIS SURVEY IS MADE FOR THE USE OF THE PRESENT OWNERS OF THE PROPERTY, AND ALSO THOSE WHO PURCHASE, MORTGAGE, OR GUARANTEE THE TITLE THERETO WITHIN ONE YEAR FROM THE DATE HEREOF.

DATED: 08-03-2009

REVISED 08-29-2013  
TO SHOW BUILDABLE ENVELOPE


REVISED 09-11-2013  
TO SHOW PROPOSED RESIDENCE

REVISED 11-11-2013  
TO SHOW SIZE & LOCATION OF  
AS BUILT FOUNDATION

*Peter S. Gordon*  
PETER S. GORDON R.L.S. 2101

LEGAL DESCRIPTION

PART OF THE NORTHEAST 1/4 OF THE SOUTHEAST 1/4 AND PART OF SE 1/4 OF THE NE 1/4 OF SECTION 34, TOWN 1 NORTH, RANGE 16 EAST, WALWORTH COUNTY, WISCONSIN BEING LOT 1 OF CERTIFIED SURVEY MAP NO. 4245, RECORDED IN VOL. 27, ON PAGE 108 OF WALWORTH COUNTY CERTIFIED SURVEYS AS DOCUMENT NO. 770037

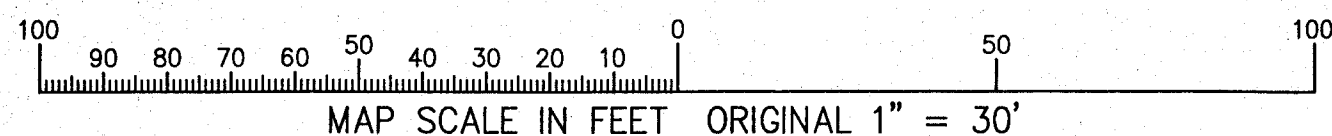

NOV 27 2013

*jfc*



WORK ORDERED BY:  
RICHARD RASMUSSEN  
113 KENOSHA STREET  
WALWORTH, WI. 53184

FARRIS, HANSEN & ASSOCIATES, INC.  
Engineering, Architecture, Surveying  
7 Ridgeway Court P.O. Box 437  
ELKHORN, WISCONSIN 53121  
Office: (414) 723-2098  
Fax: (414) 723-5866

REVISIONS

PROJECT NO.  
4752  
DATE  
5-21-97  
SHEET NO.  
1 OF 1

EA4245-1 116-932