


PREPARED FOR:  
 SUSAN L. DAWSON  
 MARKS, MARKS AND KAPLAN, LTD  
 120 NORTH LASALLE STREET  
 SUITE 3200  
 CHICAGO, ILLINOIS 60602-2401

# PLAT OF SURVEY



J.K. SURVEYING INC.  
 N3705 WILLOWBEND LANE  
 LAKE GENEVA, WI, 53147  
 262-248-3697

- OF -

LOT 17, THE BIRCHES FIRST ADDITION,  
 LOCATED IN T1N, R17E, W1ALWORTH  
 COUNTY, WISCONSIN.

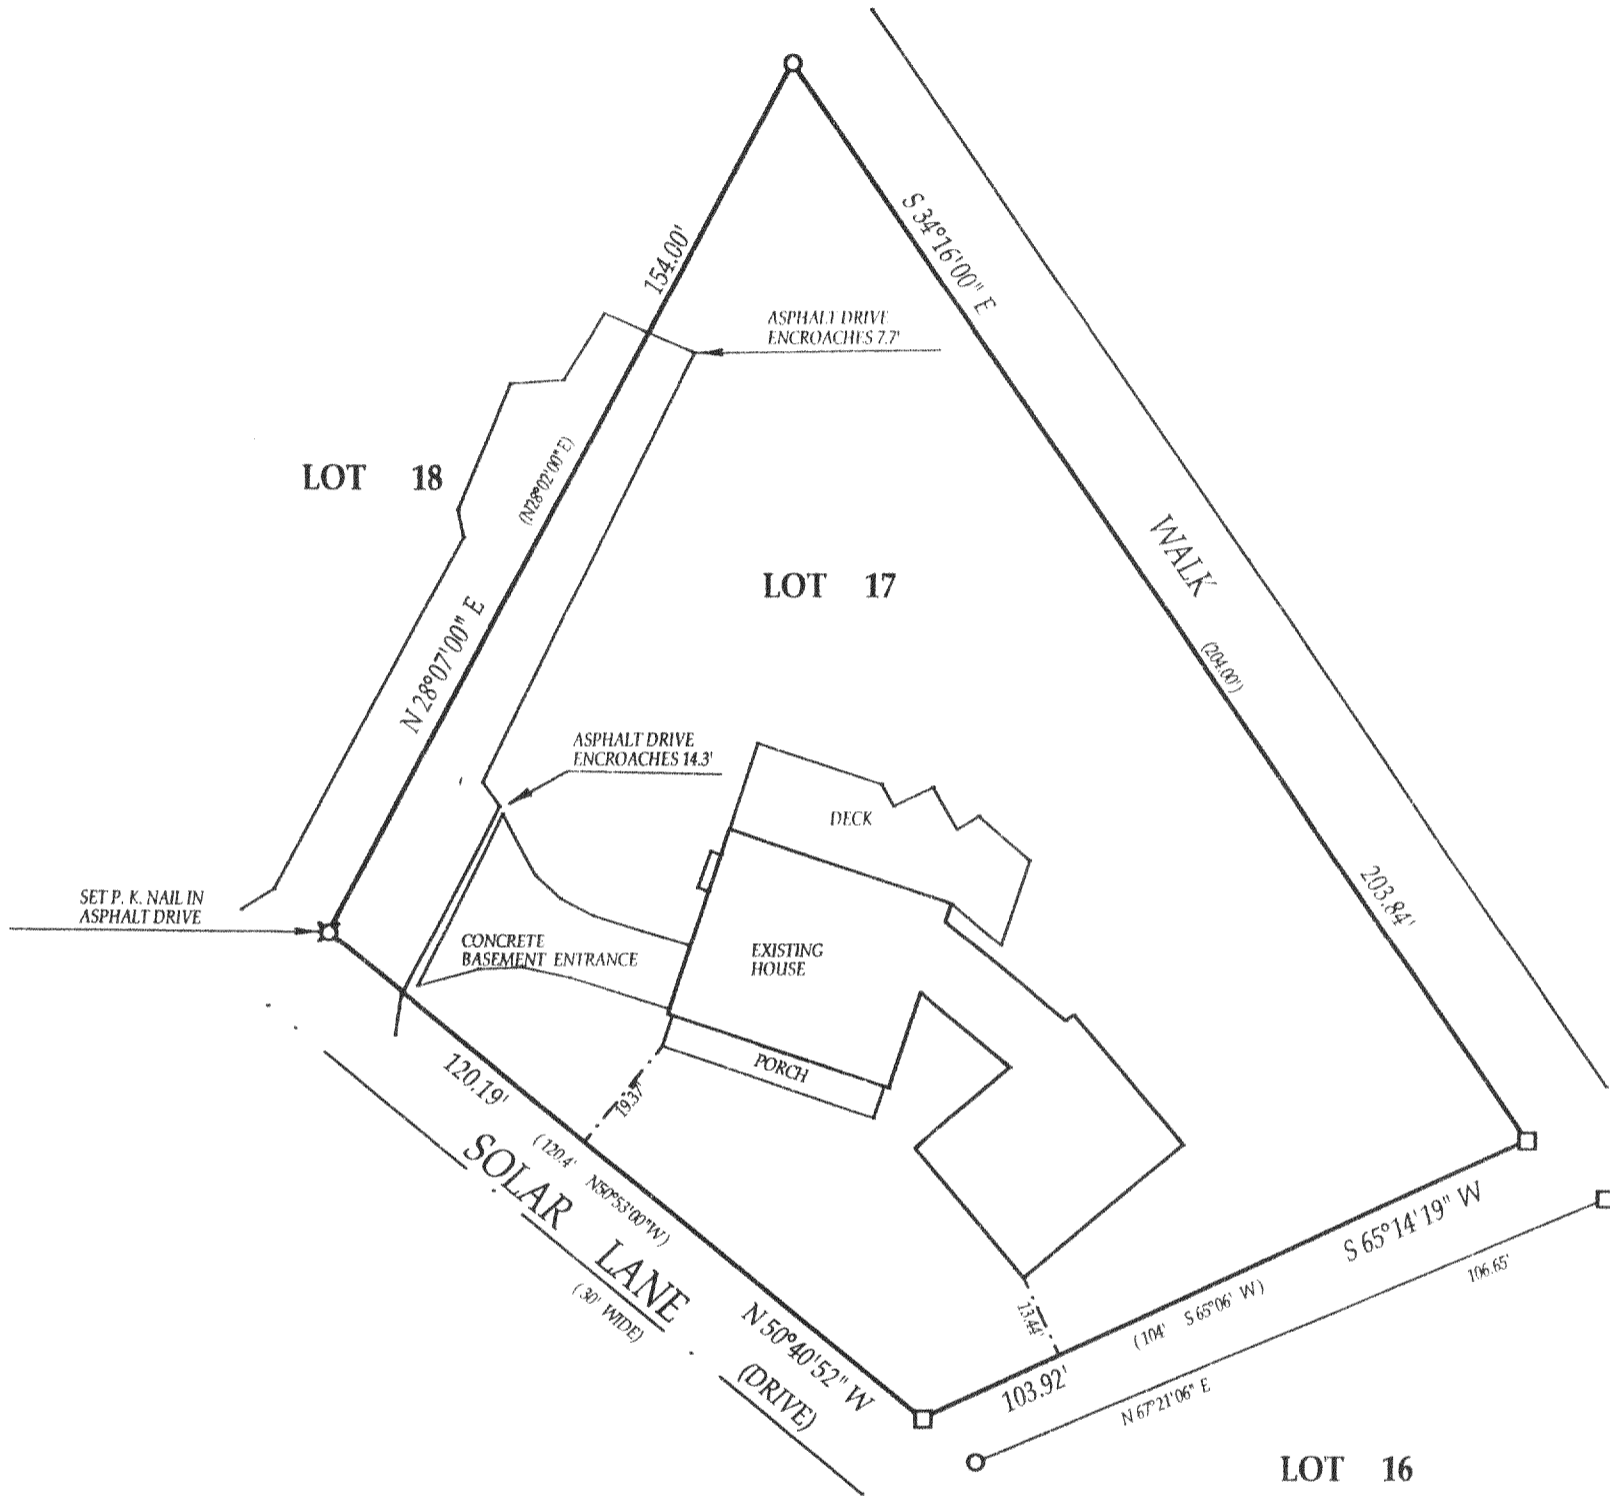

- ( ) = recorded as
- = found iron bar
- = found iron pipe
- = set iron pipe
- = set iron bar

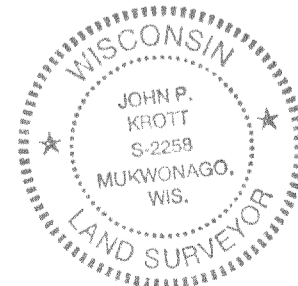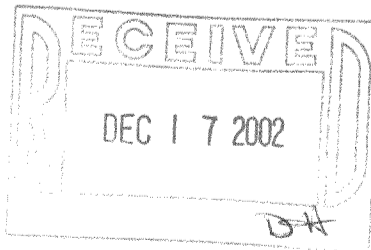

COMPARE LEGAL DESCRIPTION ABOVE AND DRAWING WITH DEED. FOR BUILDING RESTRICTIONS AND EASEMENTS NOT SHOWN REFER TO DEED, ABSTRACT SOURCES AND LOCAL MUNICIPAL CODES. NOTIFY THE SURVEYOR IMMEDIATELY OF ANY DISCREPANCY.

SCALE 1" = 30'

JOB #02-592

TAX ID #1BA1-11

"I hereby certify that I have surveyed the above described property and that the above map is a true representation thereof and shows the size and location of all visible structures, apparent easements and encroachments if any."  
 This survey is made for the present owners of the property, and those who purchase, mortgage, or guarantee the title thereto, within one year from the date hereof.

*John P. Krott*  
 JOHN KROTT S - 2258  
 Wisconsin Registered Land Surveyor  
 (original if signed in red)

DATED THIS 19 TH, DAY OF NOVEMBER 20 02 .

V-1BA1-11

117-2211